

Attachment E

Boundary Survey

EXCELSIOR SOLAR PROJECT

BOUNDARY SURVEY

GENERAL DRAWINGS

DWG. NO.	TITLE
SHEET 1	COVER SHEET / GENERAL NOTES
SHEET 2	INDEX OF DETAIL SHEETS
SHEET 3-17	DETAIL SHEETS

GENERAL NOTES


- CERTIFICATIONS SHALL RUN ONLY TO THE PERSON FOR WHOM THE SURVEY IS PREPARED, AND ON HIS BEHALF TO THE TITLE COMPANY, GOVERNMENTAL AGENCY AND LENDING INSTITUTION LISTED HEREON, AND TO THE ASSIGNEES OF THE LENDING INSTITUTION. CERTIFICATIONS ARE NOT TRANSFERABLE TO ADDITIONAL INSTITUTIONS OR SUBSEQUENT OWNERS.
- UNAUTHORIZED ALTERATION OR ADDITION TO A SURVEY MAP BEARING A LICENSED LAND SURVEYOR'S SEAL IS A VIOLATION OF SECTION 7209, SUBDIVISION 2, OF THE NEW YORK STATE EDUCATION LAW.
- COPIES FORM THE ORIGINAL OF THE SURVEY MAP NOT MARKED WITH AN ORIGINAL OF THE LAND SURVEYOR'S INKED SEAL OR HIS EMBOSSED SEAL SHALL NOT BE CONSIDERED TO BE A VALID TRUE COPY OF THE SURVEYOR'S ORIGINAL WORK AND OPINION.
- NO ABSTRACT OF TITLE WAS PROVIDED FOR REVIEW. THEREFORE THIS SURVEY IS SUBJECT TO ANY EASEMENTS OR ENCUMBRANCES THAT AN UPDATED ABSTRACT OF TITLE MAY SHOW.
- COORDINATES SHOWN HEREON WERE COMPUTED FROM THE NOTES OF AN INSTRUMENT SURVEY PERFORMED WITH AN ACCURACY GREATER THAN 1 IN 10,000.
- BEARING AND DISTANCES SHOWN HEREON ARE BASED ON NEW STATE PLANE COORDINATE SYSTEM, NAD1983(2011), NEW YORK WEST ZONE, US SURVEY FOOT. DISTANCES AND AREAS HAVE BEEN SCALED TO GROUND VALUES BY APPLYING A SCALE FACTOR OF 1.0000416. BEARINGS SHOWN HEREON ARE GRID NORTH.
- SUBSTANTIAL FEATURES SUCH AS HOUSES, OUTBUILDINGS, POWER OVERHEAD, ROADS, AND DRIVES WERE LOCATED USING PHOTOGRAMMETRIC MAPPING WITH EXCEPTION OF THOSE FEATURES SHOWN WITH A TIE DISTANCE TO THE RESPECTIVE PROPERTY LINES.
- NO PROPERTY CORNERS WERE STAKED AT THE TIME THE SURVEY FIELD WORK WAS COMPLETED.
- ALL COORDINATE NORTHING AND EASTINGS SHOWN HERE ON ARE GRID STATE PLANE COORDINATE SYSTEM, NAD1983(2011), NEW YORK WEST ZONE, US SURVEY FOOT.

MAP REFERENCES

- TOWN OF BYRON TAX ASSESSMENT MAP SECTION 4
- TOWN OF BYRON TAX ASSESSMENT MAP SECTION 5
- TOWN OF BYRON TAX ASSESSMENT MAP SECTION 6
- TOWN OF BYRON TAX ASSESSMENT MAP SECTION 7
- TOWN OF BYRON TAX ASSESSMENT MAP SECTION 8
- TOWN OF BYRON TAX ASSESSMENT MAP SECTION 9
- MAP PREPARED BY CLYFORD JAMES RIGERMAN, L.S.; ENTITLED "RE-SUBDIVISION OF LOT 1 OF THE NORTHRUP SUBDIVISION BEING PART OF LOTS 7 & 18, IN TOWNSHIP 1, PART OF THE 100,000 ACRE TRACT, TOWN OF BYRON, GENESSEE COUNTY, STATE OF NEW YORK, DATED 9-9-08
- MAP PREPARED BY CRAIG E. WELCH, L.S.; ENTITLED "MAP OF A SURVEY OF LAND TO BE CONVEYED BY THOMAS E. WELCH"; LAST DATED JUNE 5, 1985
- MAP PREPARED BY KEVIN M. O'DONOGHUE, L.S.; ENTITLED "MAP OF A SURVEY OF LAND BELONGING TO MERRILL D. MILLS"; DATED SEP. 3, 1992
- MAP PREPARED BY KEVIN M. O'DONOGHUE, L.S.; ENTITLED "MAP OF A SURVEY OF LAND BELONGING TO JOHN W. & KAREN LEATON"; DATED MARCH 15, 1999
- MAP PREPARED BY KEVIN M. O'DONOGHUE, L.S.; ENTITLED "ZUBER FARMS TOWER HILL ROAD LAND SEPERATION"; DATED JUNE 9, 2014
- MAP PREPARED BY MCINTOSH & MCINTOSH, P.C.; ENTITLED "SURVEY OF PART OF LOTS 49 & 61, 100,000 AC. TRACT & PART OF LOT 2, SEC. 1, TWP-13, R-1, HOLLAND PURCHASE; LAST DATED JUNE 30, 1996
- MAP PREPARED BY KEVIN M. O'DONOGHUE, L.S.; ENTITLED "MAP OF A SURVEY OF LAND TO BE CONVEYED TO TOWN OF BYRON"; LAST DATED AUG. 16, 1993
- MAP PREPARED BY KEVIN M. O'DONOGHUE, L.S.; ENTITLED "OXBO TO GLAZIER LAND SEPERATION & PARCEL MERGE"; DATED JANUARY 2, 2018
- MAP PREPARED BY KEVIN M. O'DONOGHUE, L.S.; ENTITLED "MAP OF A SURVEY OF LAND BELONGING TO WAYNE C. & ROBIN I. METZLER"; LAST DATED FEBRUARY 20, 1998
- MAP PREPARED BY GREGORY W. TOWNSEND, L.S.; ENTITLED "BOUNDARY SURVEY SHOWING THE SEPERATION OF LANDS OF GIVENDOLEN G. SHEPARD"; DATED 05/07/2019
- MAP PREPARED BY KEVIN M. O'DONOGHUE, L.S.; ENTITLED "CY PROPERTIES, LLC - GILLETT ROAD LAND SEPERATION"; DATED NOVEMBER 7, 2012
- MAP PREPARED BY KEVIN M. O'DONOGHUE, L.S.; ENTITLED "MAP OF A SURVEY OF LAND BELONGING TO KAY L. CARUSO"; DATED JULY 8, 1994
- MAP PREPARED BY THOMAS F. DUTTON, L.S.; ENTITLED "MAP OF A SURVEY OF LAND TO BE CONVEYED BY ELWOOD L. & CLARA H. SAY"; DATED JANUARY 10, 1985
- MAP PREPARED BY GREGORY W. TOWNSEND, L.S.; ENTITLED "BOUNDARY SURVEY SHOWING THE SEPERATION OF LANDS OF MICHELLE RINDELL"; DATED 09/14/05
- MAP PREPARED BY DAVID S. LAMENDOLA, L.S.; ENTITLED "BOUNDARY SURVEY SHOWING THE PARCEL TO BE CONVEYED"; LAST DATED 6-21-90
- MAP PREPARED BY KEVIN M. O'DONOGHUE, L.S.; ENTITLED "MAP OF A SURVEY OF LAND TO BE CONVEYED TO JAMES & JANET KEMPIE"; DATED JUNE 19, 1992
- MAP PREPARED BY DOUGLAS A. MCINTOSH, JR., L.S.; ENTITLED "SURVEY OF PART OF LOT-6, TWP-1, 100,000 ACRE TRACT"; DATED OCTOBER 13, 1993
- MAP PREPARED BY DAVID S. LAMENDOLA, L.S.; ENTITLED "BOUNDARY SURVEY SHOWING THE PARCEL TO BE CONVEYED"; DATED NOV. 28 - 1989
- MAP PREPARED BY KEVIN M. O'DONOGHUE, L.S.; ENTITLED "MAP OF A SURVEY OF LAND BELONGING TO JOSEPH A. & JUDITH E. CAPURSO"; LAST DATED JULY 22, 1999
- MAP PREPARED BY GREGORY W. TOWNSEND, L.S.; ENTITLED "BOUNDARY SURVEY SHOWING THE PARCEL TO BE CONVEYED"; DATED 07/31/07
- CONRAIL RIGHT OF WAY MAP FORMERLY THE NEW YORK CENTRAL RAILROAD COMPANY CHICAGO LINE; MAP V-79/02, DATED 07-29-1991
- CONRAIL RIGHT OF WAY MAP FORMERLY THE NEW YORK CENTRAL RAILROAD COMPANY CHICAGO LINE; MAP V-79/23, DATED 07-25-1991
- POWER AUTHORITY OF THE STATE OF NEW YORK NIAGARA-POWER PROJECT, GENESSEE COUNTY NIAGARA-ADIRONDACK TIE LINE; MAP NO. G8Y 289, PARCEL NO. 290, LAST DATED JULY 6, 1959
- POWER AUTHORITY OF THE STATE OF NEW YORK NIAGARA-POWER PROJECT, GENESSEE COUNTY NIAGARA-ADIRONDACK TIE LINE; MAP NO. G8Y 291, PARCEL NO. 292, LAST DATED JULY 6, 1959
- POWER AUTHORITY OF THE STATE OF NEW YORK NIAGARA-POWER PROJECT, GENESSEE COUNTY NIAGARA-ADIRONDACK TIE LINE; MAP NO. G8Y 292, PARCEL NO. 293, LAST DATED JULY 6, 1959
- POWER AUTHORITY OF THE STATE OF NEW YORK NIAGARA-POWER PROJECT, GENESSEE COUNTY NIAGARA-ADIRONDACK TIE LINE; MAP NO. G8Y 285, PARCEL NO. 286, LAST DATED JULY 6, 1959
- MAP AND PROFILE OF THE ALTERATION AND CHANGE OF THE ROUTE OF THE ROAD OF NEW YORK WEST SHORE AND BUFFALO RY. CO. IN THE TOWNS OF BERGEN, BYRON, ELBA, OAKFIELD AND ALABAMA-ALSO ACROSS THE TONAWANDA INDIAN RESERVATION, BOX #23, FILED: MARCH 25, 1882
- NEW YORK STATE ROUTE 237 MAPPING FOUND IN THE GENESSEE COUNTY CLERK'S OFFICE IN PIDGEON HOLE 5-6
- NEW YORK STATE ROUTE 237 MAPPING FOUND IN THE GENESSEE COUNTY CLERK'S OFFICE IN PIDGEON HOLE 6-1
- NEW YORK STATE ROUTE 262 MAPPING FOUND IN THE GENESSEE COUNTY CLERK'S OFFICE IN PIDGEON HOLE 4-5
- MAP PREPARED BY THOMAS F. DUTTON, L.S.; ENTITLED "MAP OF A SURVEY OF LAND TO BE CONVEYED BY JEROME K. & MARION V. GREENE; LAST DATED JULY 27, 1994

VICINITY MAP

GENESSEE COUNTY, NEW YORK

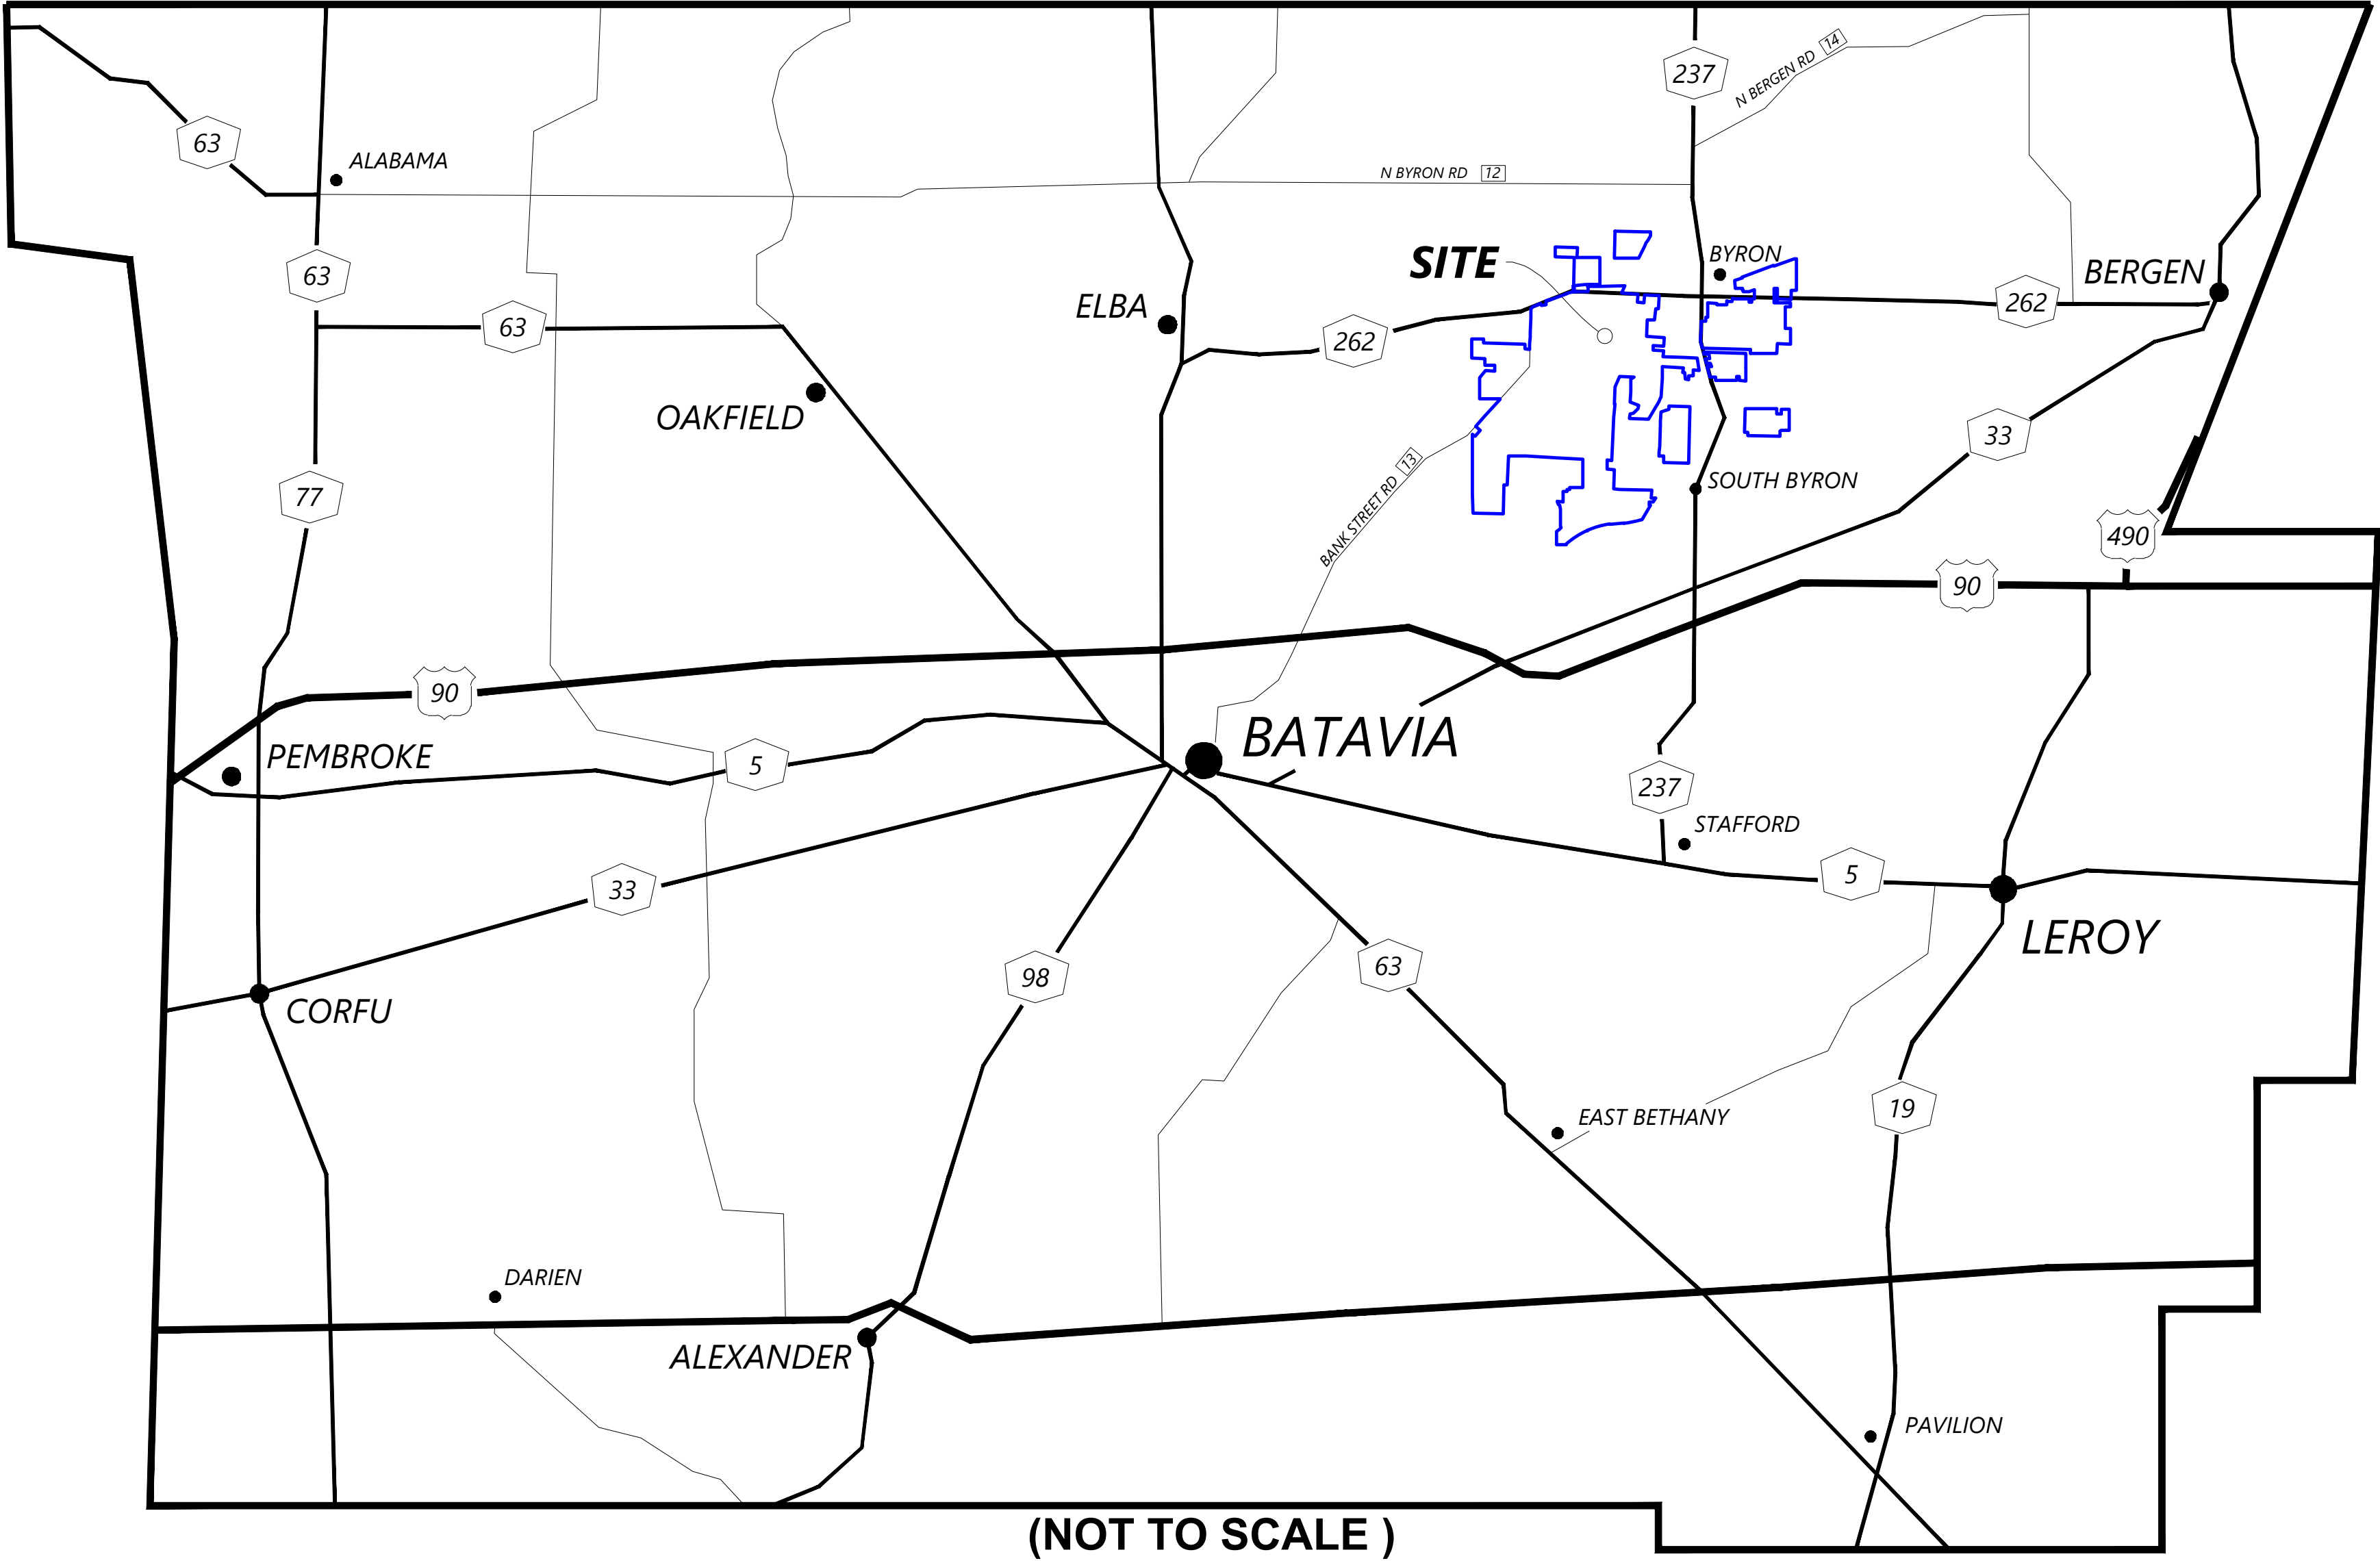

CERTIFICATION

I, CERTIFY TO NEXTERA ENERGY RESOURCES, LLC THAT THIS MAP WAS PREPARED ON 11/17/2020 FROM THE NOTES AND REFERENCES LISTED HEREON, AND FROM COMPUTATIONS BASED ON A FIELD SURVEY COMPLETED UNDER MY DIRECTION ON 22 OCTOBER, 2020.

DRAFT

STEPHEN M. BLY
N.Y.S.P.L.S. NO. 050231

Westwood
Surveying & Engineering
Phone (952) 937-5150 12701 Whitewater Drive, Suite #300
Fax (952) 937-5852 Minneapolis, MN 55441
Toll Free (888) 937-5150 www.pc.com
Westwood Surveying and Engineering, P.C.

PREPARED FOR:



PO Box 88808
North Palm Beach, FL 33408

REVISIONS:

#	DATE	COMMENT

EXCELSIOR
SOLAR PROJECT
GENESSEE COUNTY, NEW YORK

RECORD OF SURVEY

DATE: 11/03/2020

SHEET: 01 of 18



INDEX SHEET

PREPARED FOR:



PO Box 88808
North Palm Beach, FL 33408

REVISIONS:		
#	DATE	COMMENT
1		
2		
3		
4		
5		
6		

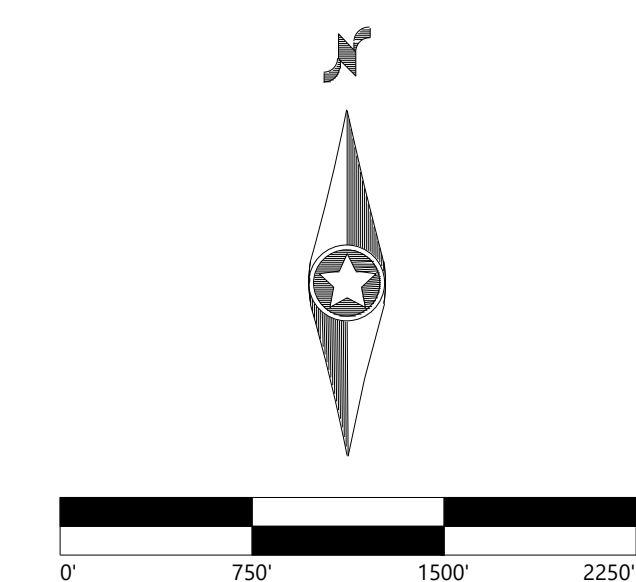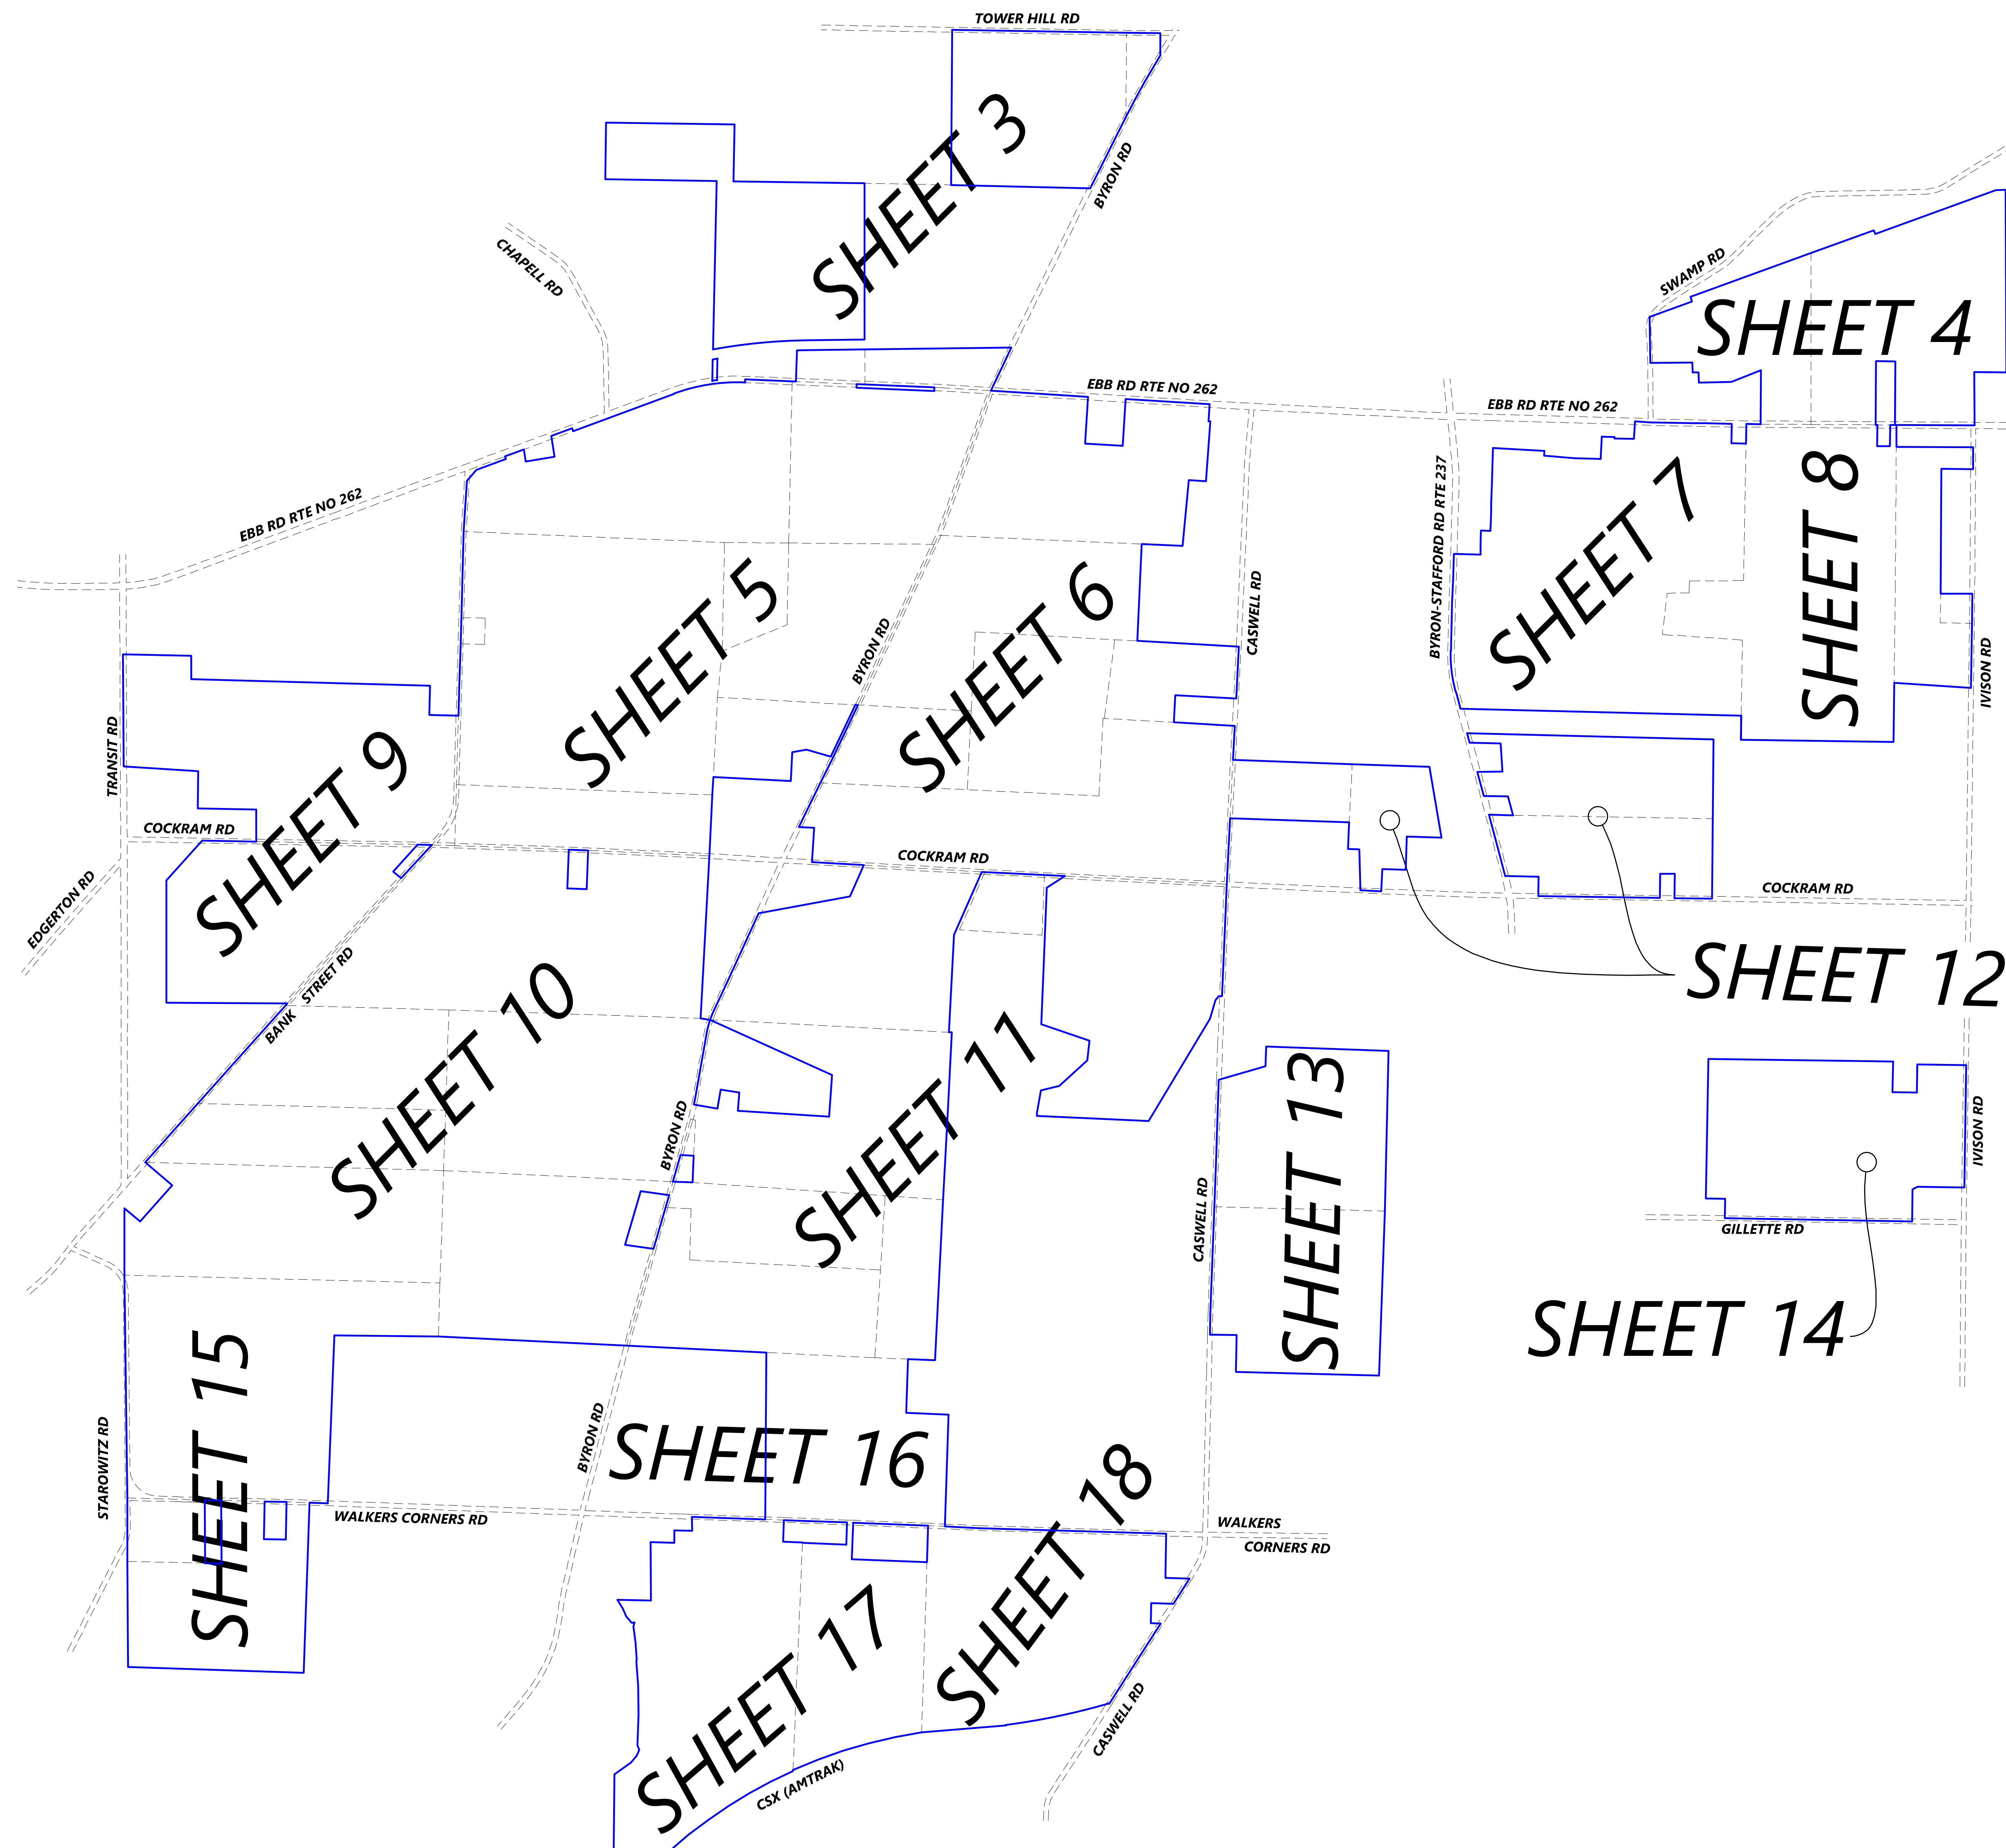

**EXCELSIOR
SOLAR PROJECT**
GENESEE COUNTY, NEW YORK

RECORD OF SURVEY

DATE: 11/03/2020

SHEET: 02 of 18

PREPARED FOR:




PO Box 88808
North Palm Beach, FL 33408

REVISIONS:		
#	DATE	COMMENT

LEGEND:

- GUY WIRE
- POWER POLE
- HYDRANT
- SIGN
- WATER EDGE
- POWER OVERHEAD
- FENCE LINE
- BOUNDARY LINE
- PARCEL LINE
- ADJACENT PARCEL LINES
- APPROXIMATE LOCATION OF PARCEL LINES FROM TAX MAP
- EASEMENT LINES
- EXCEPTION TO PROJECT
- DRIVE
- ROAD
- WATER
- VEGETATION
- FOUND MONUMENT (SEE LABEL)
- N/F NOW OR FORMERLY
- COR CORNER
- IP IRON PIPE
- IB IRON BAR
- RB REBAR

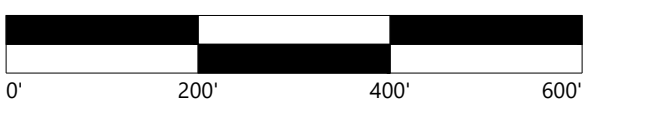


BEARING AND DISTANCES SHOWN HEREON ARE BASED ON NEW STATE PLANE COORDINATE SYSTEM, NAD1983(2011), NEW YORK WEST ZONE, US SURVEY FOOT. DISTANCES AND AREAS HAVE BEEN SCALED TO GROUND VALUES BY APPLYING A SCALE FACTOR OF 1.0000416. BEARINGS SHOWN HEREON ARE GRID NORTH.

EXCELSIOR
SOLAR PROJECT
GENESEE COUNTY, NEW YORK


RECORD OF SURVEY

DATE: 11/03/2020

SHEET: 03 of 18


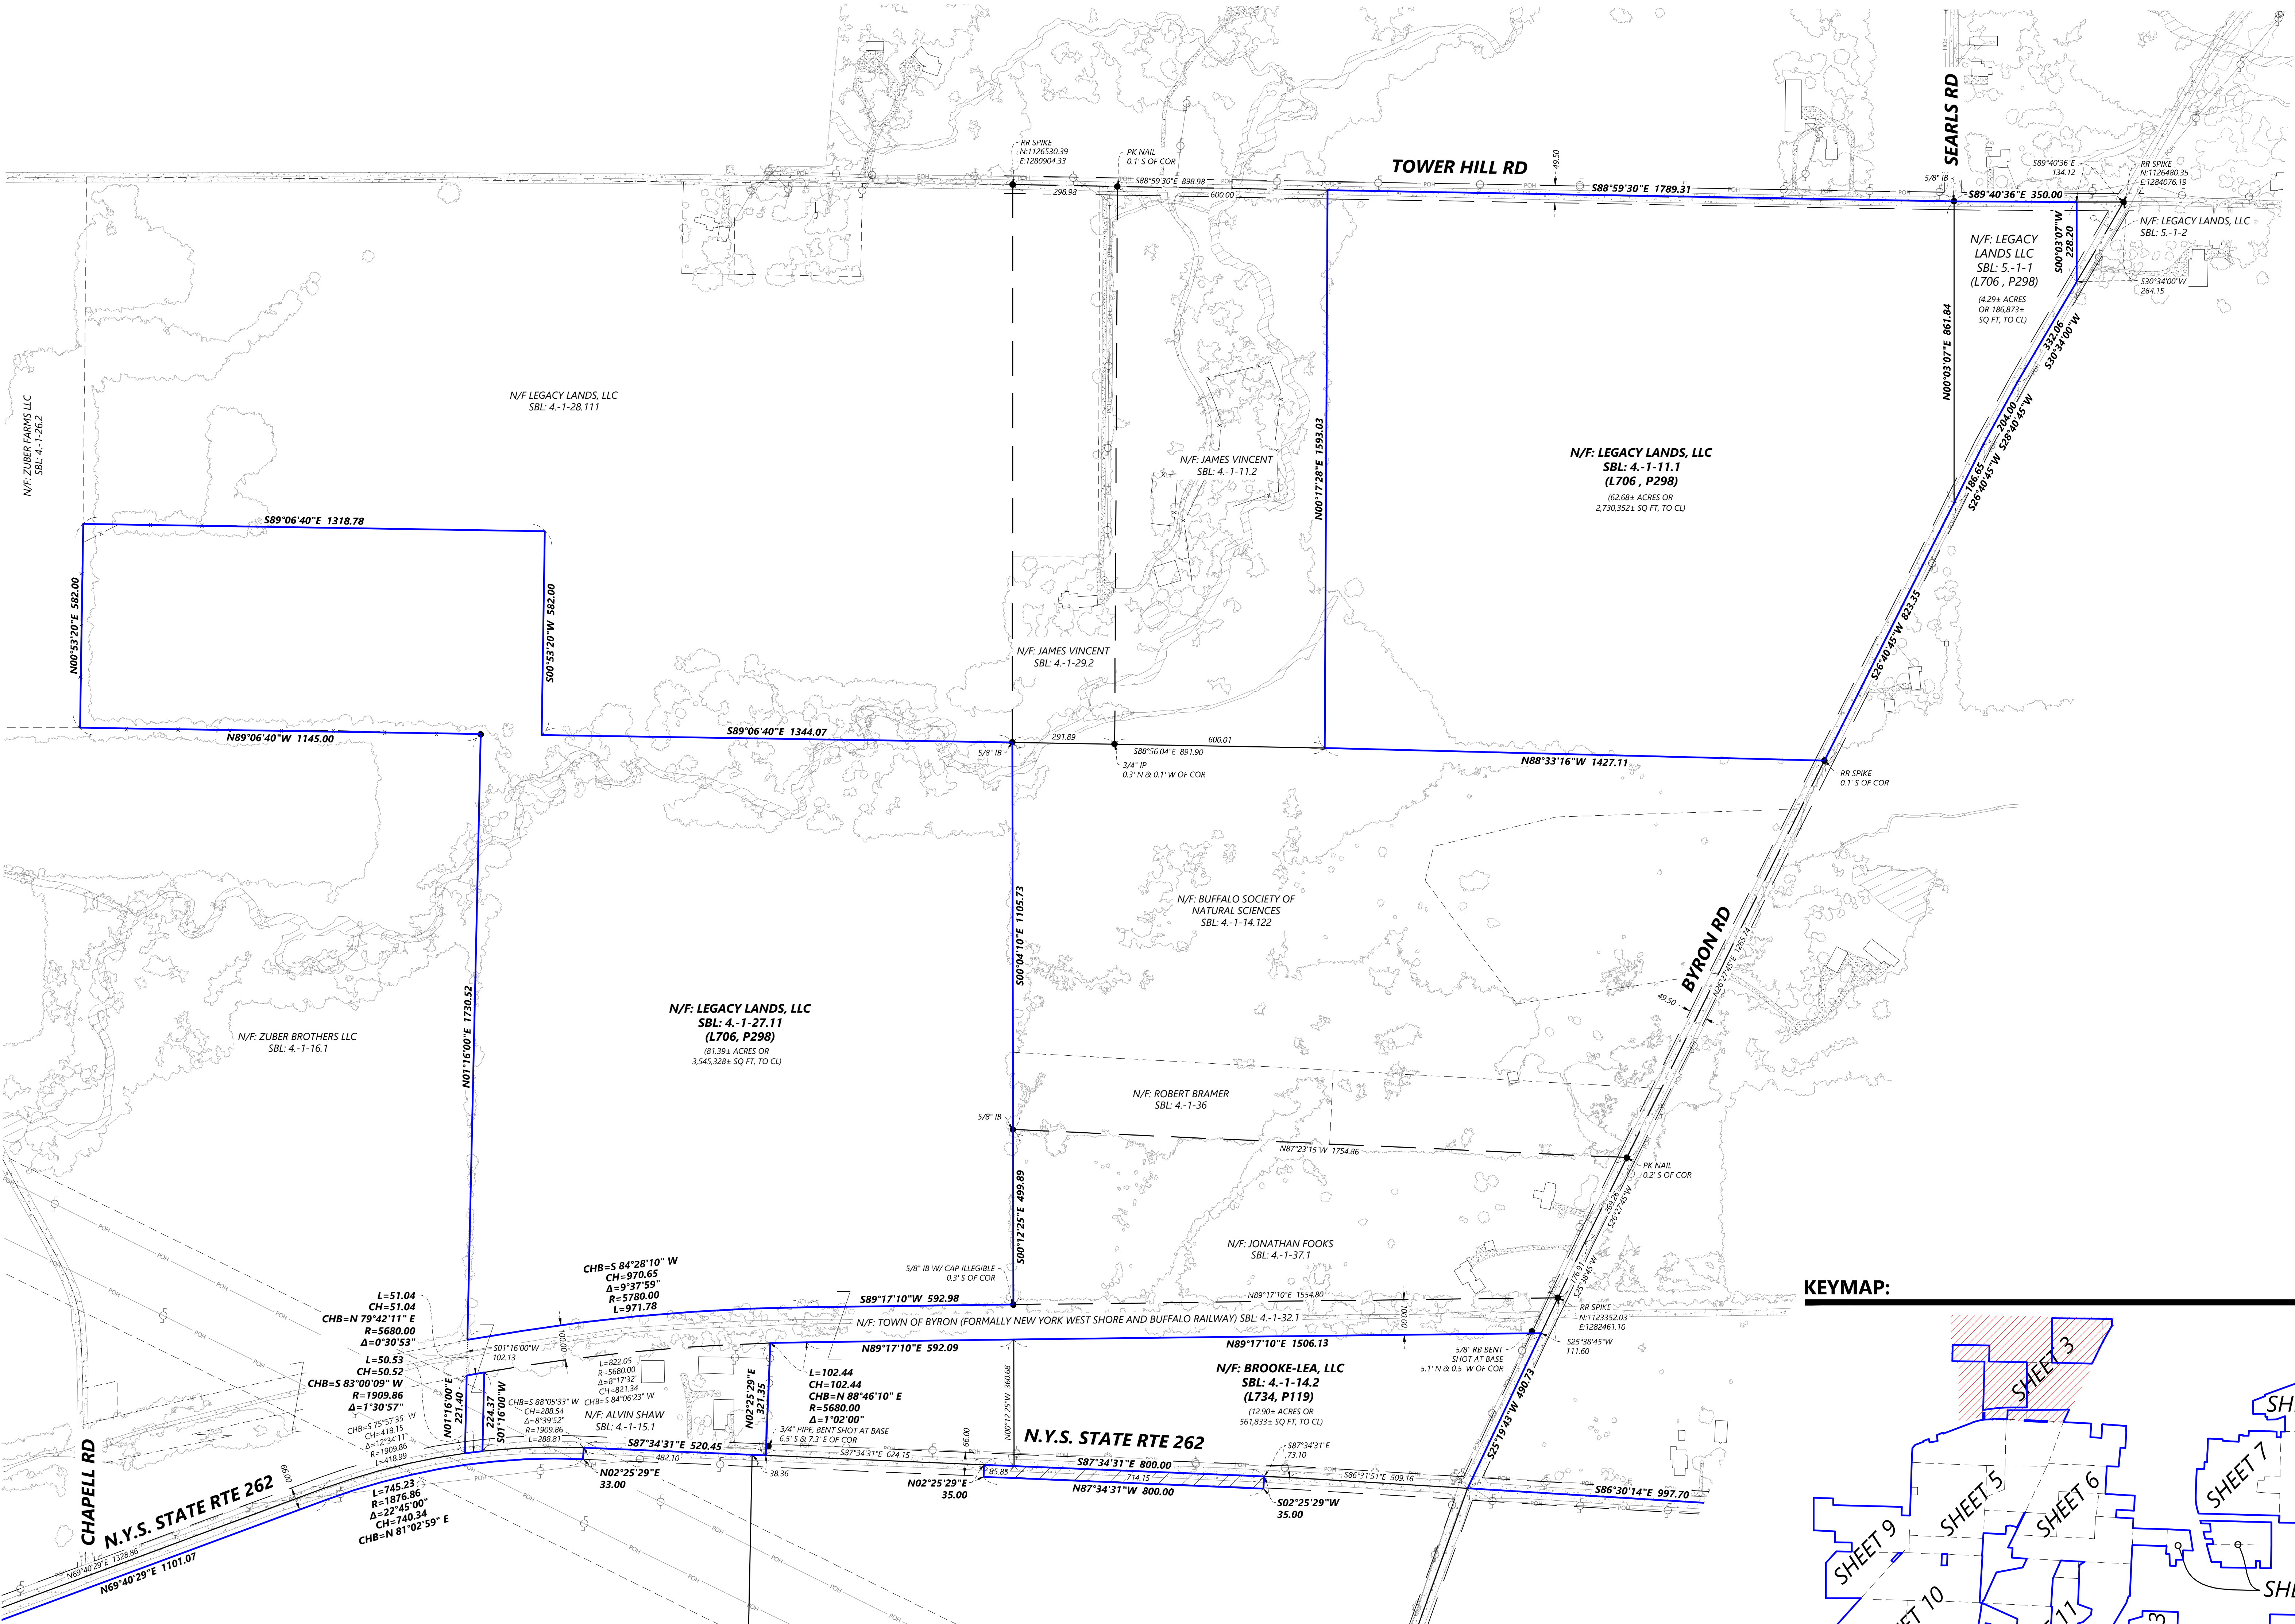


KEYMAP:

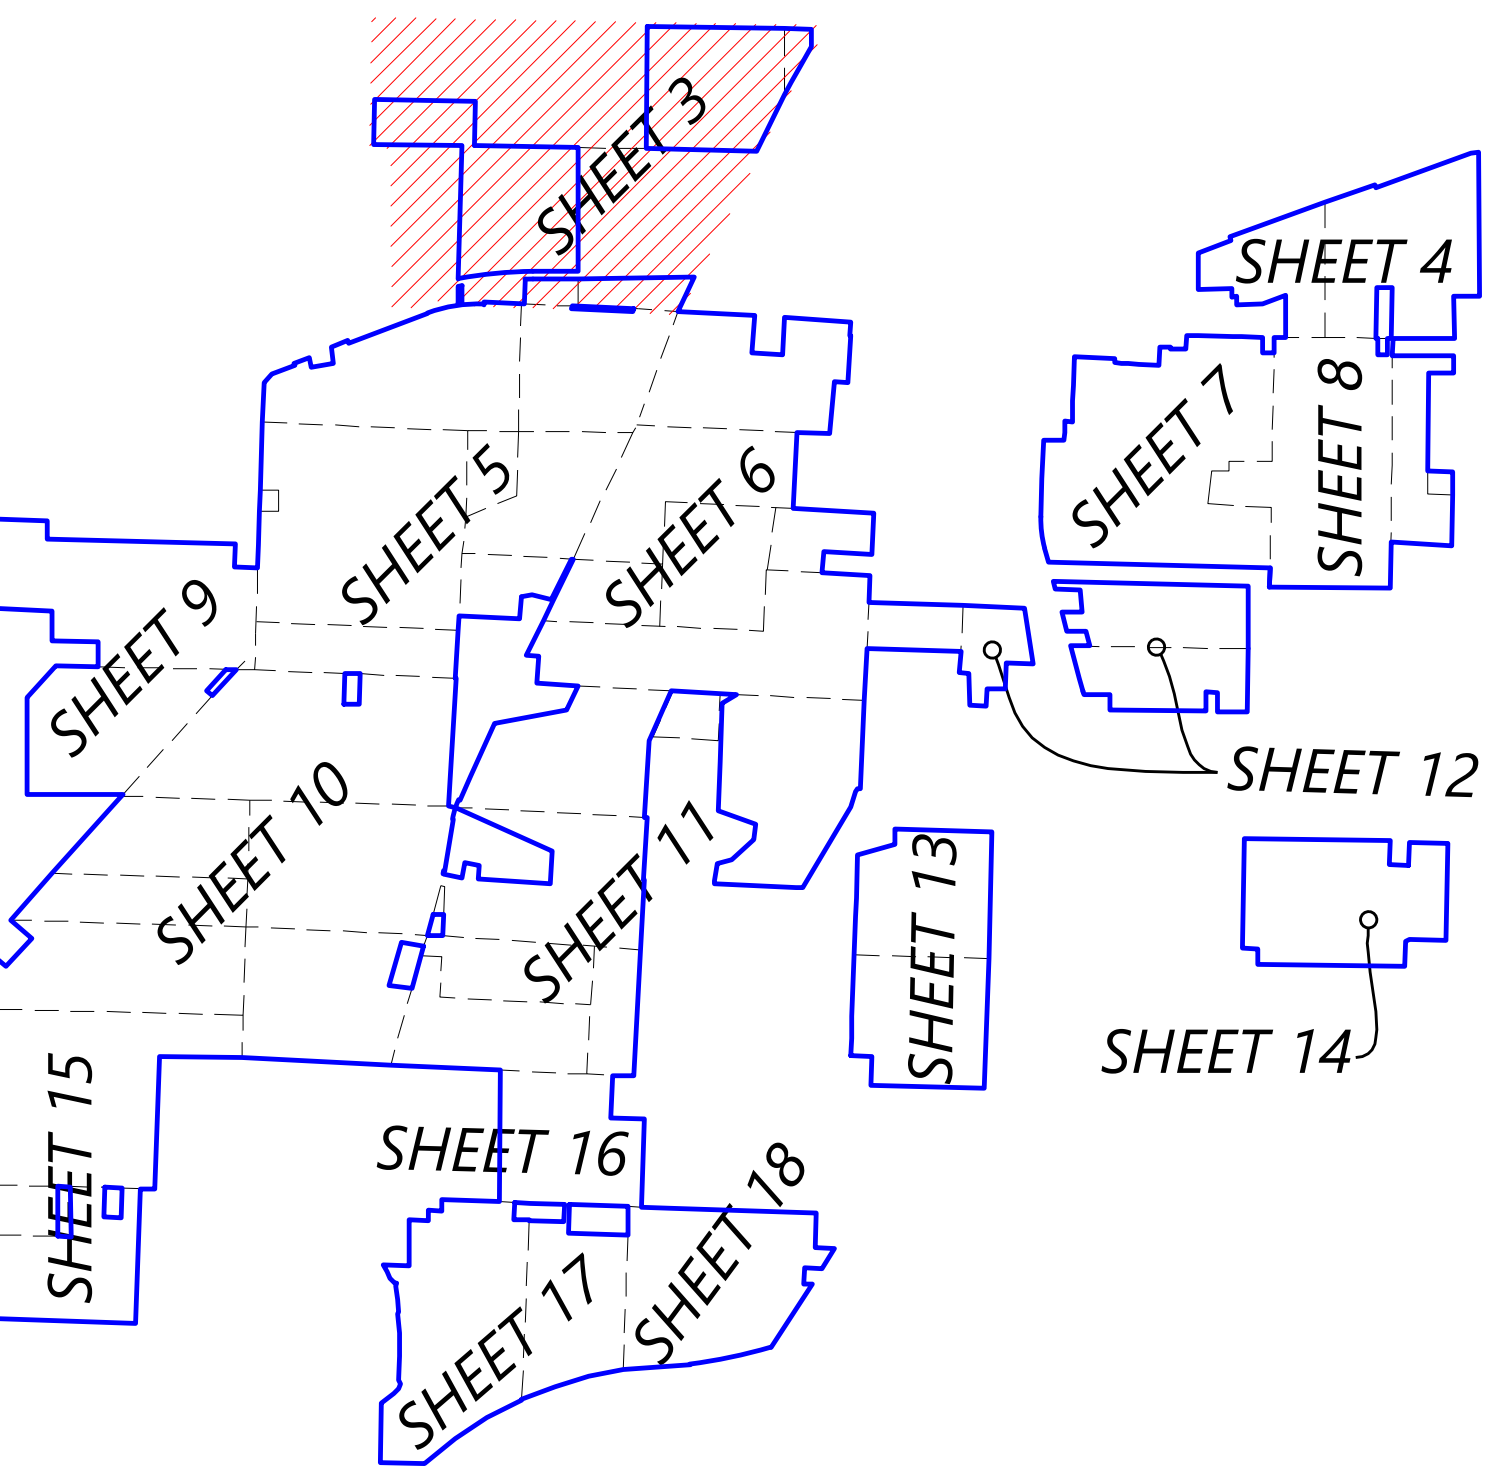

SHEET 05

KEYMAP:

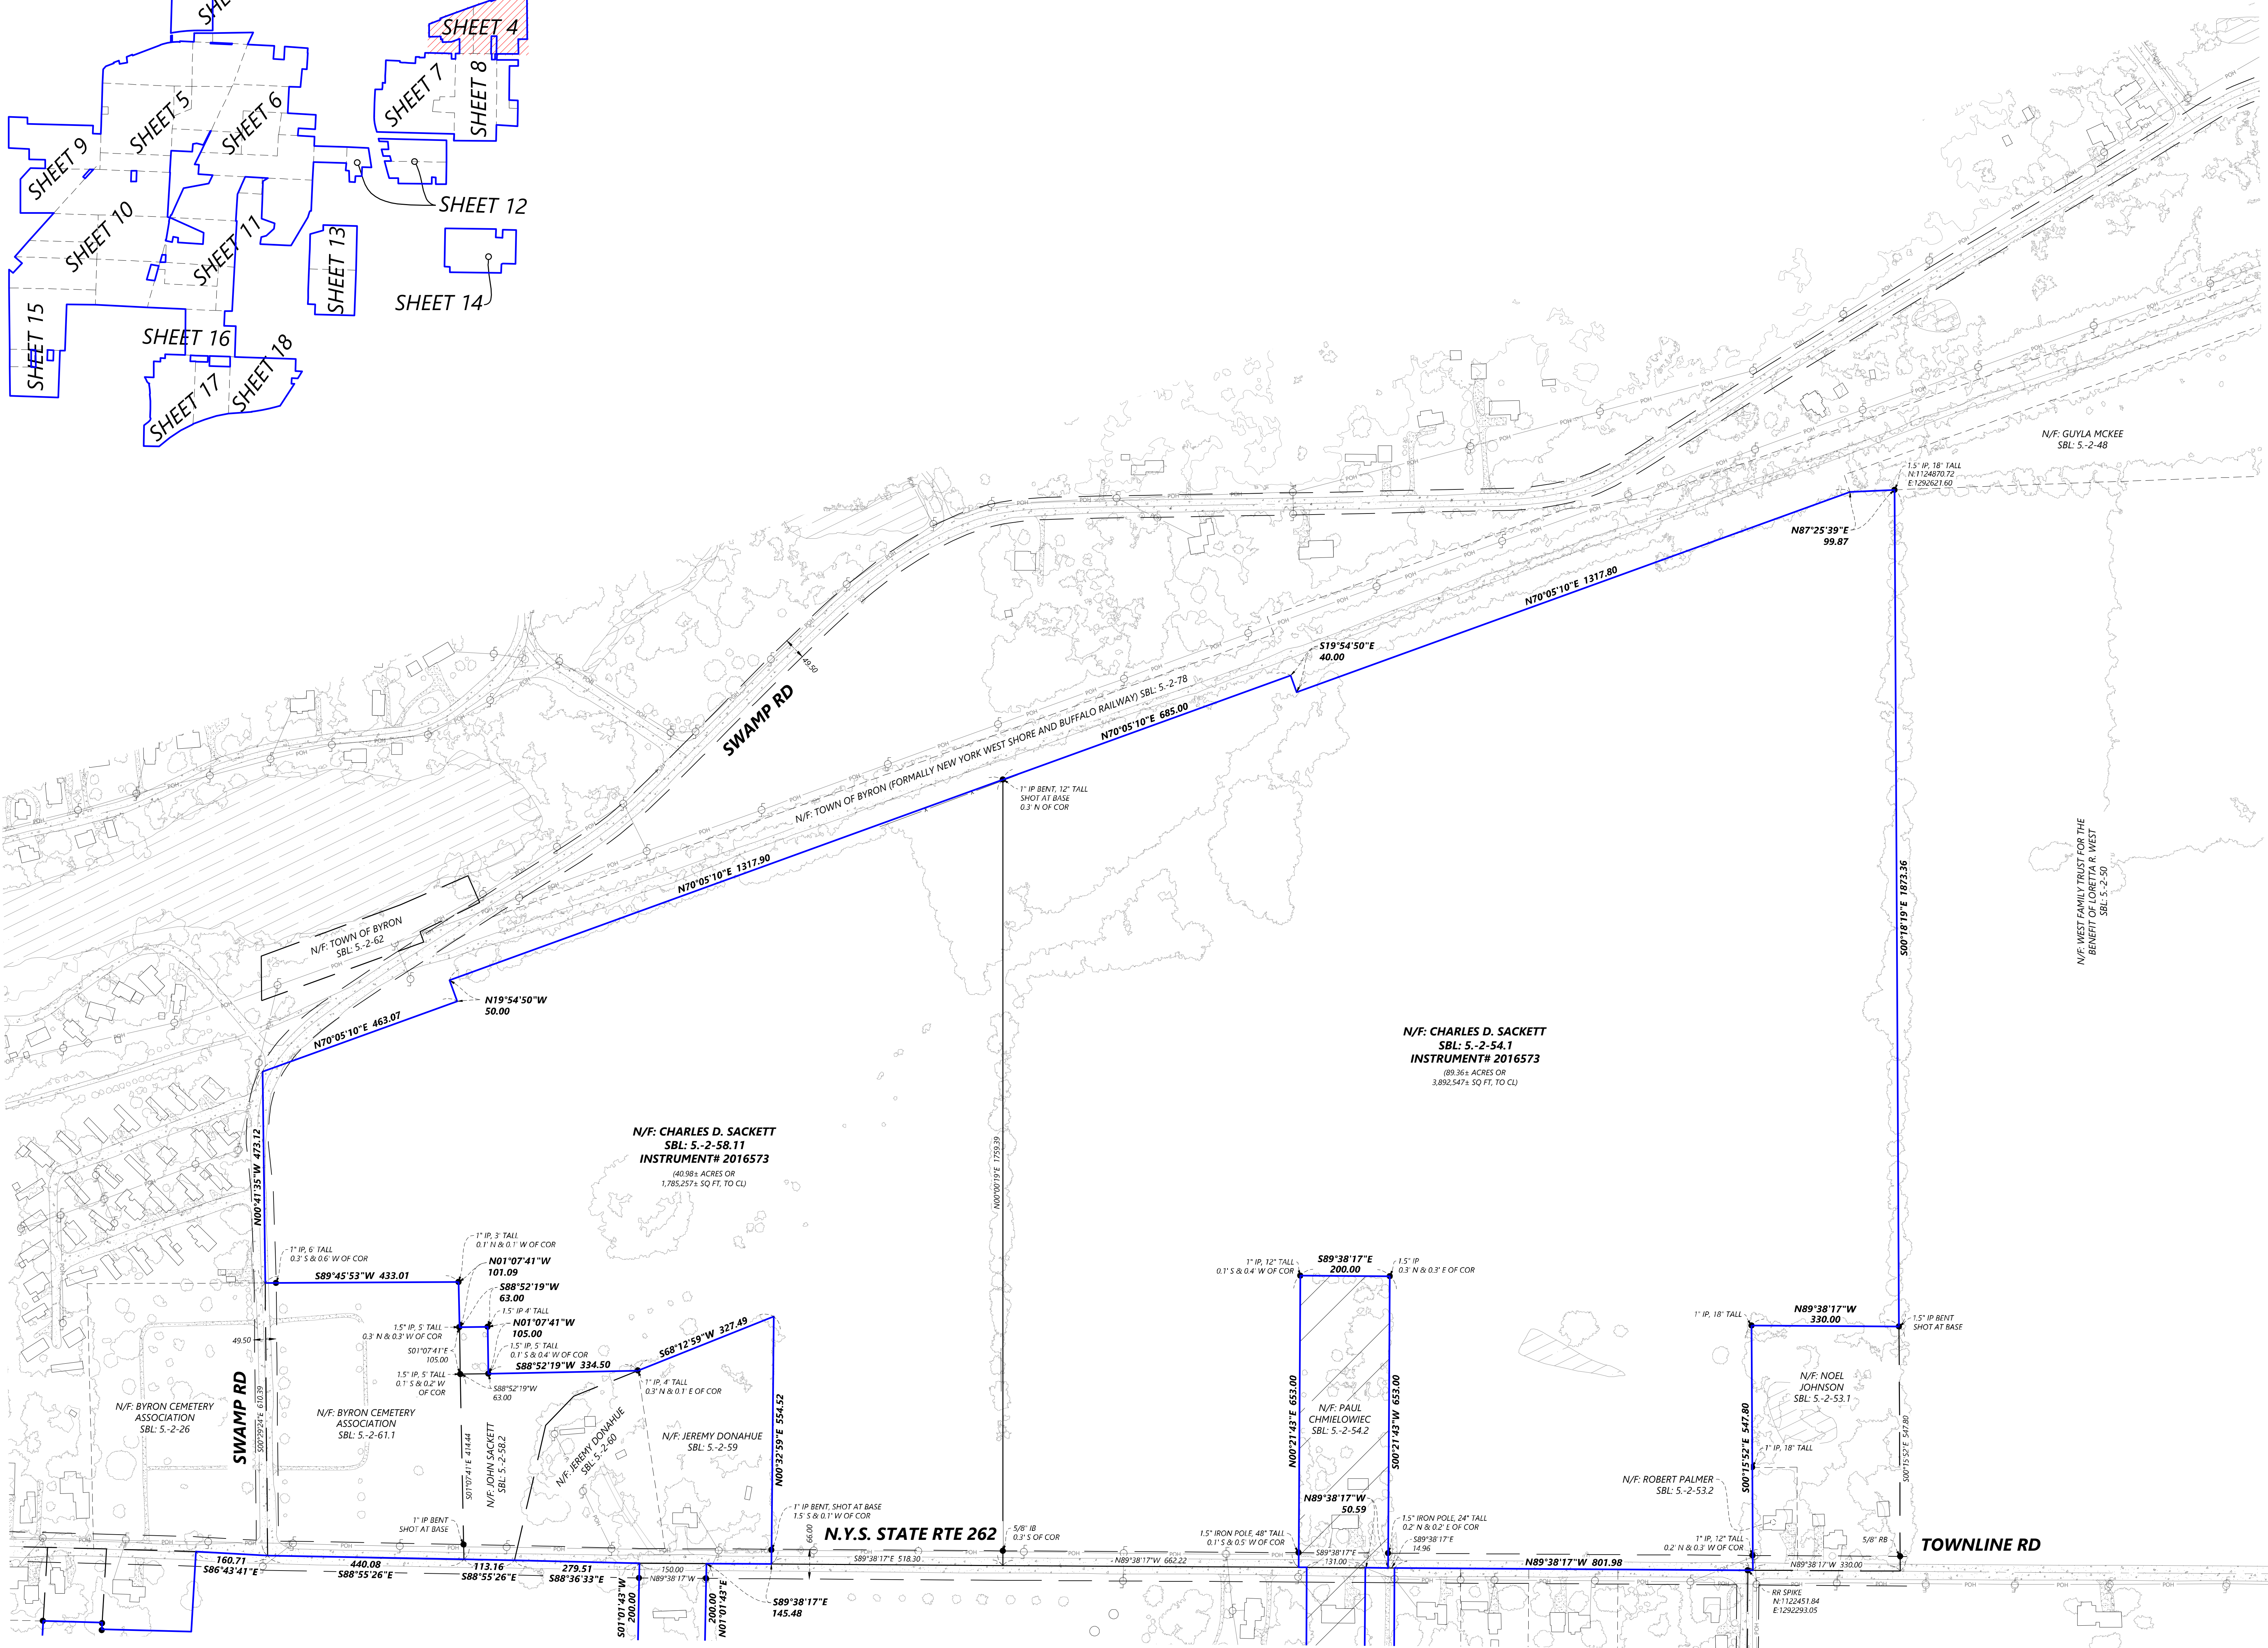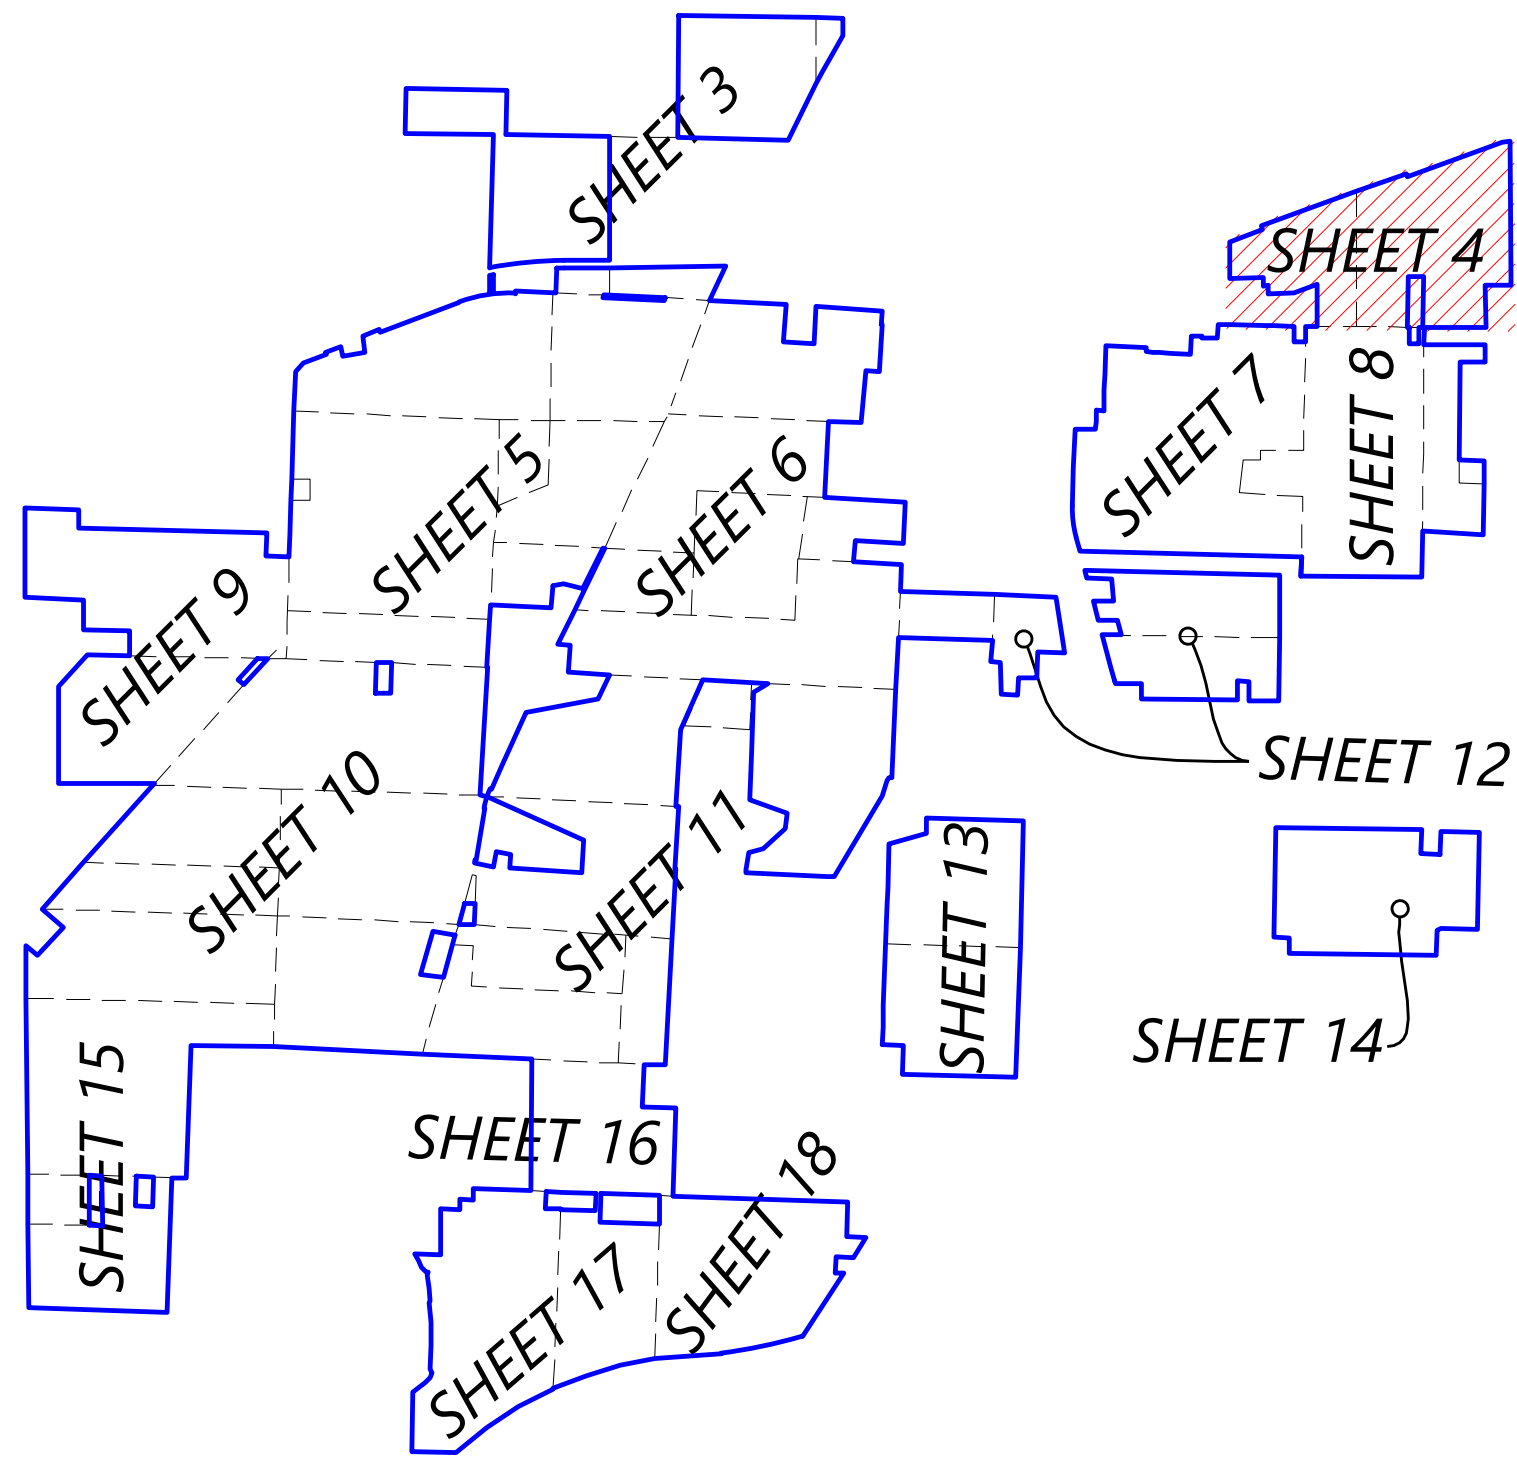

SHEET 09

SHEET 08

PREPARED FOR:




PO Box 88808
North Palm Beach, FL 33408

REVISIONS:		
#	DATE	COMMENT

LEGEND:

- GUY WIRE
- POWER POLE
- HYDRANT
- SIGN
- WATER EDGE
- POWER OVERHEAD
- FENCE LINE
- BOUNDARY LINE
- PARCEL LINE
- ADJACENT PARCEL LINES
- APPROXIMATE LOCATION OF PARCEL LINES FROM TAX MAP
- EASEMENT LINES
- EXCEPTION TO PROJECT
- DRIVE
- ROAD
- WATER
- VEGETATION
- FOUND MONUMENT (SEE LABEL)
- N/F. NOW OR FORMERLY
- COR. CORNER
- IP. IRON PIPE
- IB. IRON BAR
- RB. REBAR

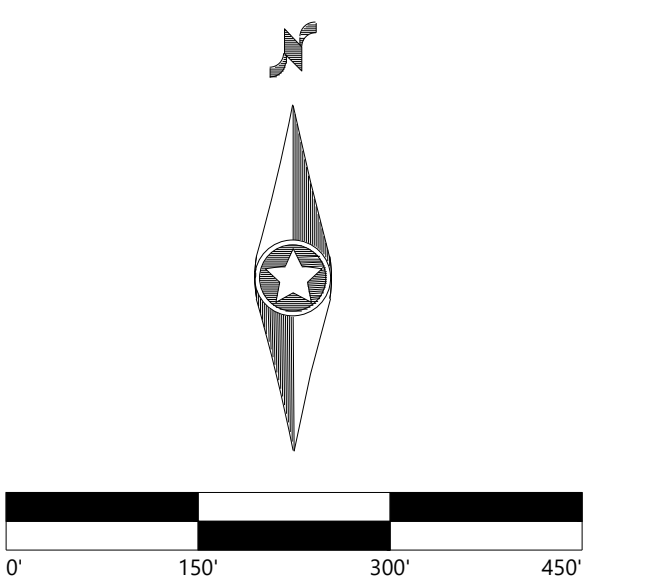

BEARING AND DISTANCES SHOWN HEREON ARE BASED ON NEW STATE PLANE COORDINATE SYSTEM, NAD1983(2011), NEW YORK WEST ZONE, US SURVEY FOOT. DISTANCES AND AREAS HAVE BEEN SCALED TO GROUND VALUES BY APPLYING A SCALE FACTOR OF 1.0000416. BEARINGS SHOWN HEREON ARE GRID NORTH.

EXCELSIOR
SOLAR PROJECT
GENESEE COUNTY, NEW YORK

RECORD OF SURVEY

DATE: 11/03/2020
SHEET: 04 of 18

PREPARED FOR:




PO Box 88808
North Palm Beach, FL 33408

REVISIONS:		
#	DATE	COMMENT

LEGEND:

- GUY WIRE
- POWER POLE
- HYDRANT
- SIGN
- WATER EDGE
- POWER OVERHEAD
- FENCE LINE
- BOUNDARY LINE
- ADJACENT PARCEL LINES
- APPROXIMATE LOCATION OF PARCEL LINES FROM TAX MAP
- EASEMENT LINES
- EXCEPTION TO PROJECT
- DRIVE
- ROAD
- WATER
- VEGETATION
- FOUND MONUMENT (SEE LABEL)
- N/F NOW OR FORMERLY
- COR CORNER
- IP IRON PIPE
- IB IRON BAR
- RB REBAR

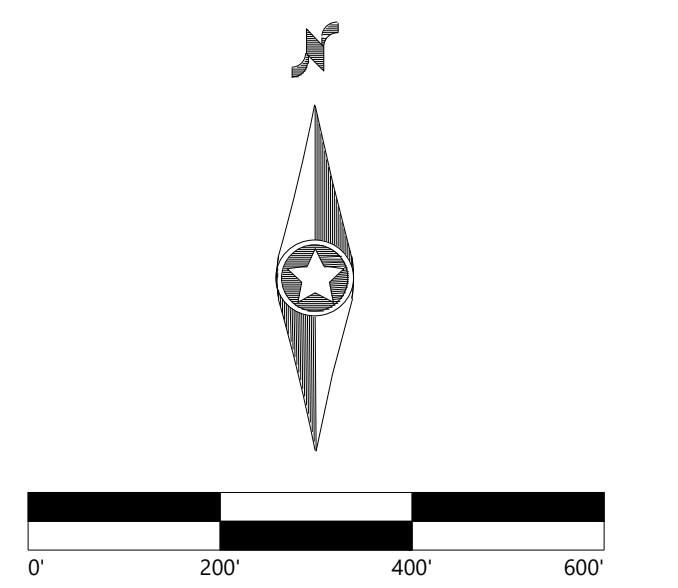


BEARING AND DISTANCES SHOWN HEREON ARE BASED ON NEW STATE PLANE COORDINATE SYSTEM, NAD1983(2011), NEW YORK WEST ZONE, US SURVEY FOOT. DISTANCES AND AREAS HAVE BEEN SCALED TO GROUND VALUES BY APPLYING A SCALE FACTOR OF 1.0000416. BEARINGS SHOWN HEREON ARE GRID NORTH.


EXCELSIOR
SOLAR PROJECT
GENESSEE COUNTY, NEW YORK

RECORD OF SURVEY


DATE: 11/03/2020
SHEET: 05 of 18

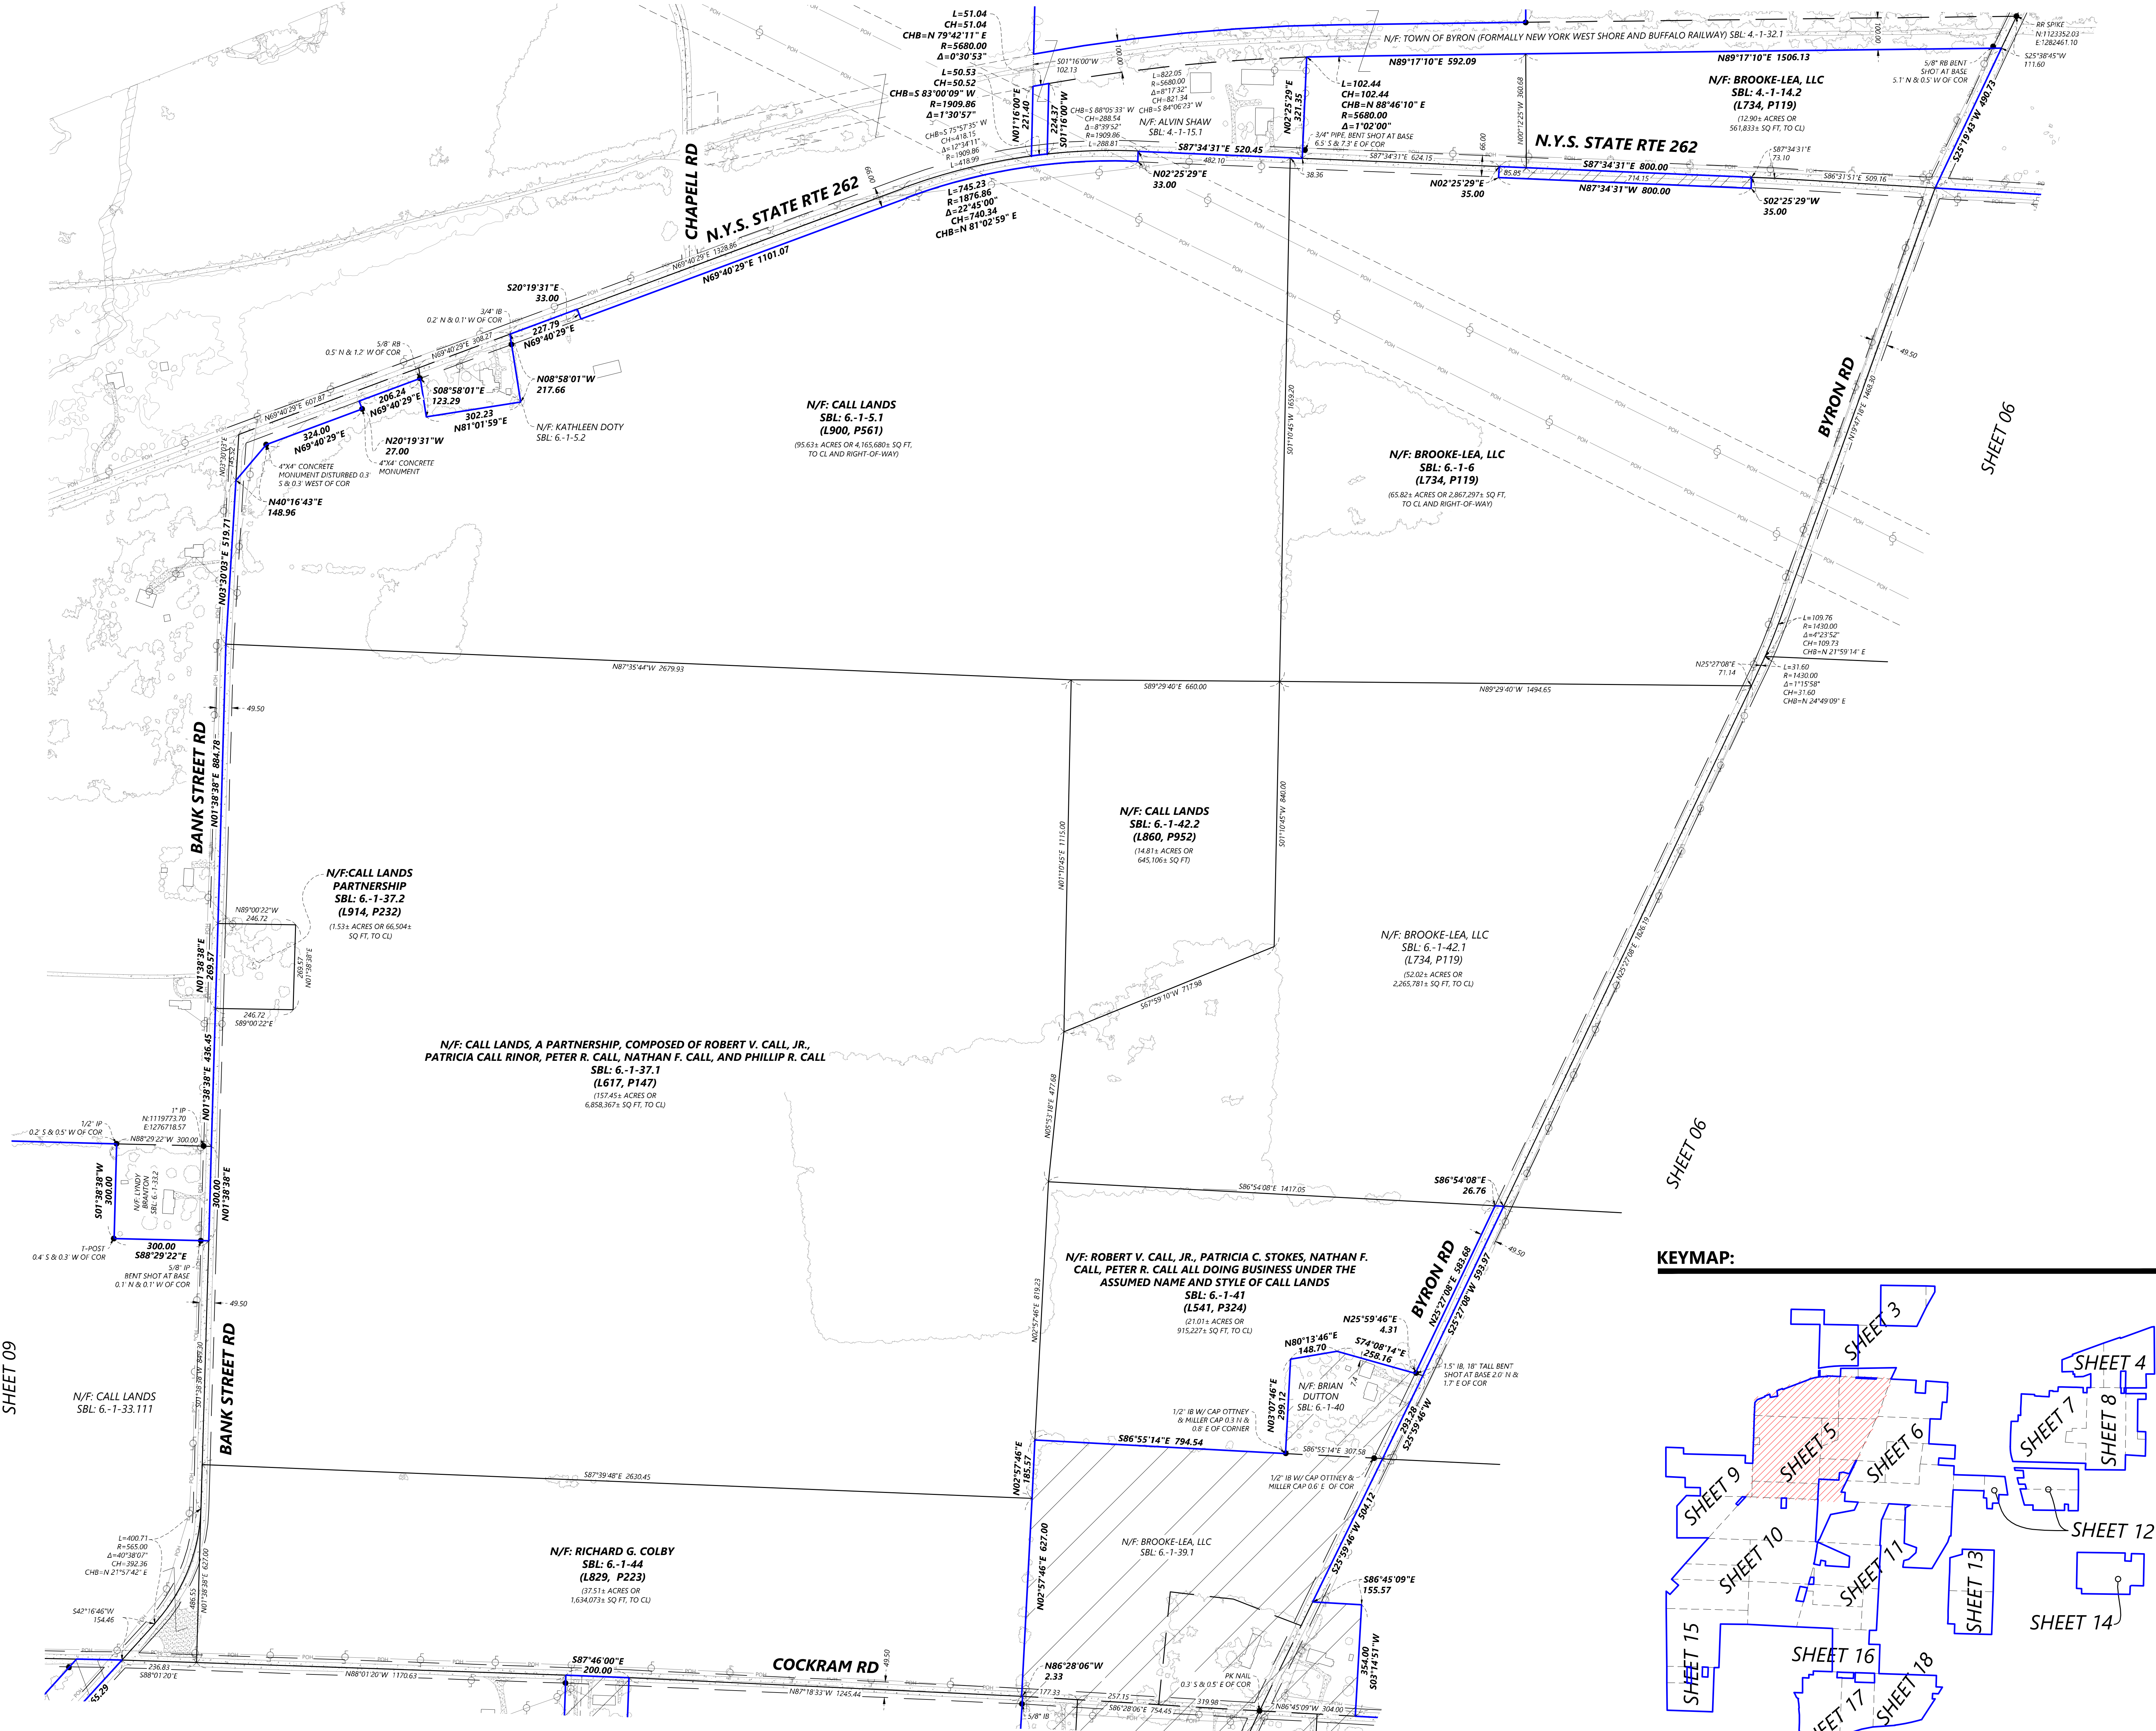


KEYMAP:

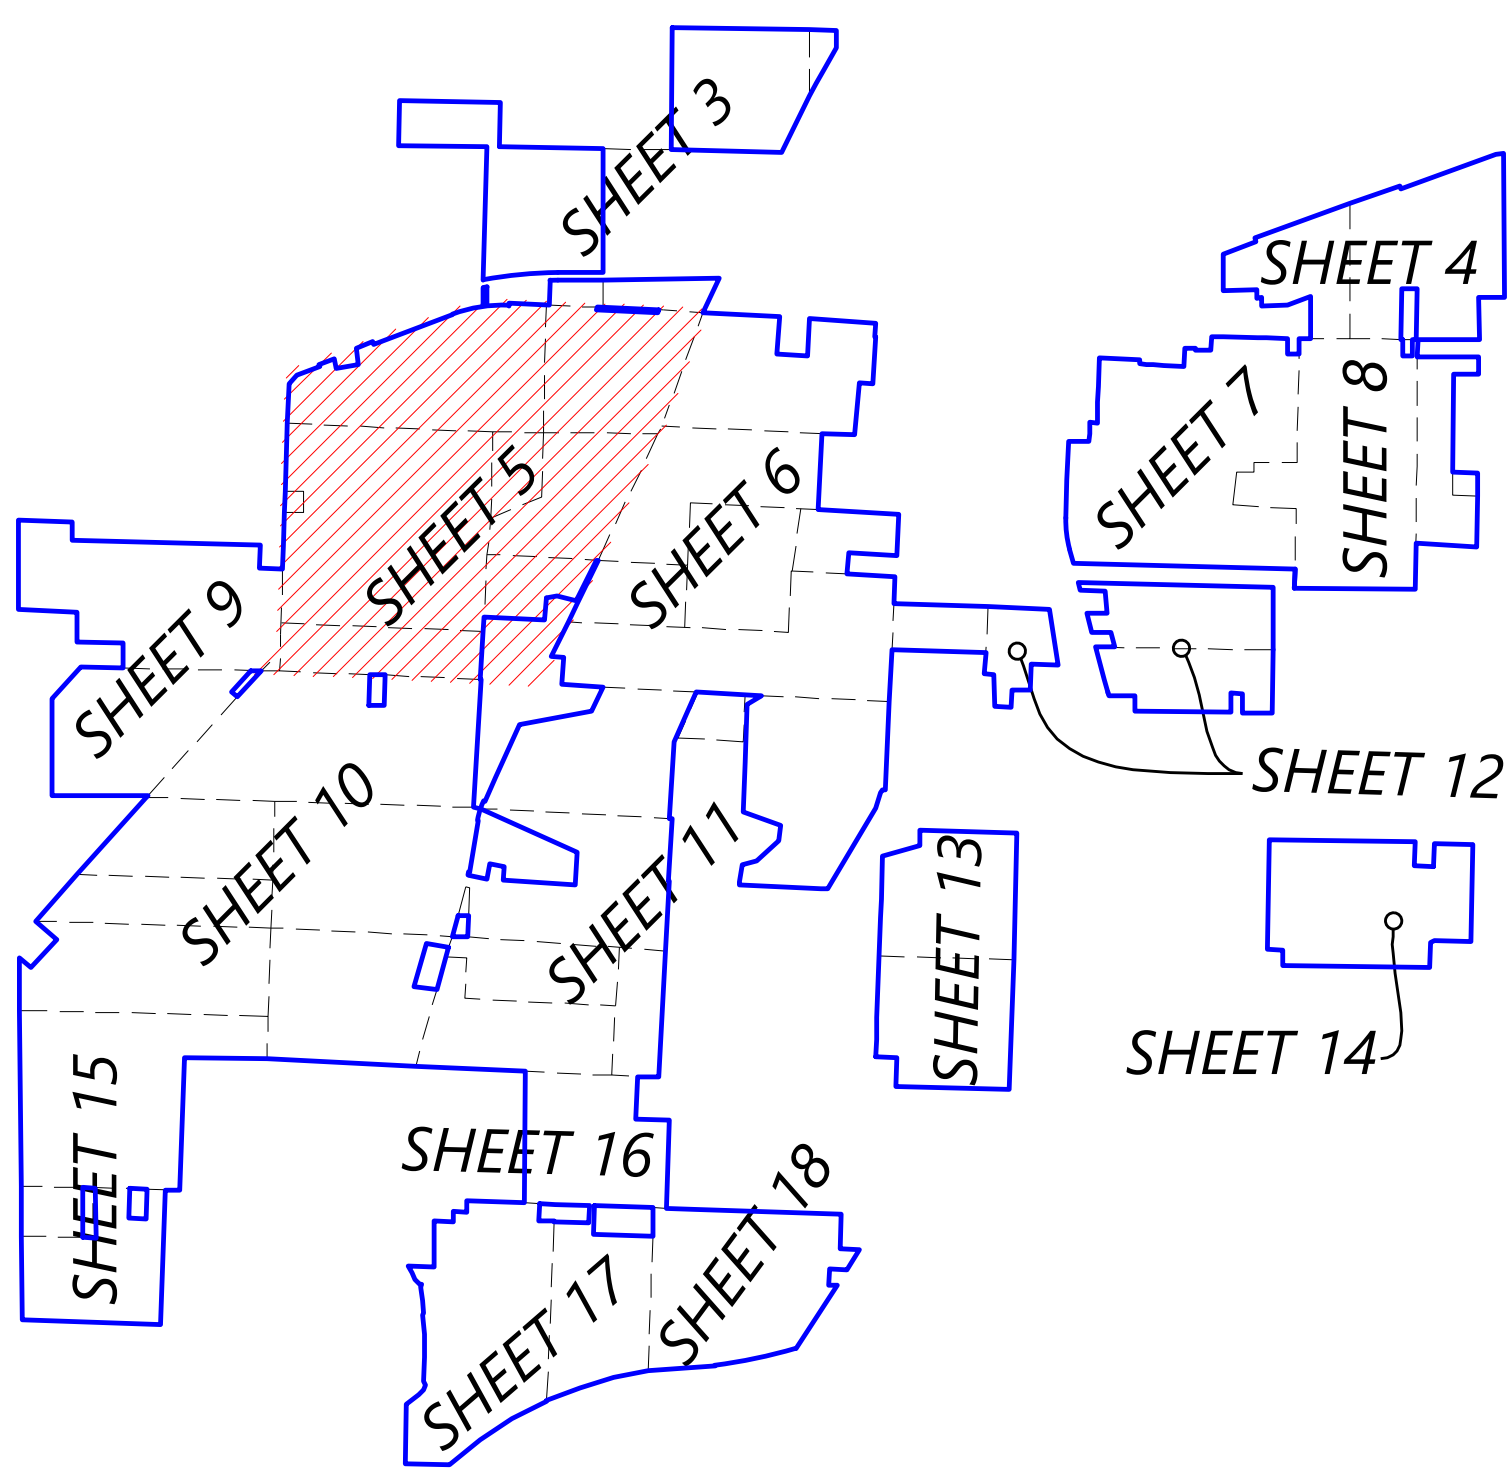

KEYMAP:

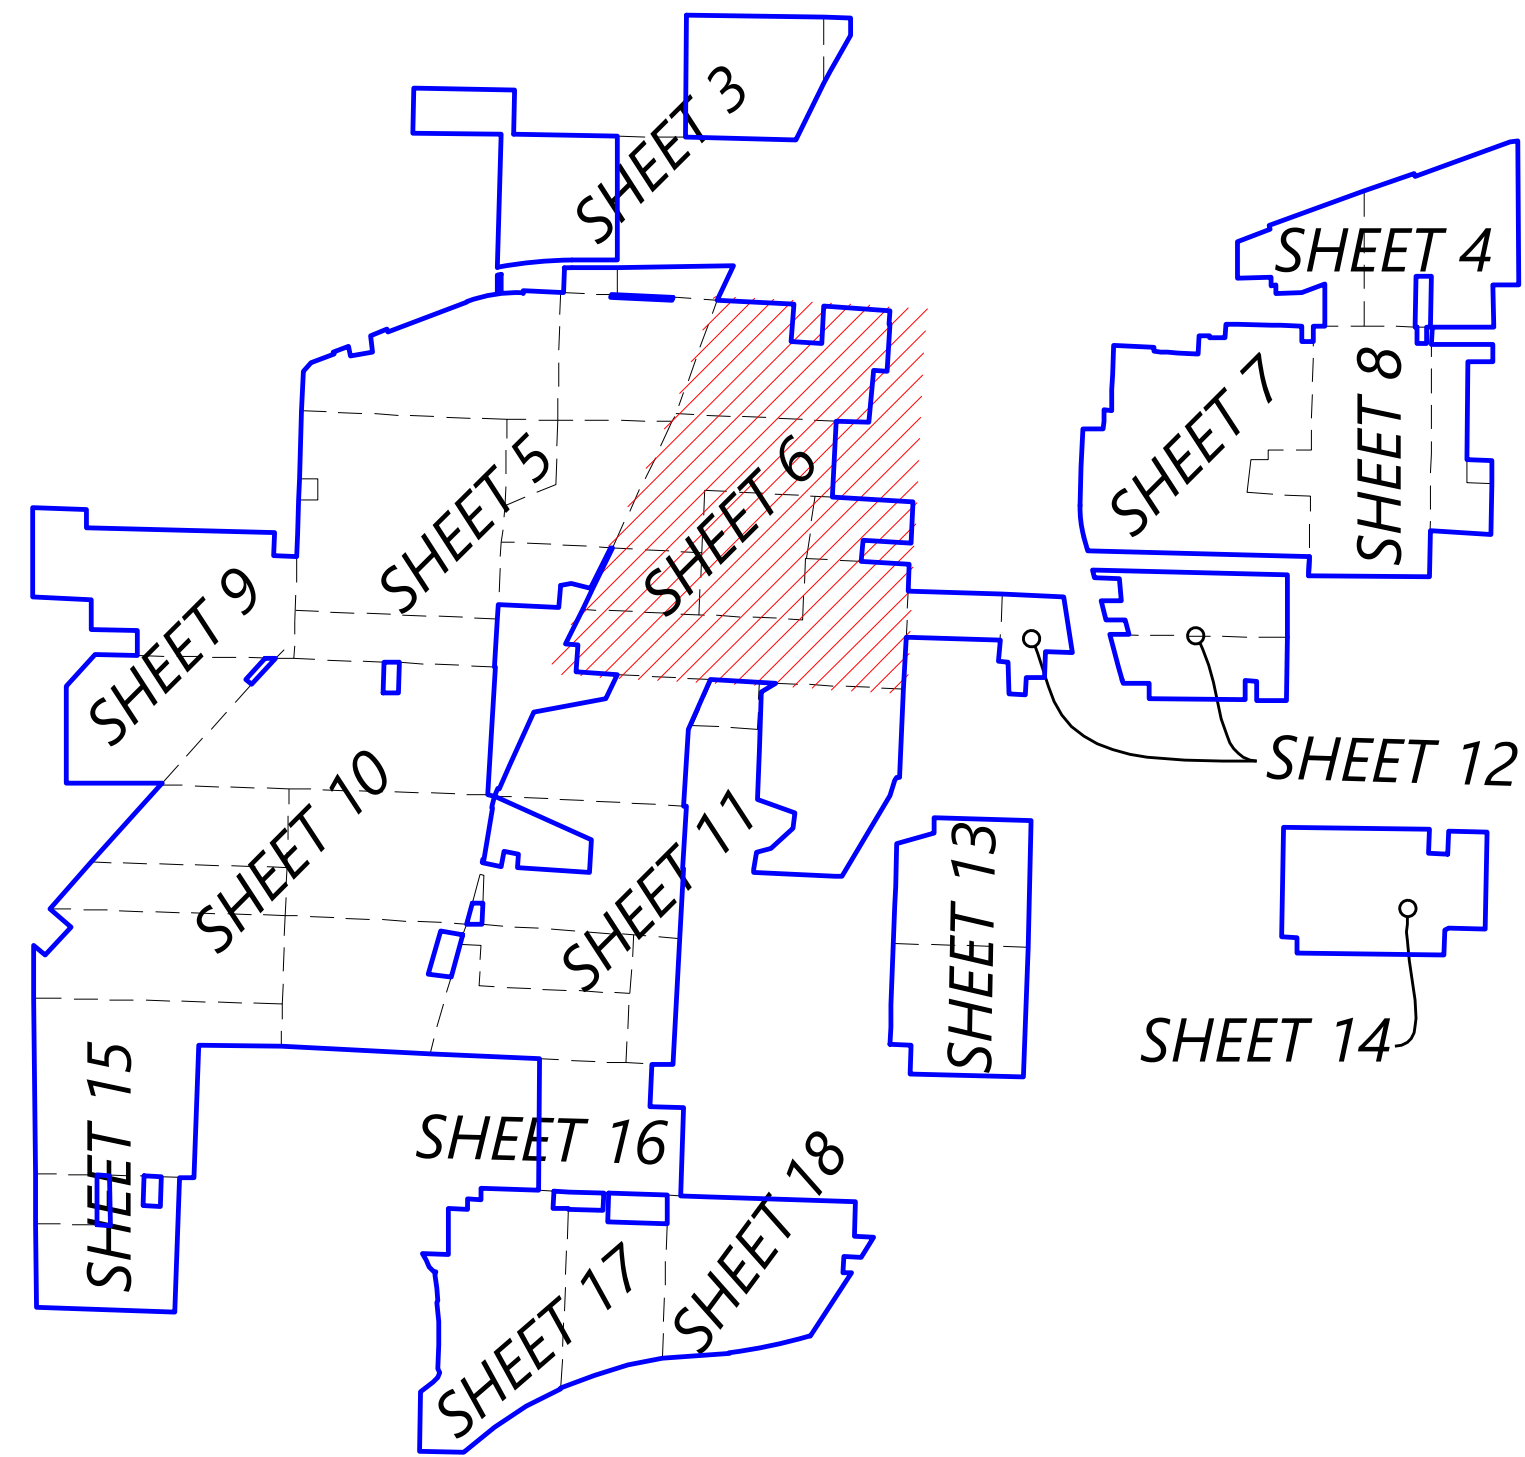

DETAIL A

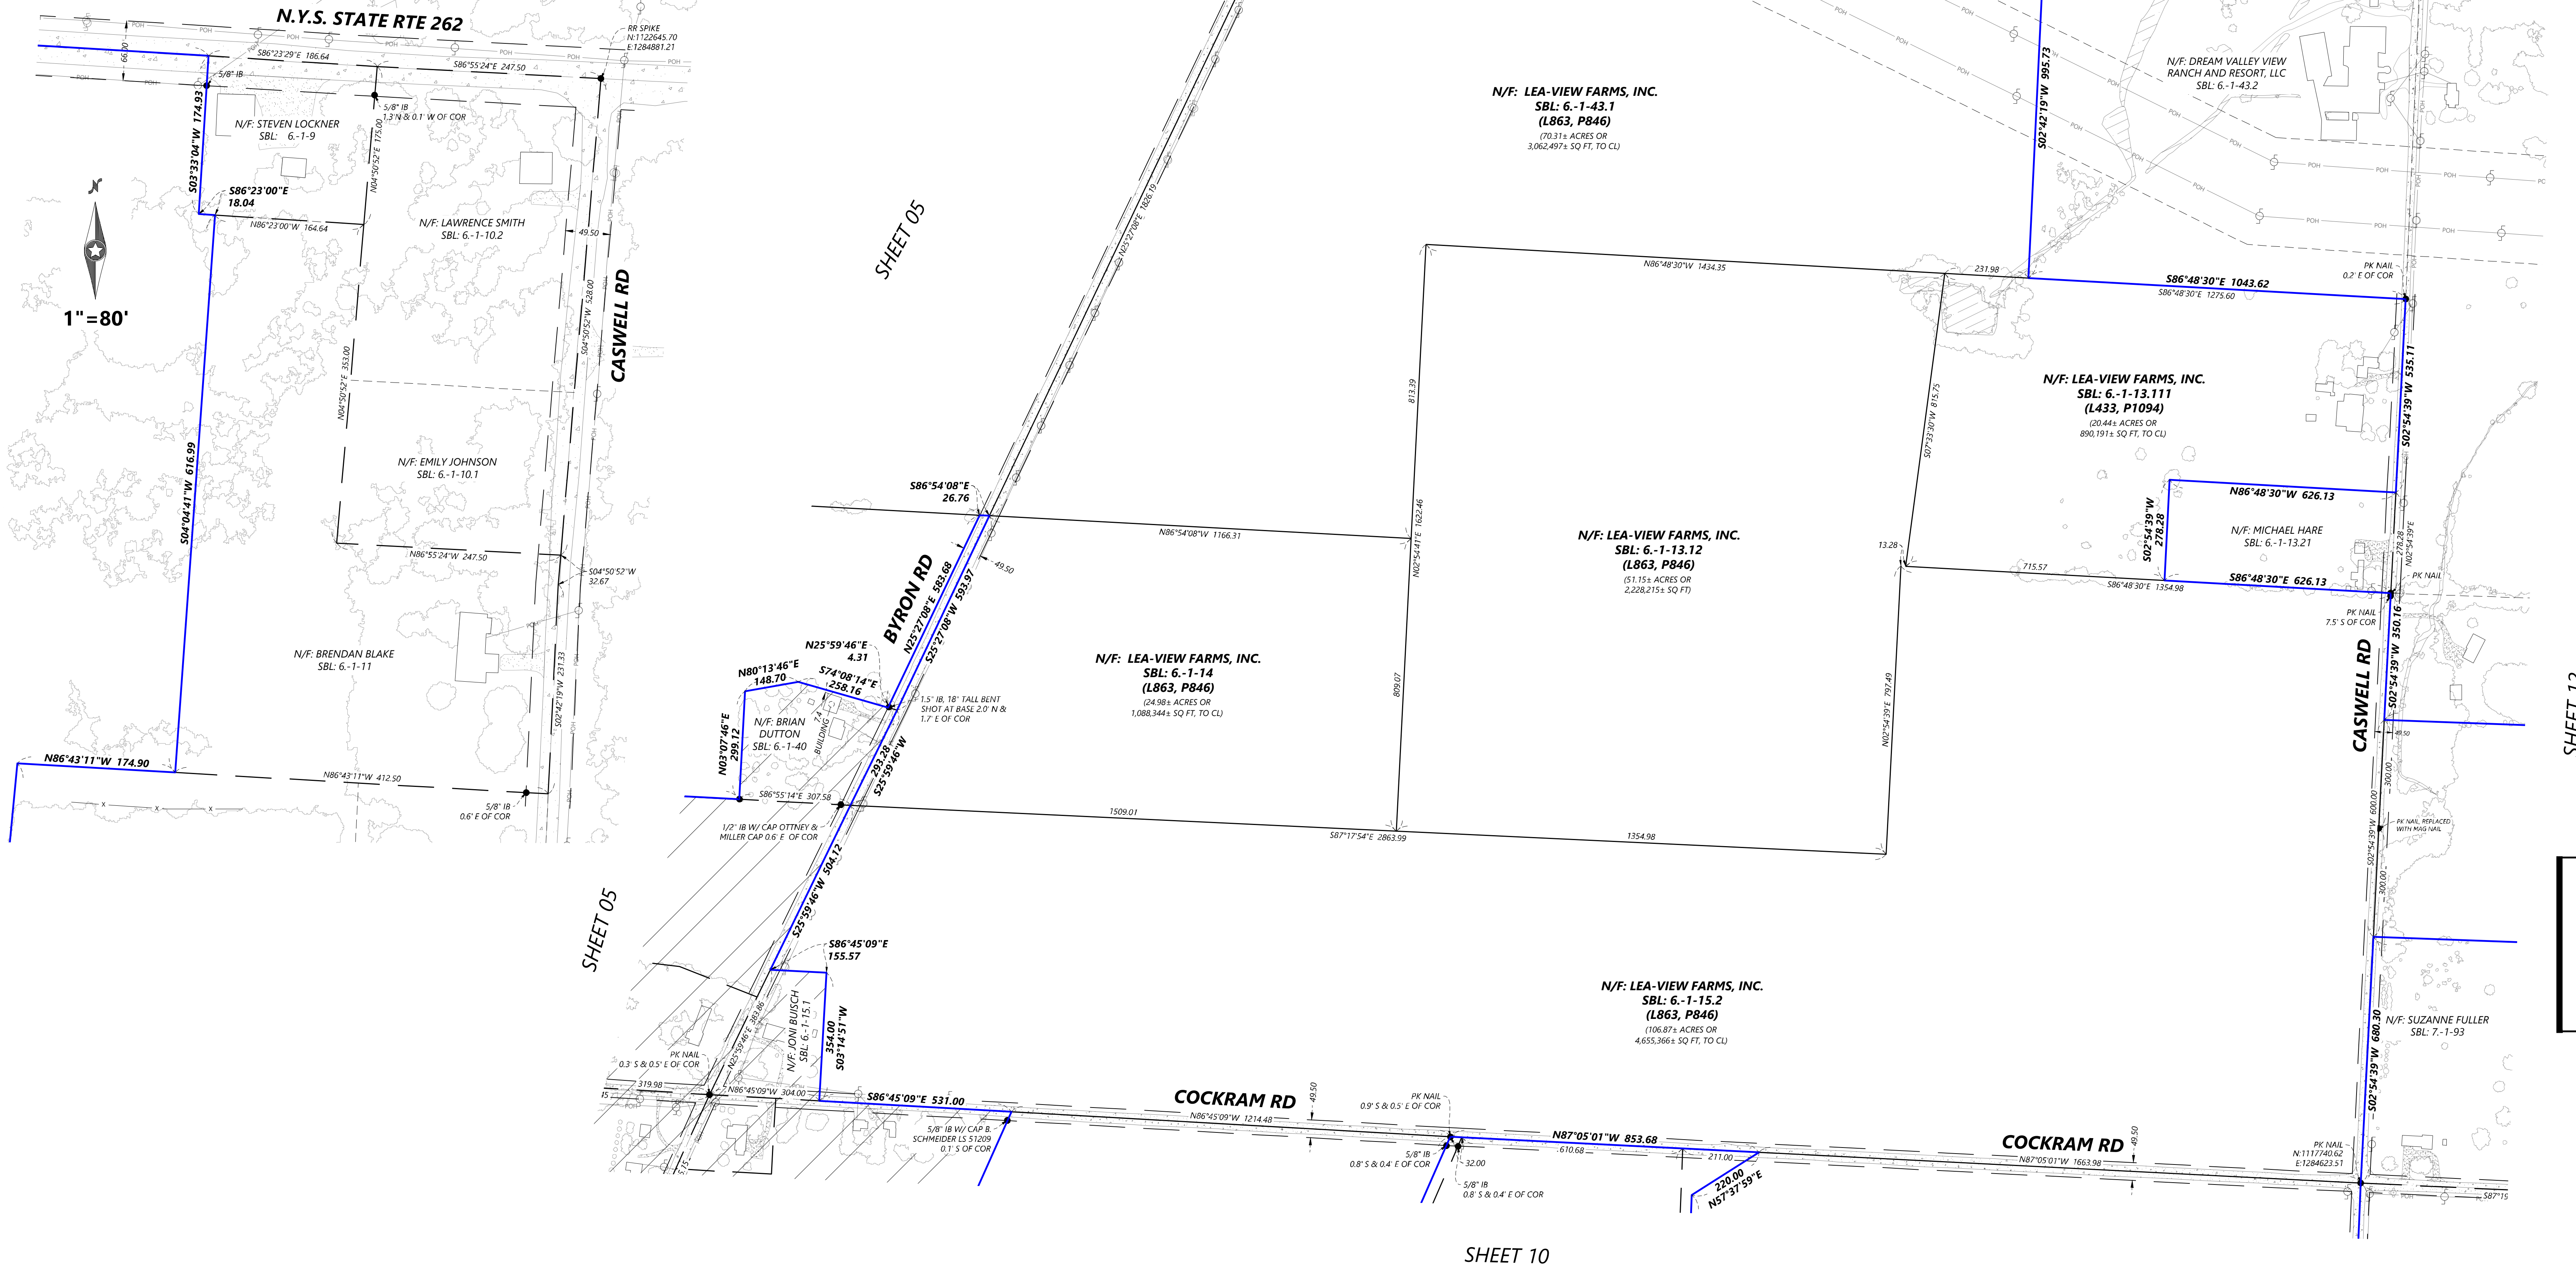

PREPARED FOR:




PO Box 88808
North Palm Beach, FL 33408

REVISIONS:		
#	DATE	COMMENT

LEGEND:

- GUY WIRE
- POWER POLE
- HYDRANT
- SIGN
- WATER EDGE
- POWER OVERHEAD
- FENCE LINE
- BOUNDARY LINE
- PARCEL LINE
- ADJACENT PARCEL LINES
- APPROXIMATE LOCATION OF PARCEL LINES FROM TAX MAP
- EASEMENT LINES
- EXCEPTION TO PROJECT
- DRIVE
- ROAD
- WATER
- VEGETATION

- FOUND MONUMENT (SEE LABEL)
- N/F: NOW OR FORMERLY
- COR: CORNER
- IP: IRON PIPE
- IB: IRON BAR
- RB: REBAR

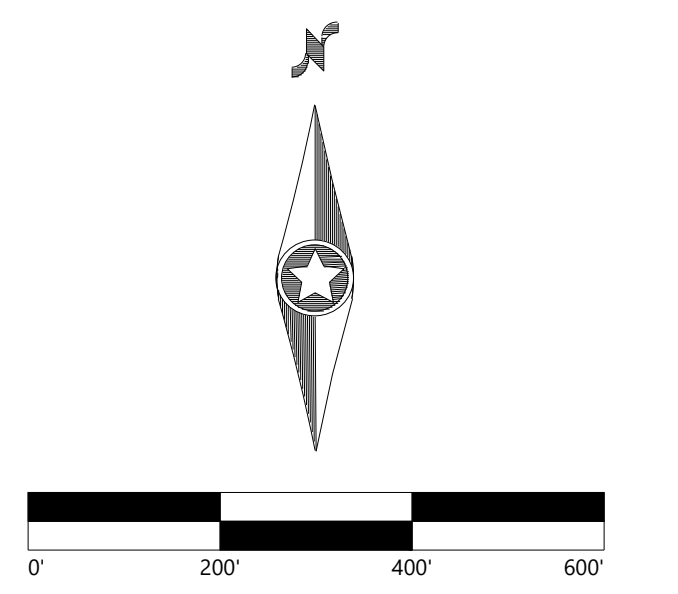

BEARING AND DISTANCES SHOWN HEREON ARE BASED ON NEW STATE PLANE COORDINATE SYSTEM, NAD1983(2011), NEW YORK WEST ZONE, US SURVEY FOOT. DISTANCES AND AREAS HAVE BEEN SCALED TO GROUND VALUES BY APPLYING A SCALE FACTOR OF 1.0000416. BEARINGS SHOWN HEREON ARE GRID NORTH.

EXCELSIOR
SOLAR PROJECT
GENESEE COUNTY, NEW YORK

RECORD OF SURVEY

DATE: 11/03/2020
SHEET: 06 of 18

PREPARED FOR:




PO Box 88808
North Palm Beach, FL 33408

REVISIONS:		
#	DATE	COMMENT

LEGEND:

	GUY WIRE
	POWER POLE
	HYDRANT
	SIGN
	WATER EDGE
	POWER OVERHEAD
	FENCE LINE
	BOUNDARY LINE
	PARCEL LINE
	ADJACENT PARCEL LINES
	APPROXIMATE LOCATION OF PARCEL LINES FROM TAX MAP
	EASEMENT LINES
	EXCEPTION TO PROJECT
	DRIVE
	ROAD
	WATER
	VEGETATION
	FOUND MONUMENT (SEE LABEL)
	NOW OR FORMERLY CORNER
	IRON PIPE
	IRON BAR
	REBAR

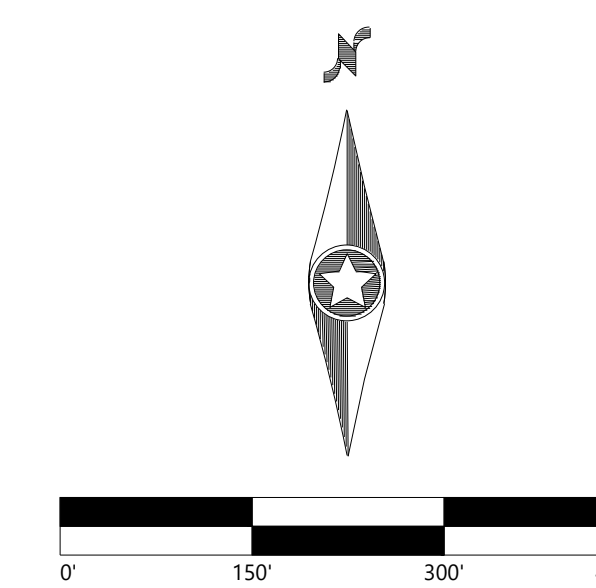

BEARING AND DISTANCES SHOWN HEREON ARE BASED ON NEW STATE PLANE COORDINATE SYSTEM, NAD1983(2011), NEW YORK WEST ZONE, US SURVEY FOOT. DISTANCES AND AREAS HAVE BEEN SCALED TO GROUND VALUES BY APPLYING A SCALE FACTOR OF 1.0000416. BEARINGS SHOWN HEREON ARE GRID NORTH.

EXCELSIOR SOLAR PROJECT

GENESEE COUNTY, NEW YORK


RECORD OF SURVEY

DATE: 11/03/2020

SHEET: 07 of 18


SHEET 04

KEYMAP:

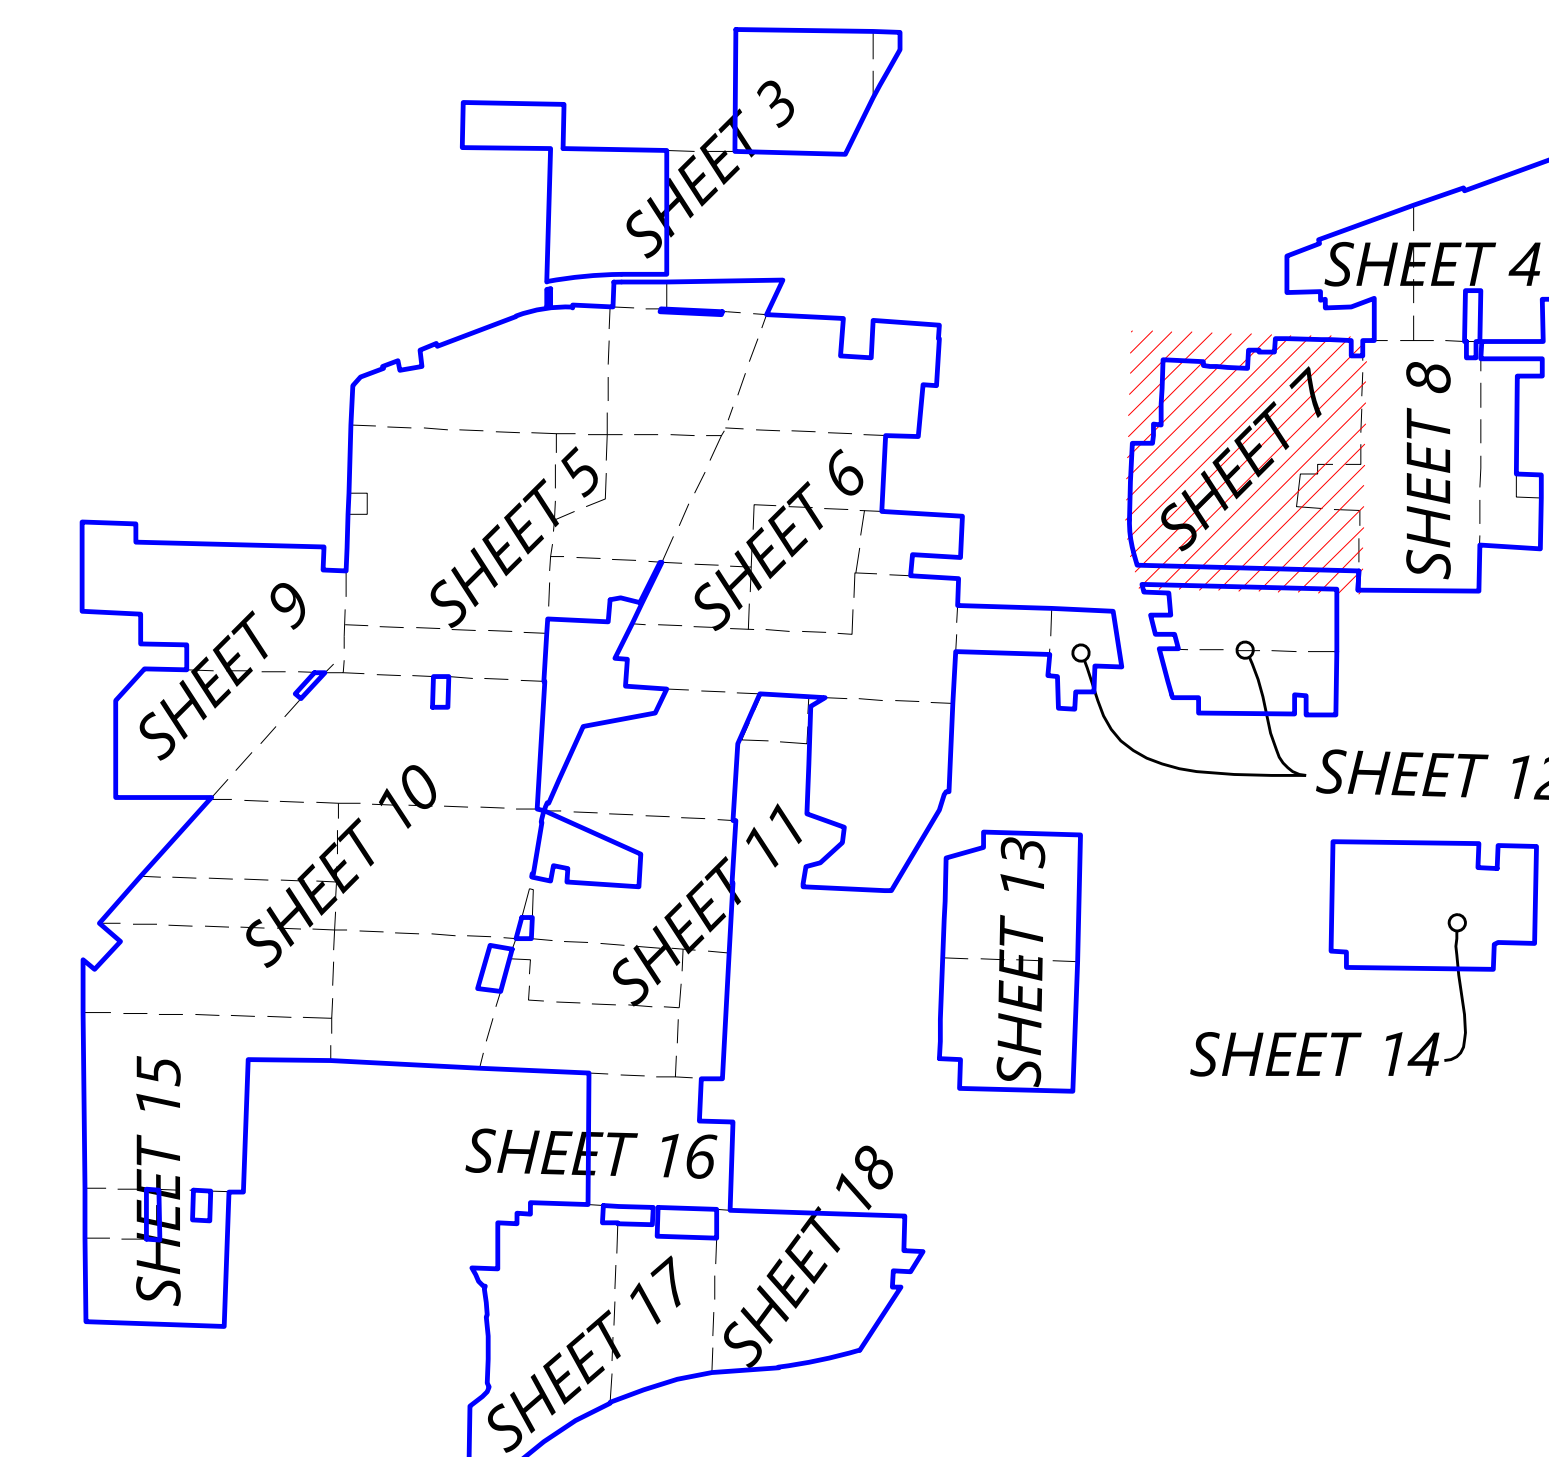


SHEET 12


DETAIL B

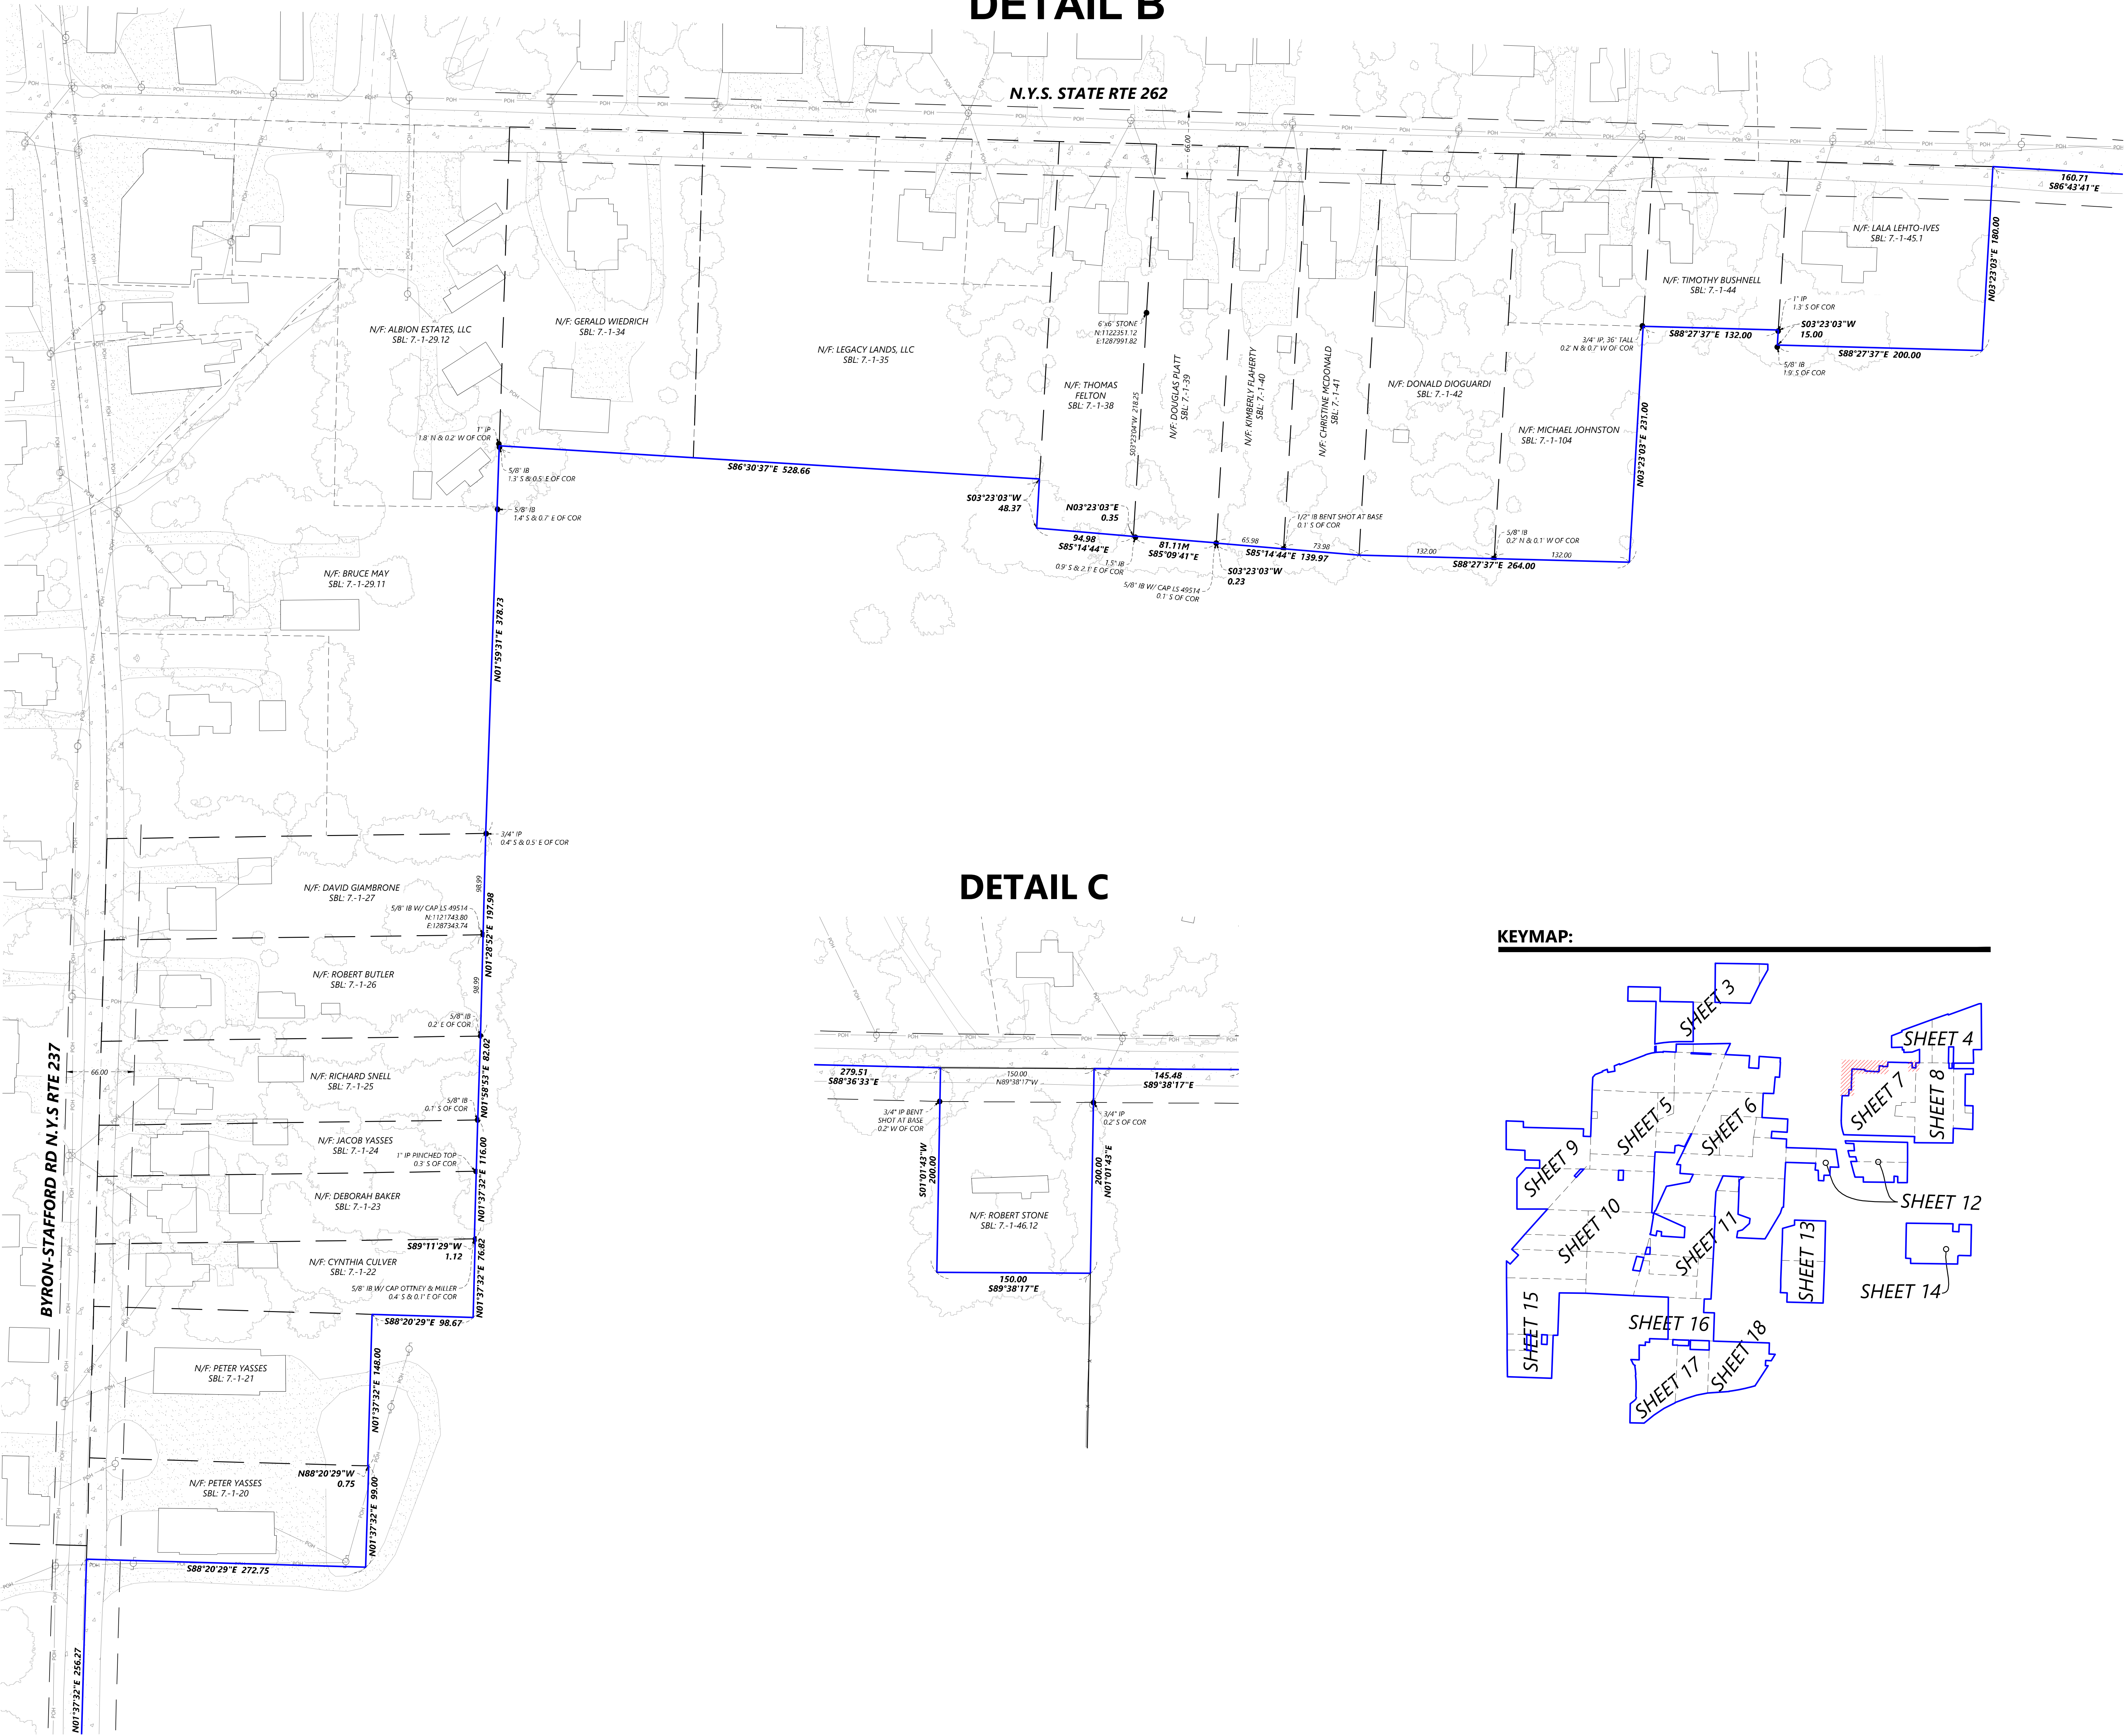

DETAIL C

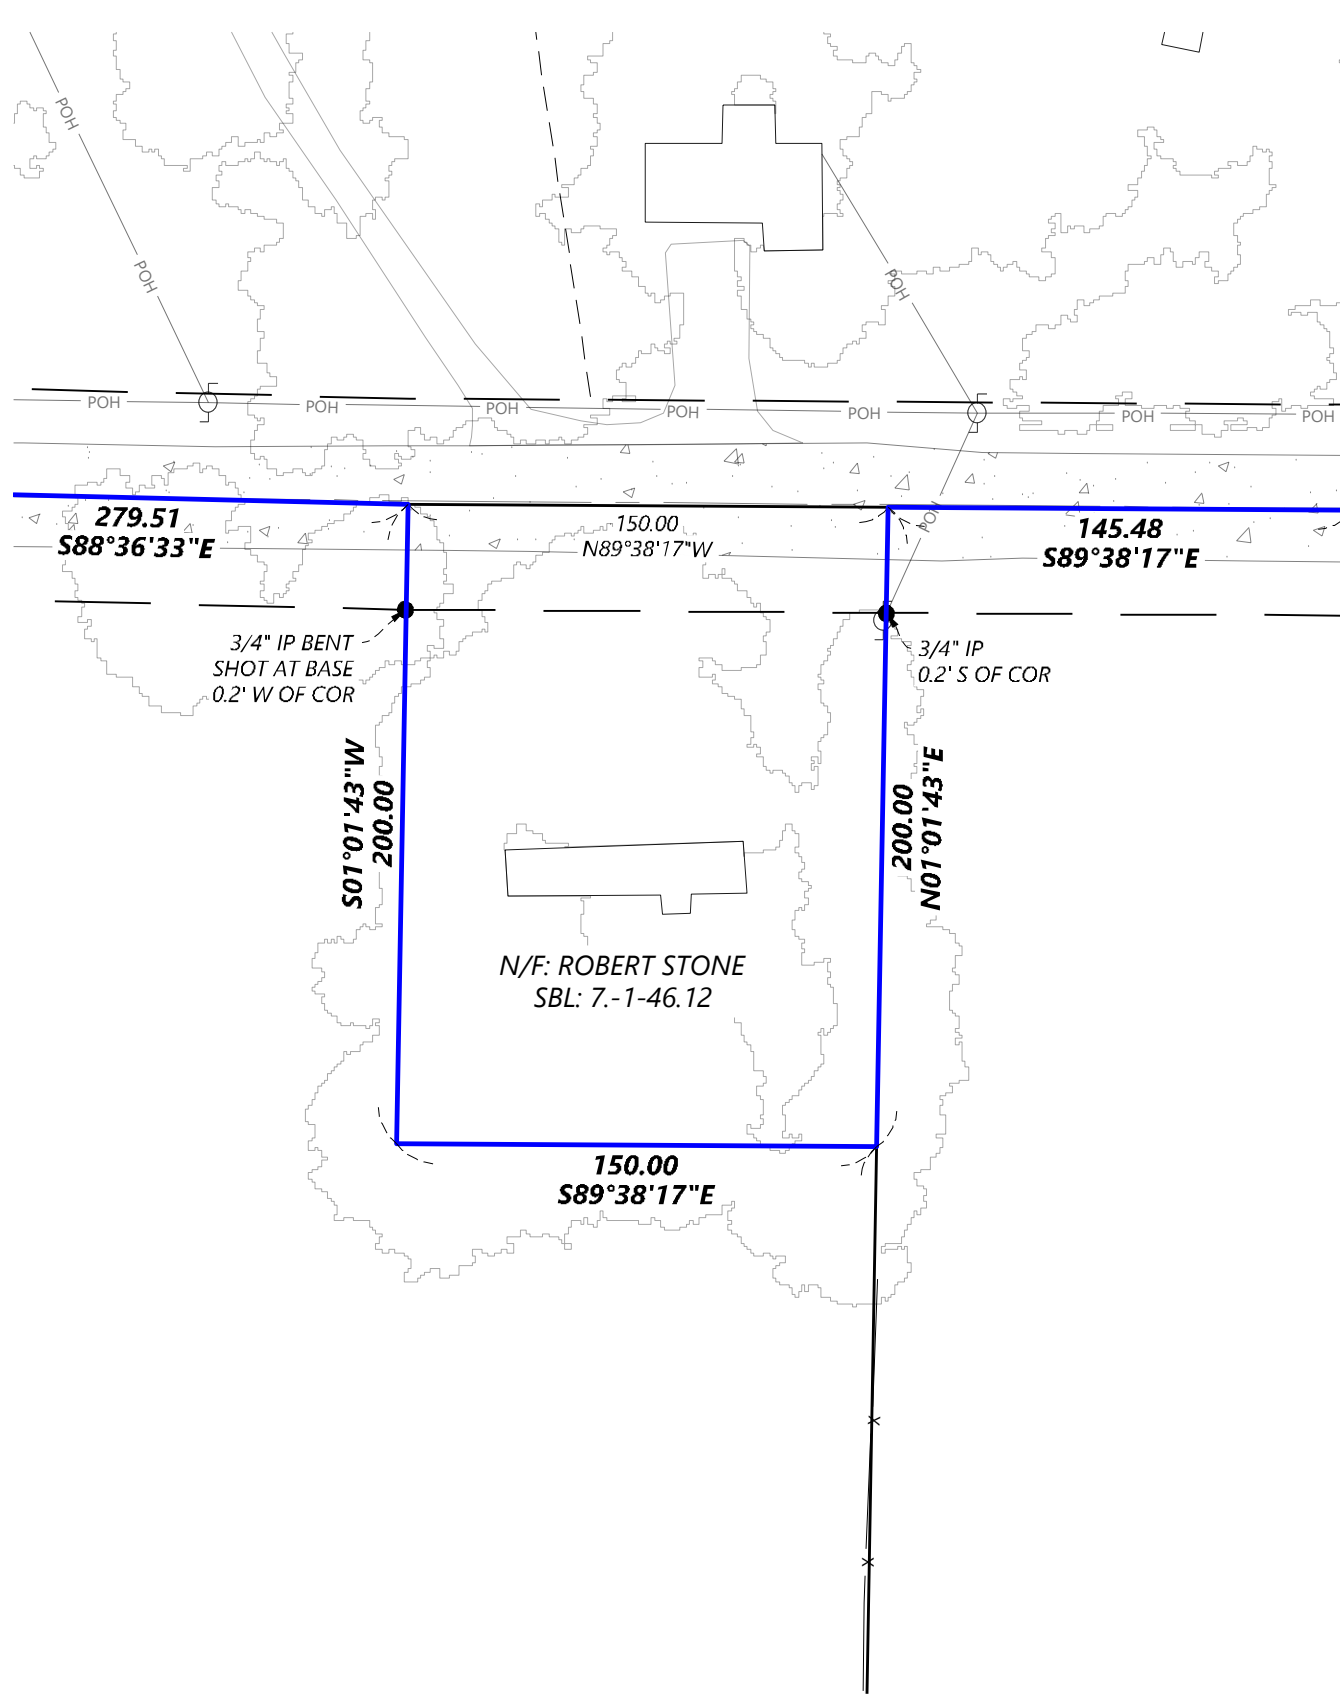

KEYMAP:

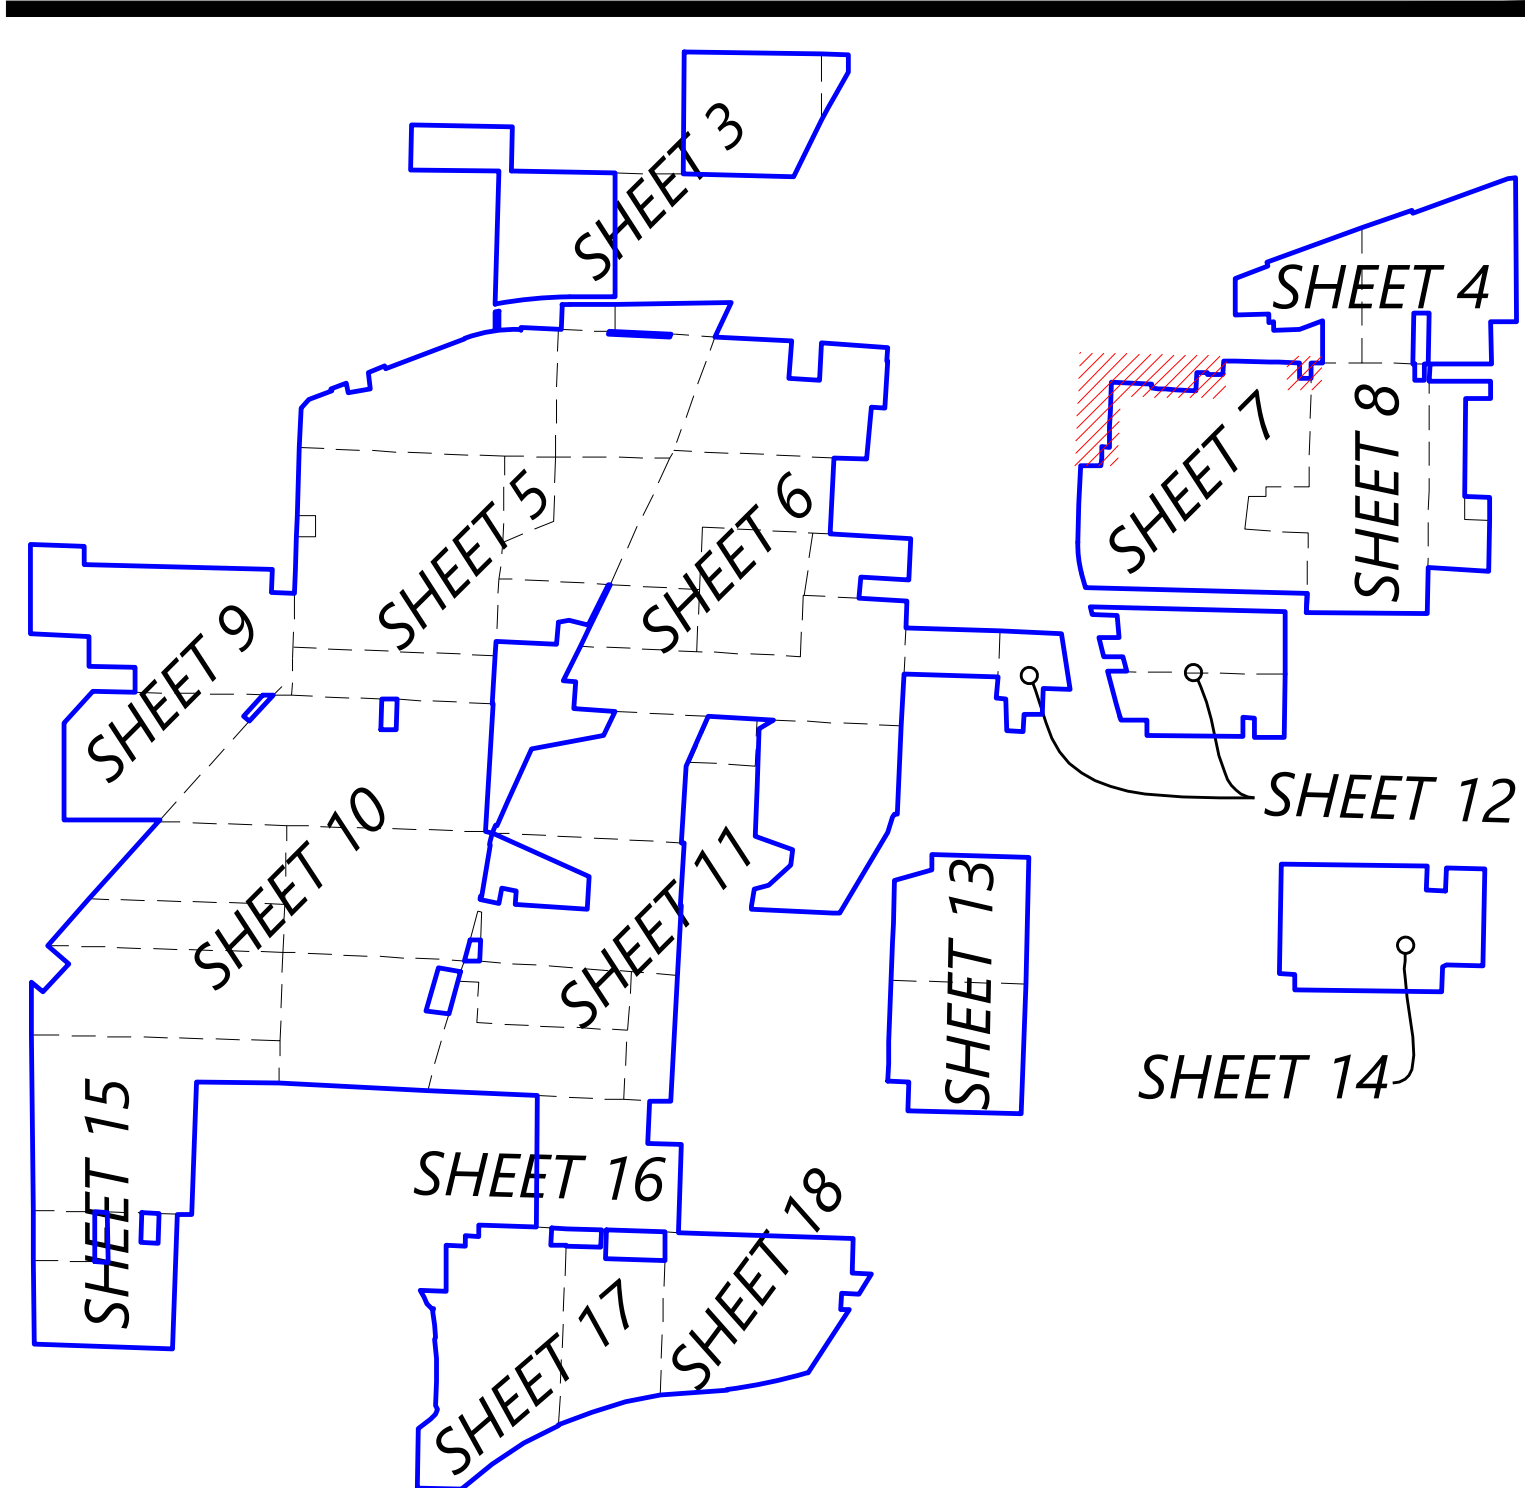

PREPARED FOR:




PO Box 88808
North Palm Beach, FL 33408

REVISIONS:		
#	DATE	COMMENT

LEGEND:

- GUY WIRE
- POWER POLE
- HYDRANT
- SIGN
- WATER EDGE
- POWER OVERHEAD
- FENCE LINE
- BOUNDARY LINE
- PARCEL LINE
- ADJACENT PARCEL LINES
- APPROXIMATE LOCATION OF PARCEL LINES FROM TAX MAP
- EASEMENT LINES
- EXCEPTION TO PROJECT
- DRIVE
- ROAD
- WATER
- VEGETATION
- FOUND MONUMENT (SEE LABEL)
- N/F NOW OR FORMERLY
- COR CORNER
- IP IRON PIPE
- IB IRON BAR
- RB REBAR

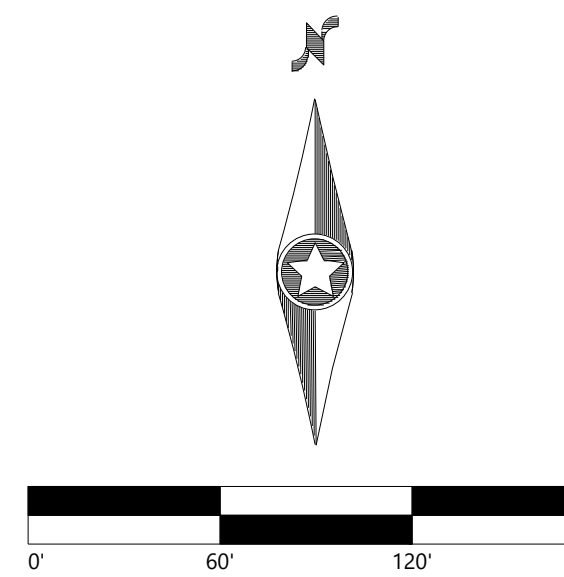

BEARING AND DISTANCES SHOWN HEREON ARE BASED ON NEW STATE PLANE COORDINATE SYSTEM, NAD1983(2011), NEW YORK WEST ZONE, US SURVEY FOOT. DISTANCES AND AREAS HAVE BEEN SCALED TO GROUND VALUES BY APPLYING A SCALE FACTOR OF 1.0000416. BEARINGS SHOWN HEREON ARE GRID NORTH.

EXCELSIOR
SOLAR PROJECT
GENESEE COUNTY, NEW YORK

RECORD OF SURVEY

DATE: 11/03/2020

SHEET: 07A of 18

PREPARED FOR:




PO Box 88808
North Palm Beach, FL 33408

REVISIONS:		
#	DATE	COMMENT

LEGEND:

- GUY WIRE
- POWER POLE
- HYDRANT
- SIGN
- WATER EDGE
- POWER OVERHEAD
- FENCE LINE
- BOUNDARY LINE
- PARCEL LINE
- ADJACENT PARCEL LINES
- APPROXIMATE LOCATION OF PARCEL LINES FROM TAX MAP
- EASEMENT LINES
- EXCEPTION TO PROJECT
- DRIVE
- ROAD
- WATER
- VEGETATION
- FOUND MONUMENT (SEE LABEL)
- N/F NOW OR FORMERLY
- COR CORNER
- IP IRON PIPE
- IB IRON BAR
- RB REBAR

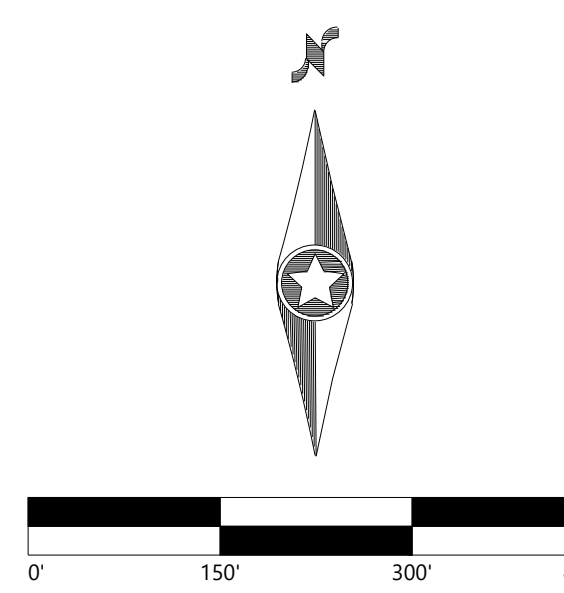

BEARING AND DISTANCES SHOWN HEREON ARE BASED ON NEW STATE PLANE COORDINATE SYSTEM, NAD1983(2011), NEW YORK WEST ZONE, US SURVEY FOOT. DISTANCES AND AREAS HAVE BEEN SCALED TO GROUND VALUES BY APPLYING A SCALE FACTOR OF 1.0000416. BEARINGS SHOWN HEREON ARE GRID NORTH.


EXCELSIOR
SOLAR PROJECT
GENESEE COUNTY, NEW YORK

RECORD OF SURVEY


DATE: 11/03/2020

SHEET: 08 of 18


SHEET 04

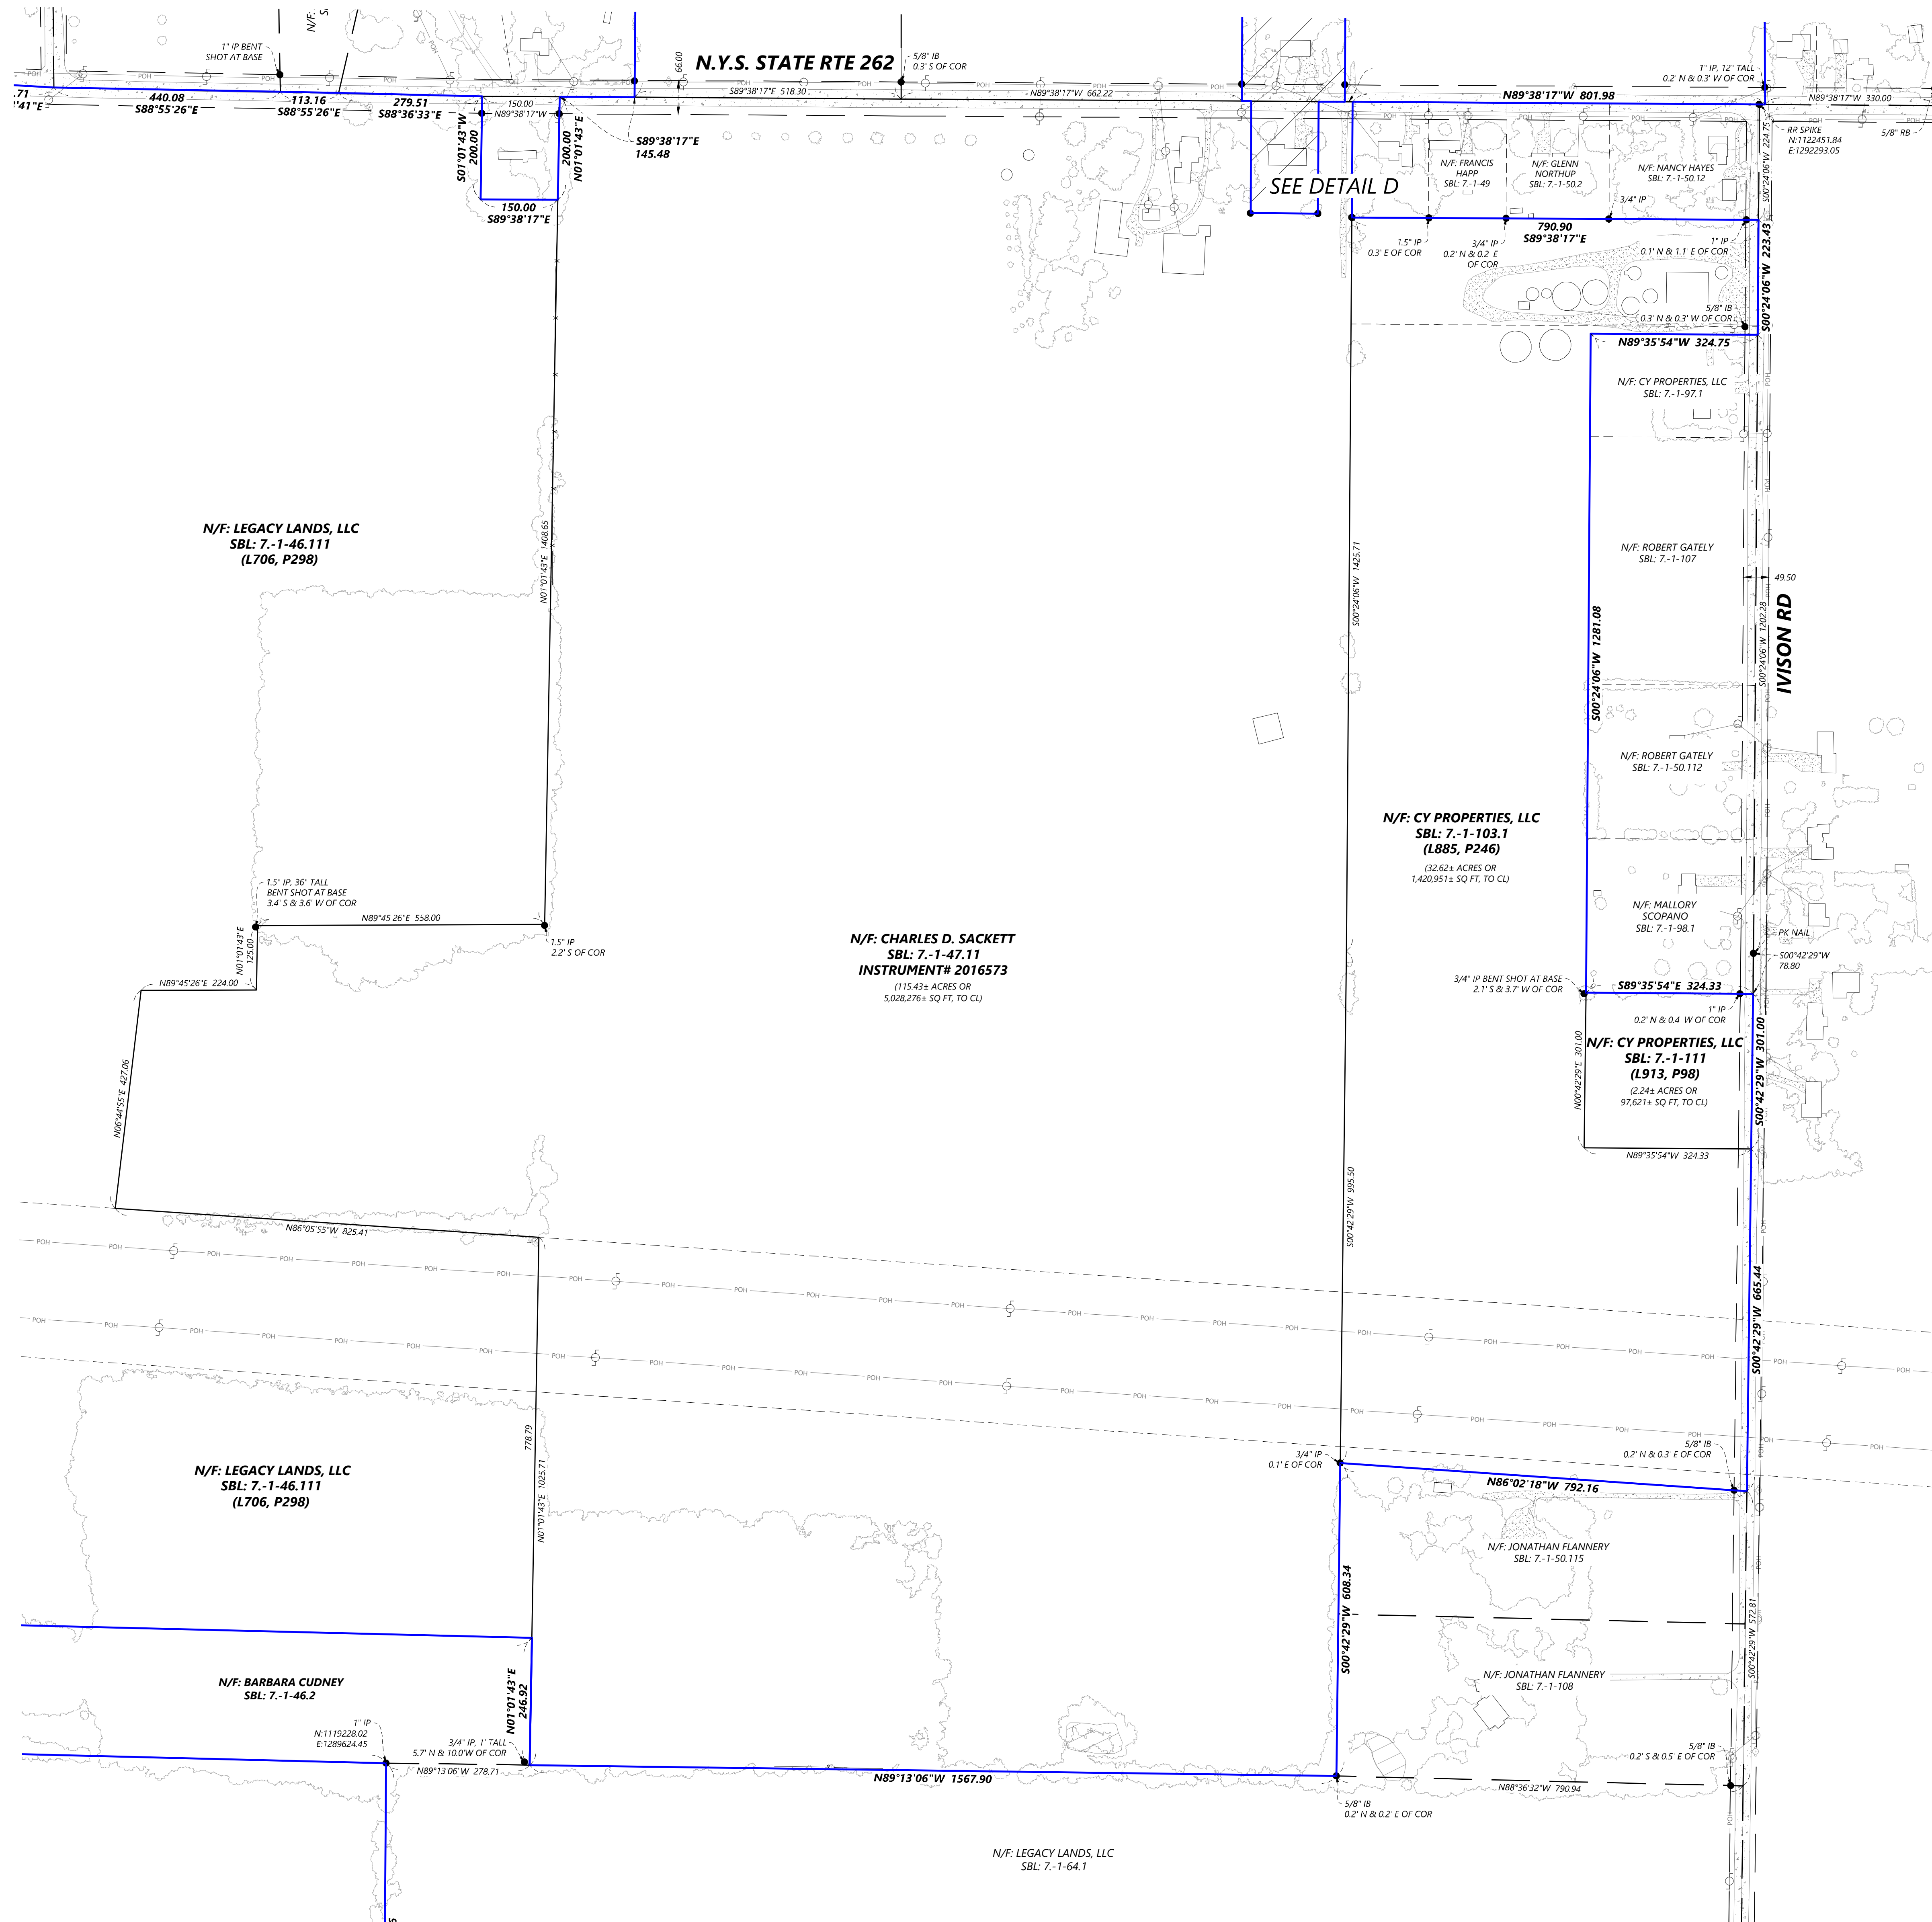


KEYMAP:

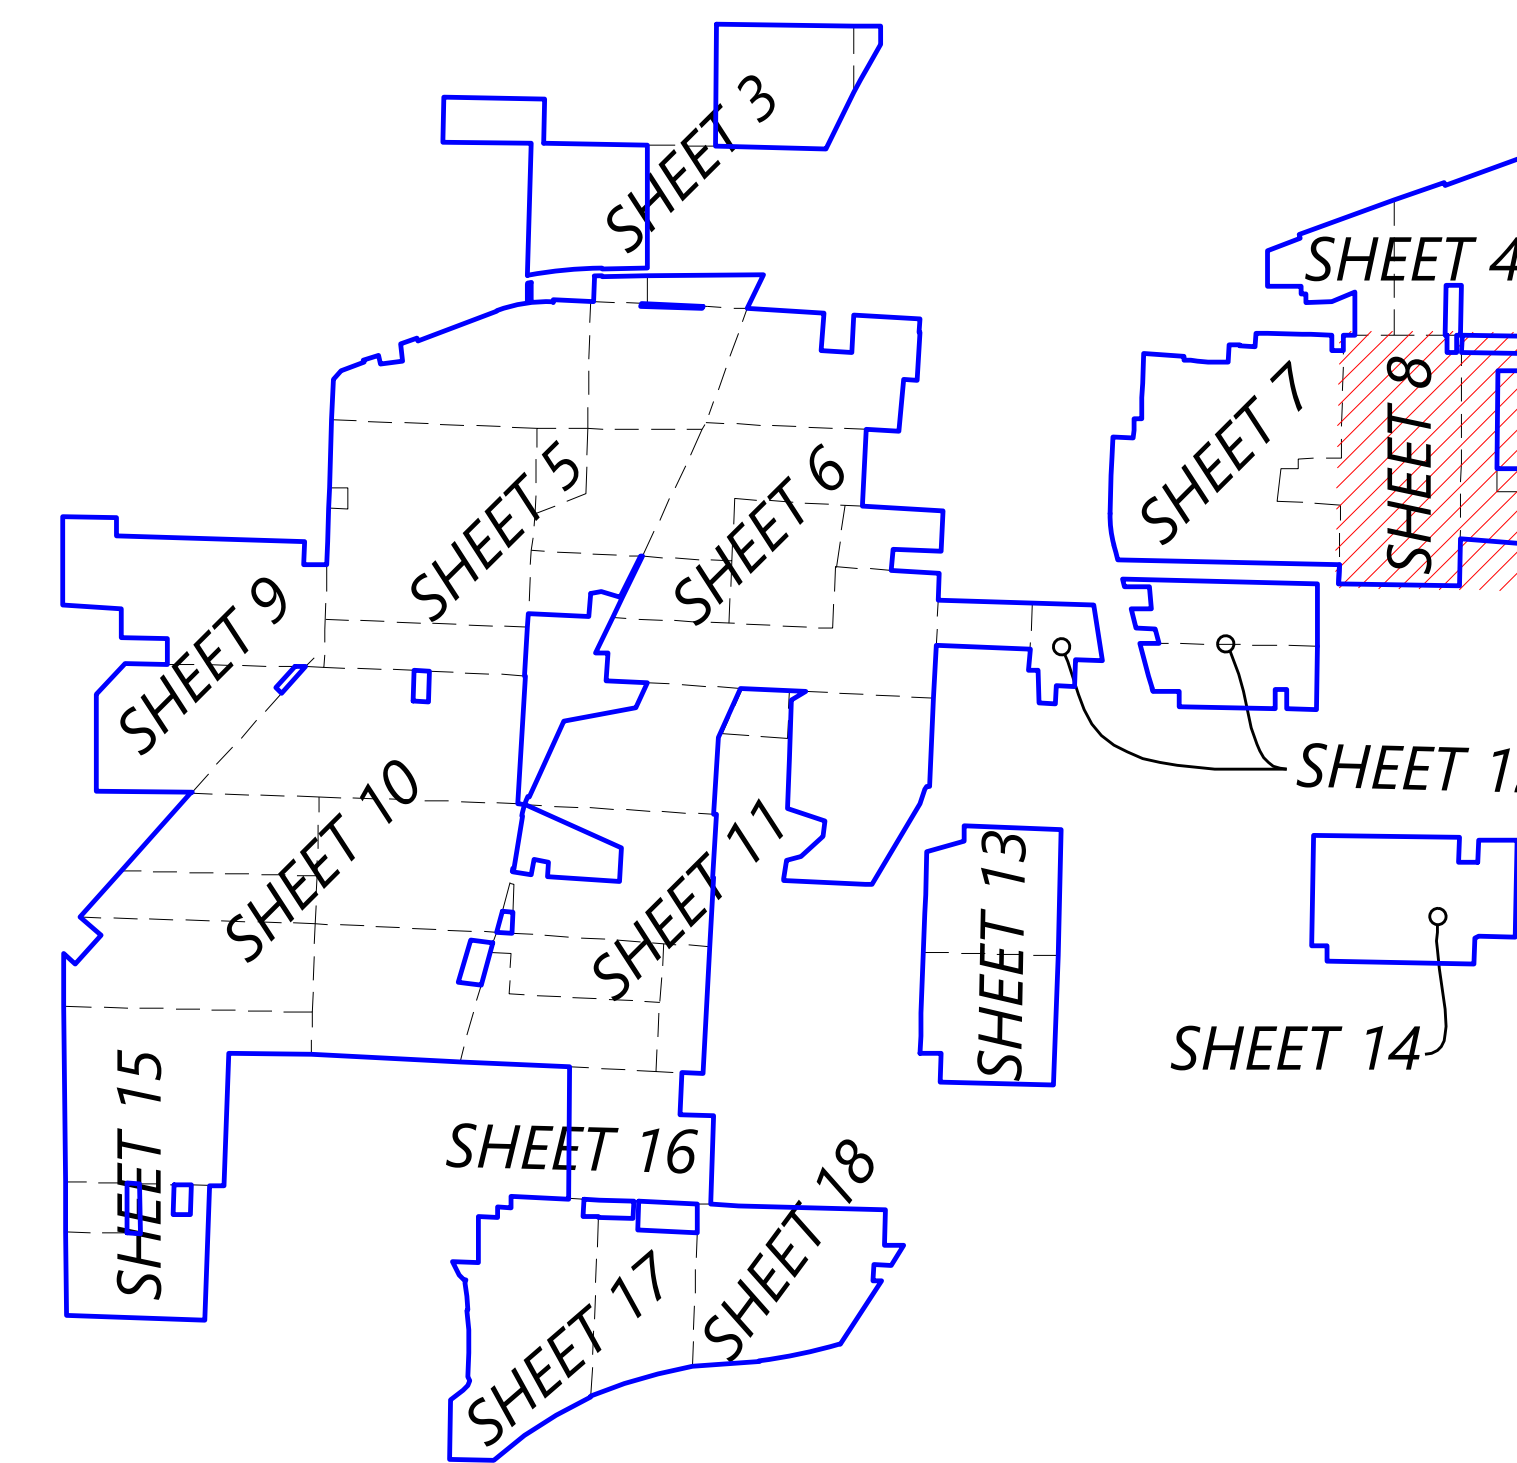


DETAIL D

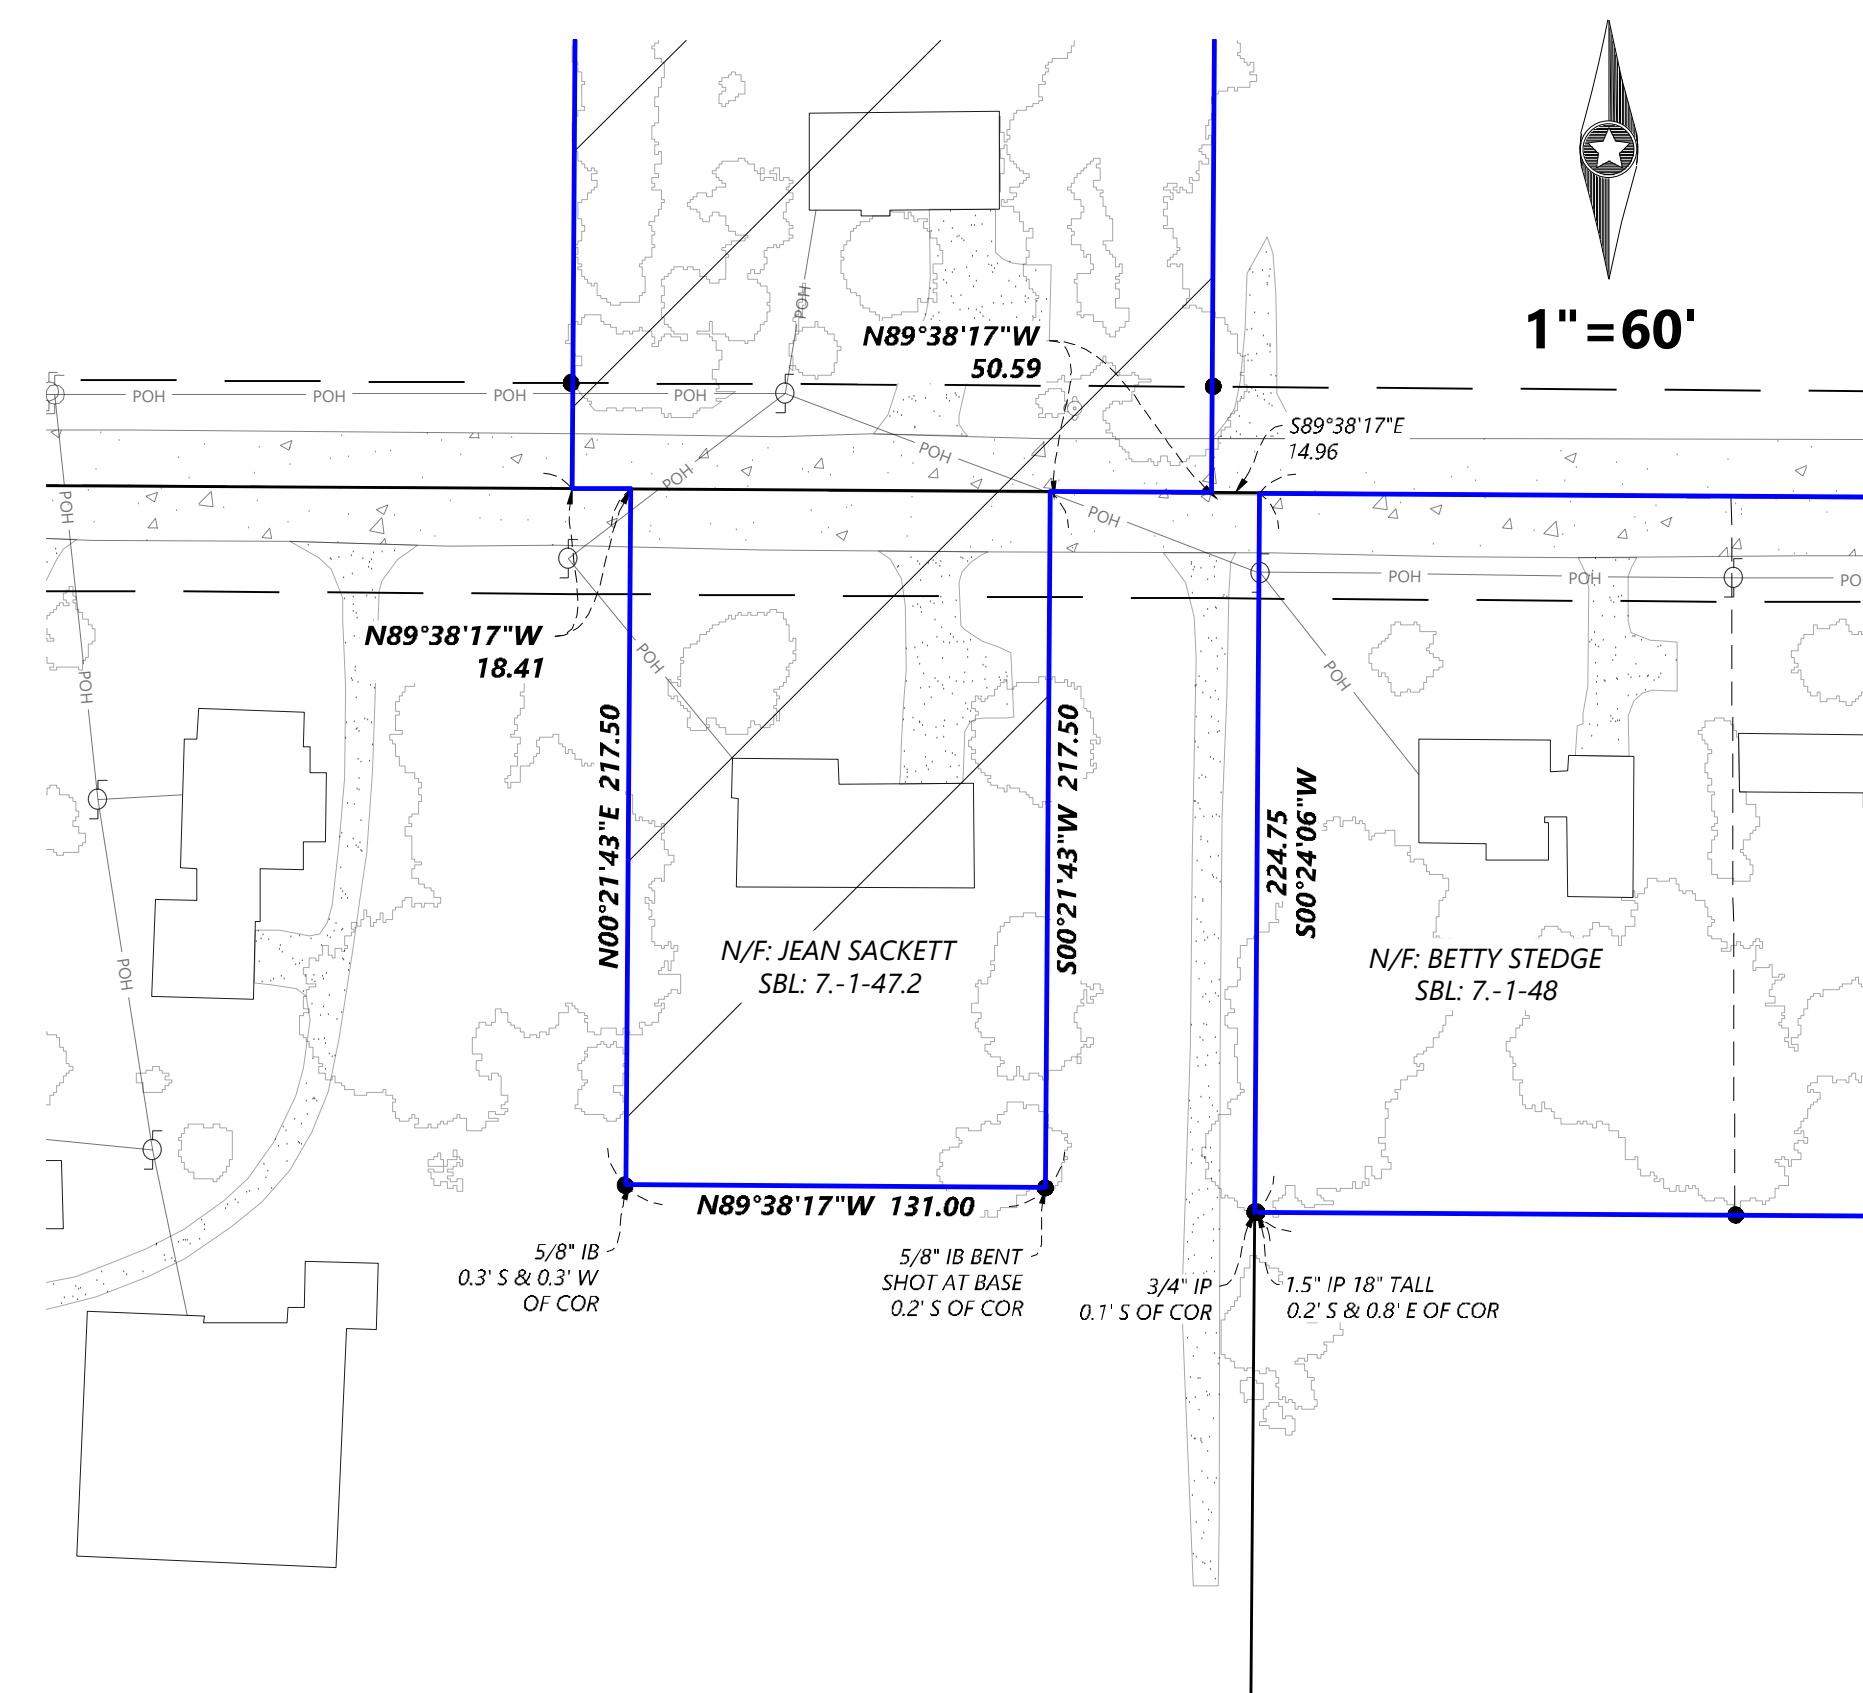


SHEET 07

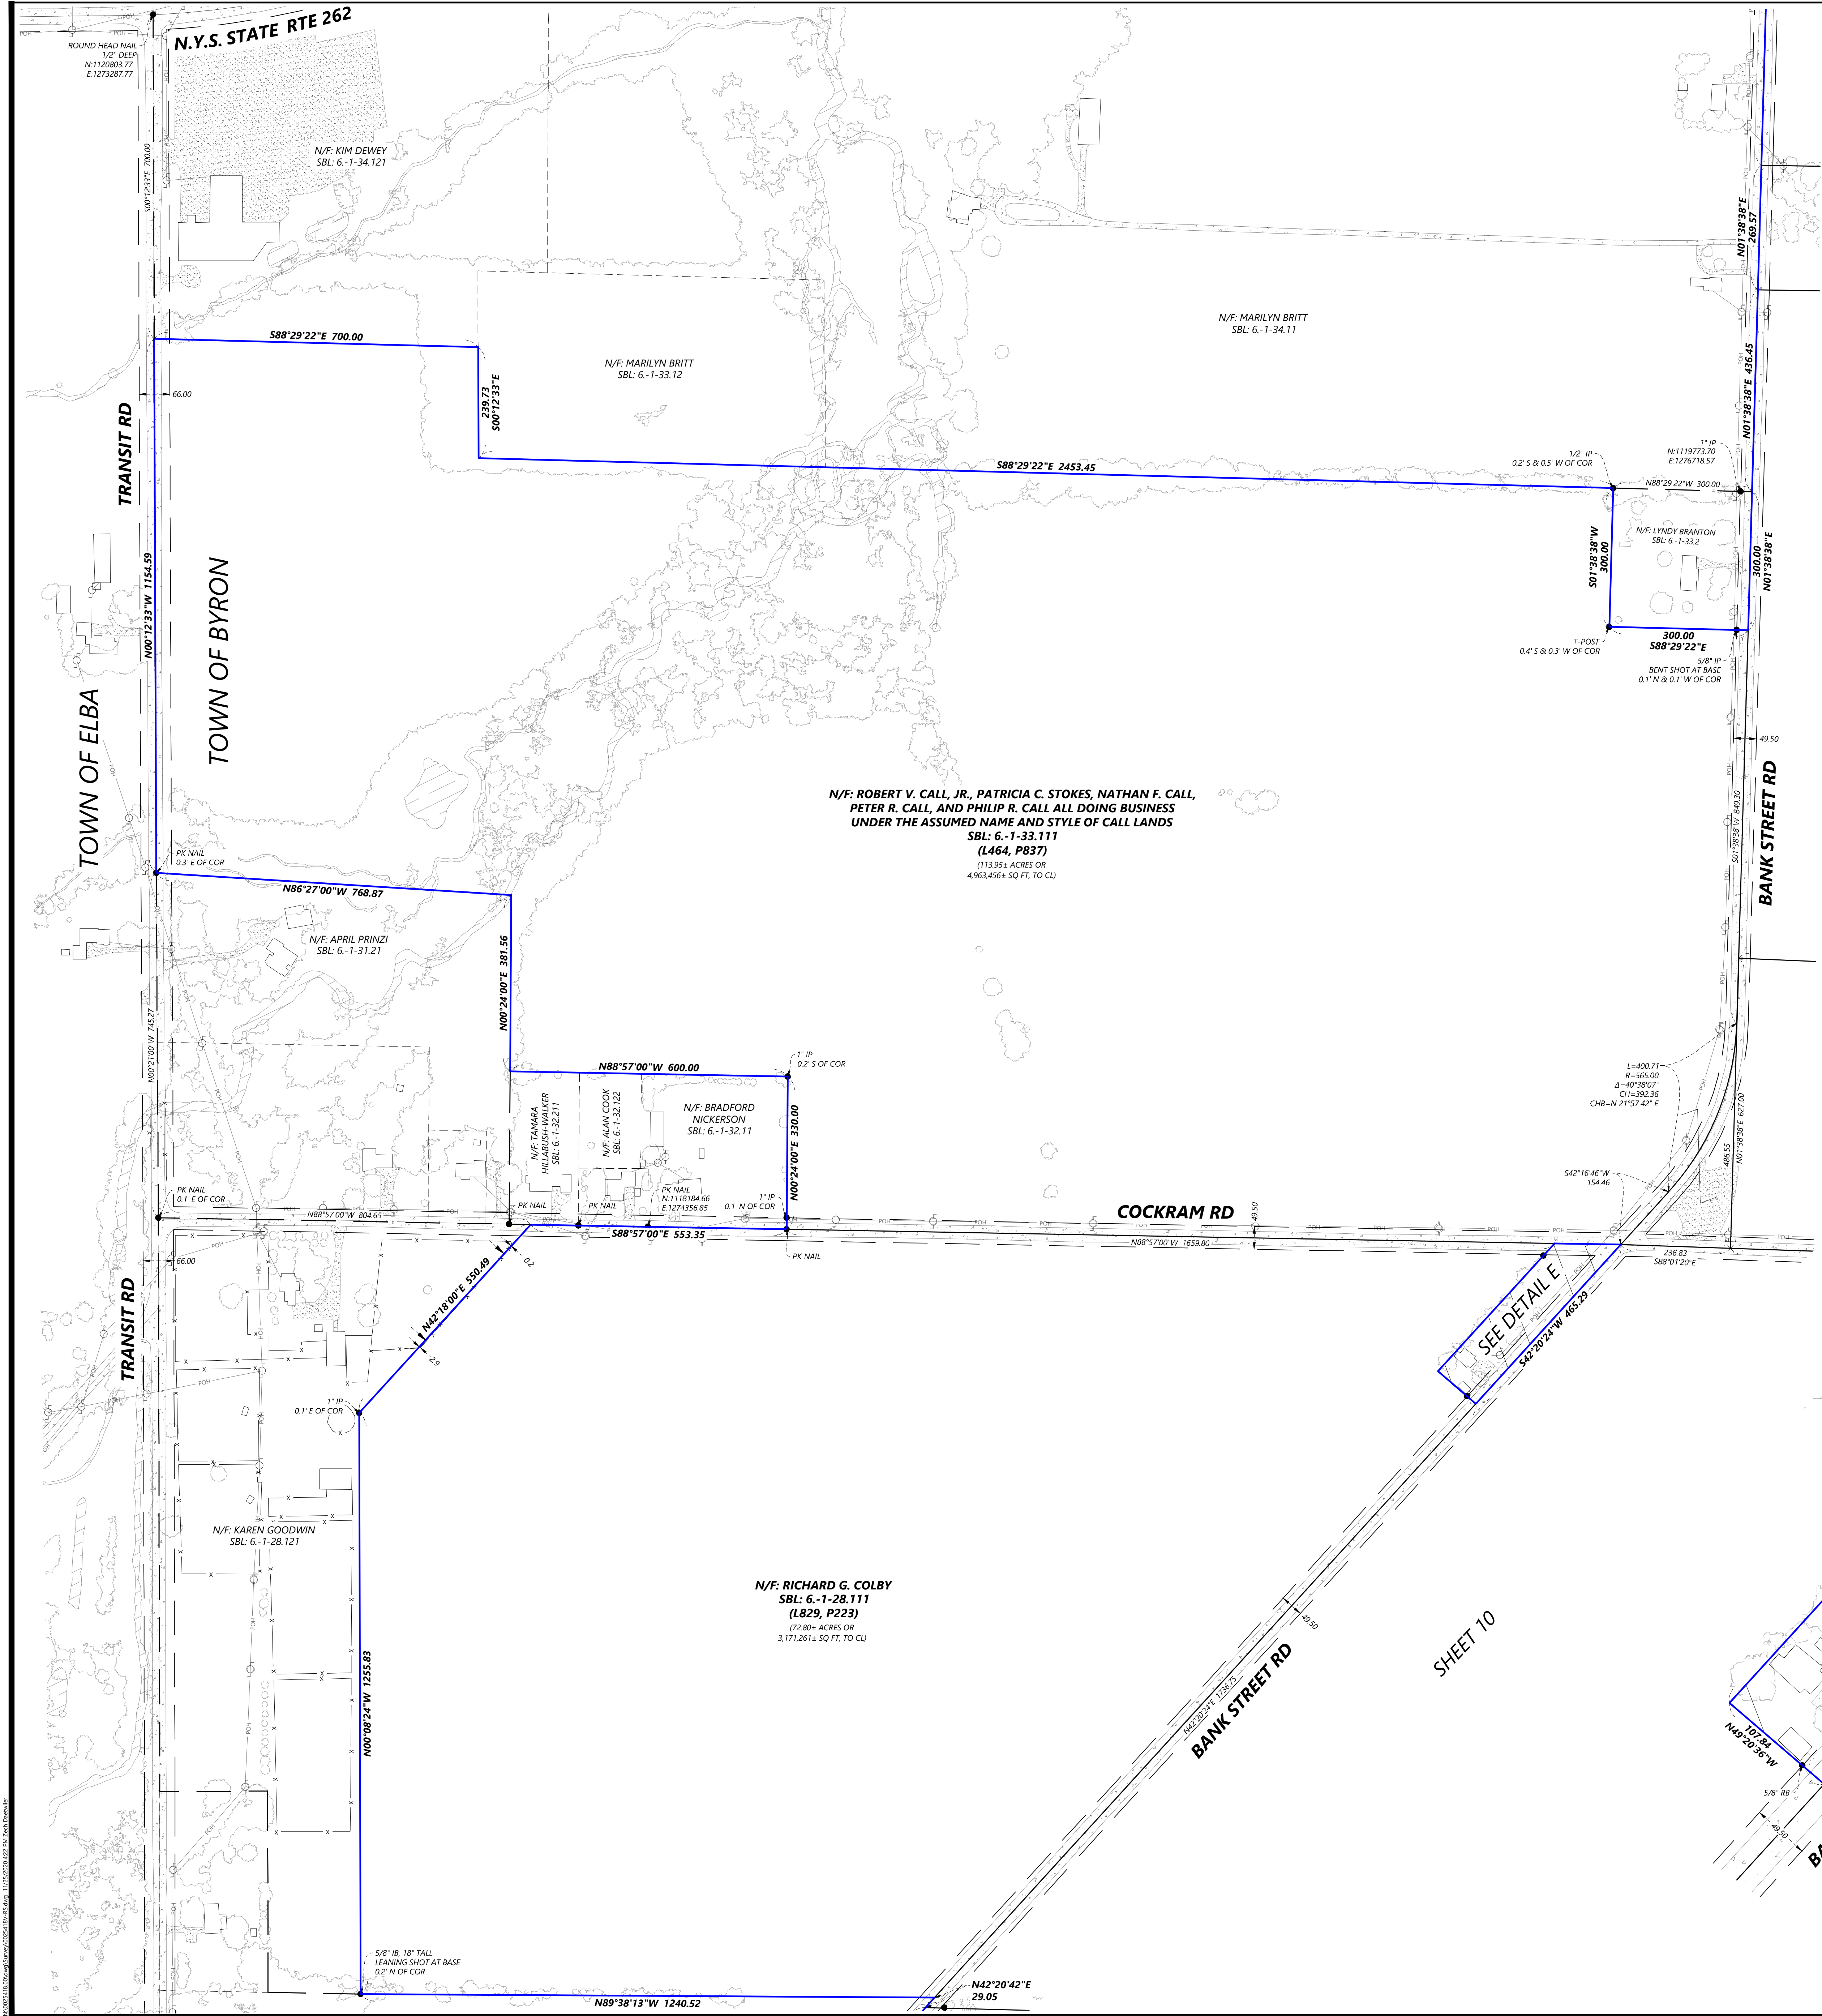

KEYMAP:

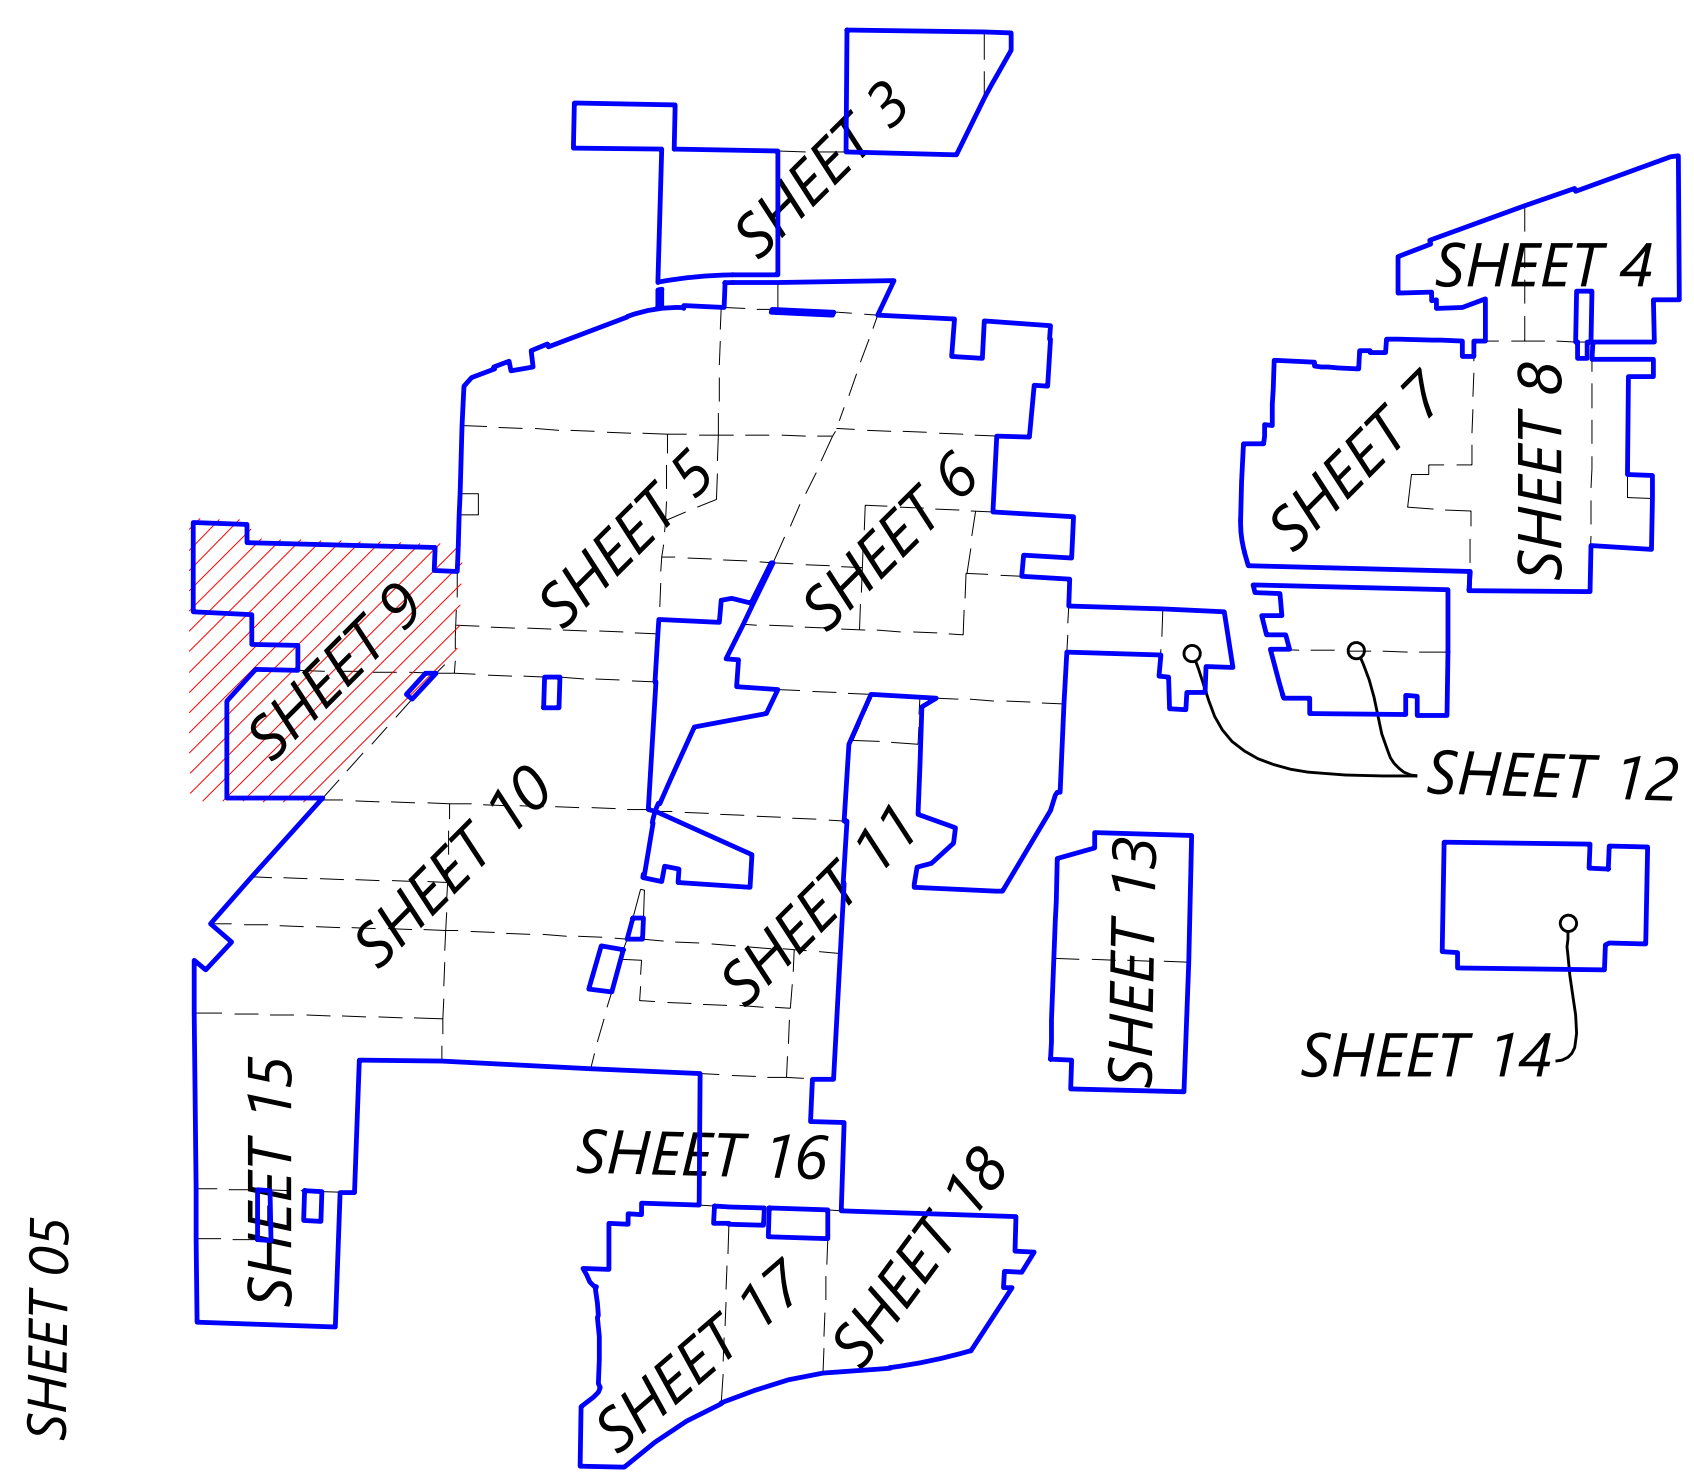

DETAIL E

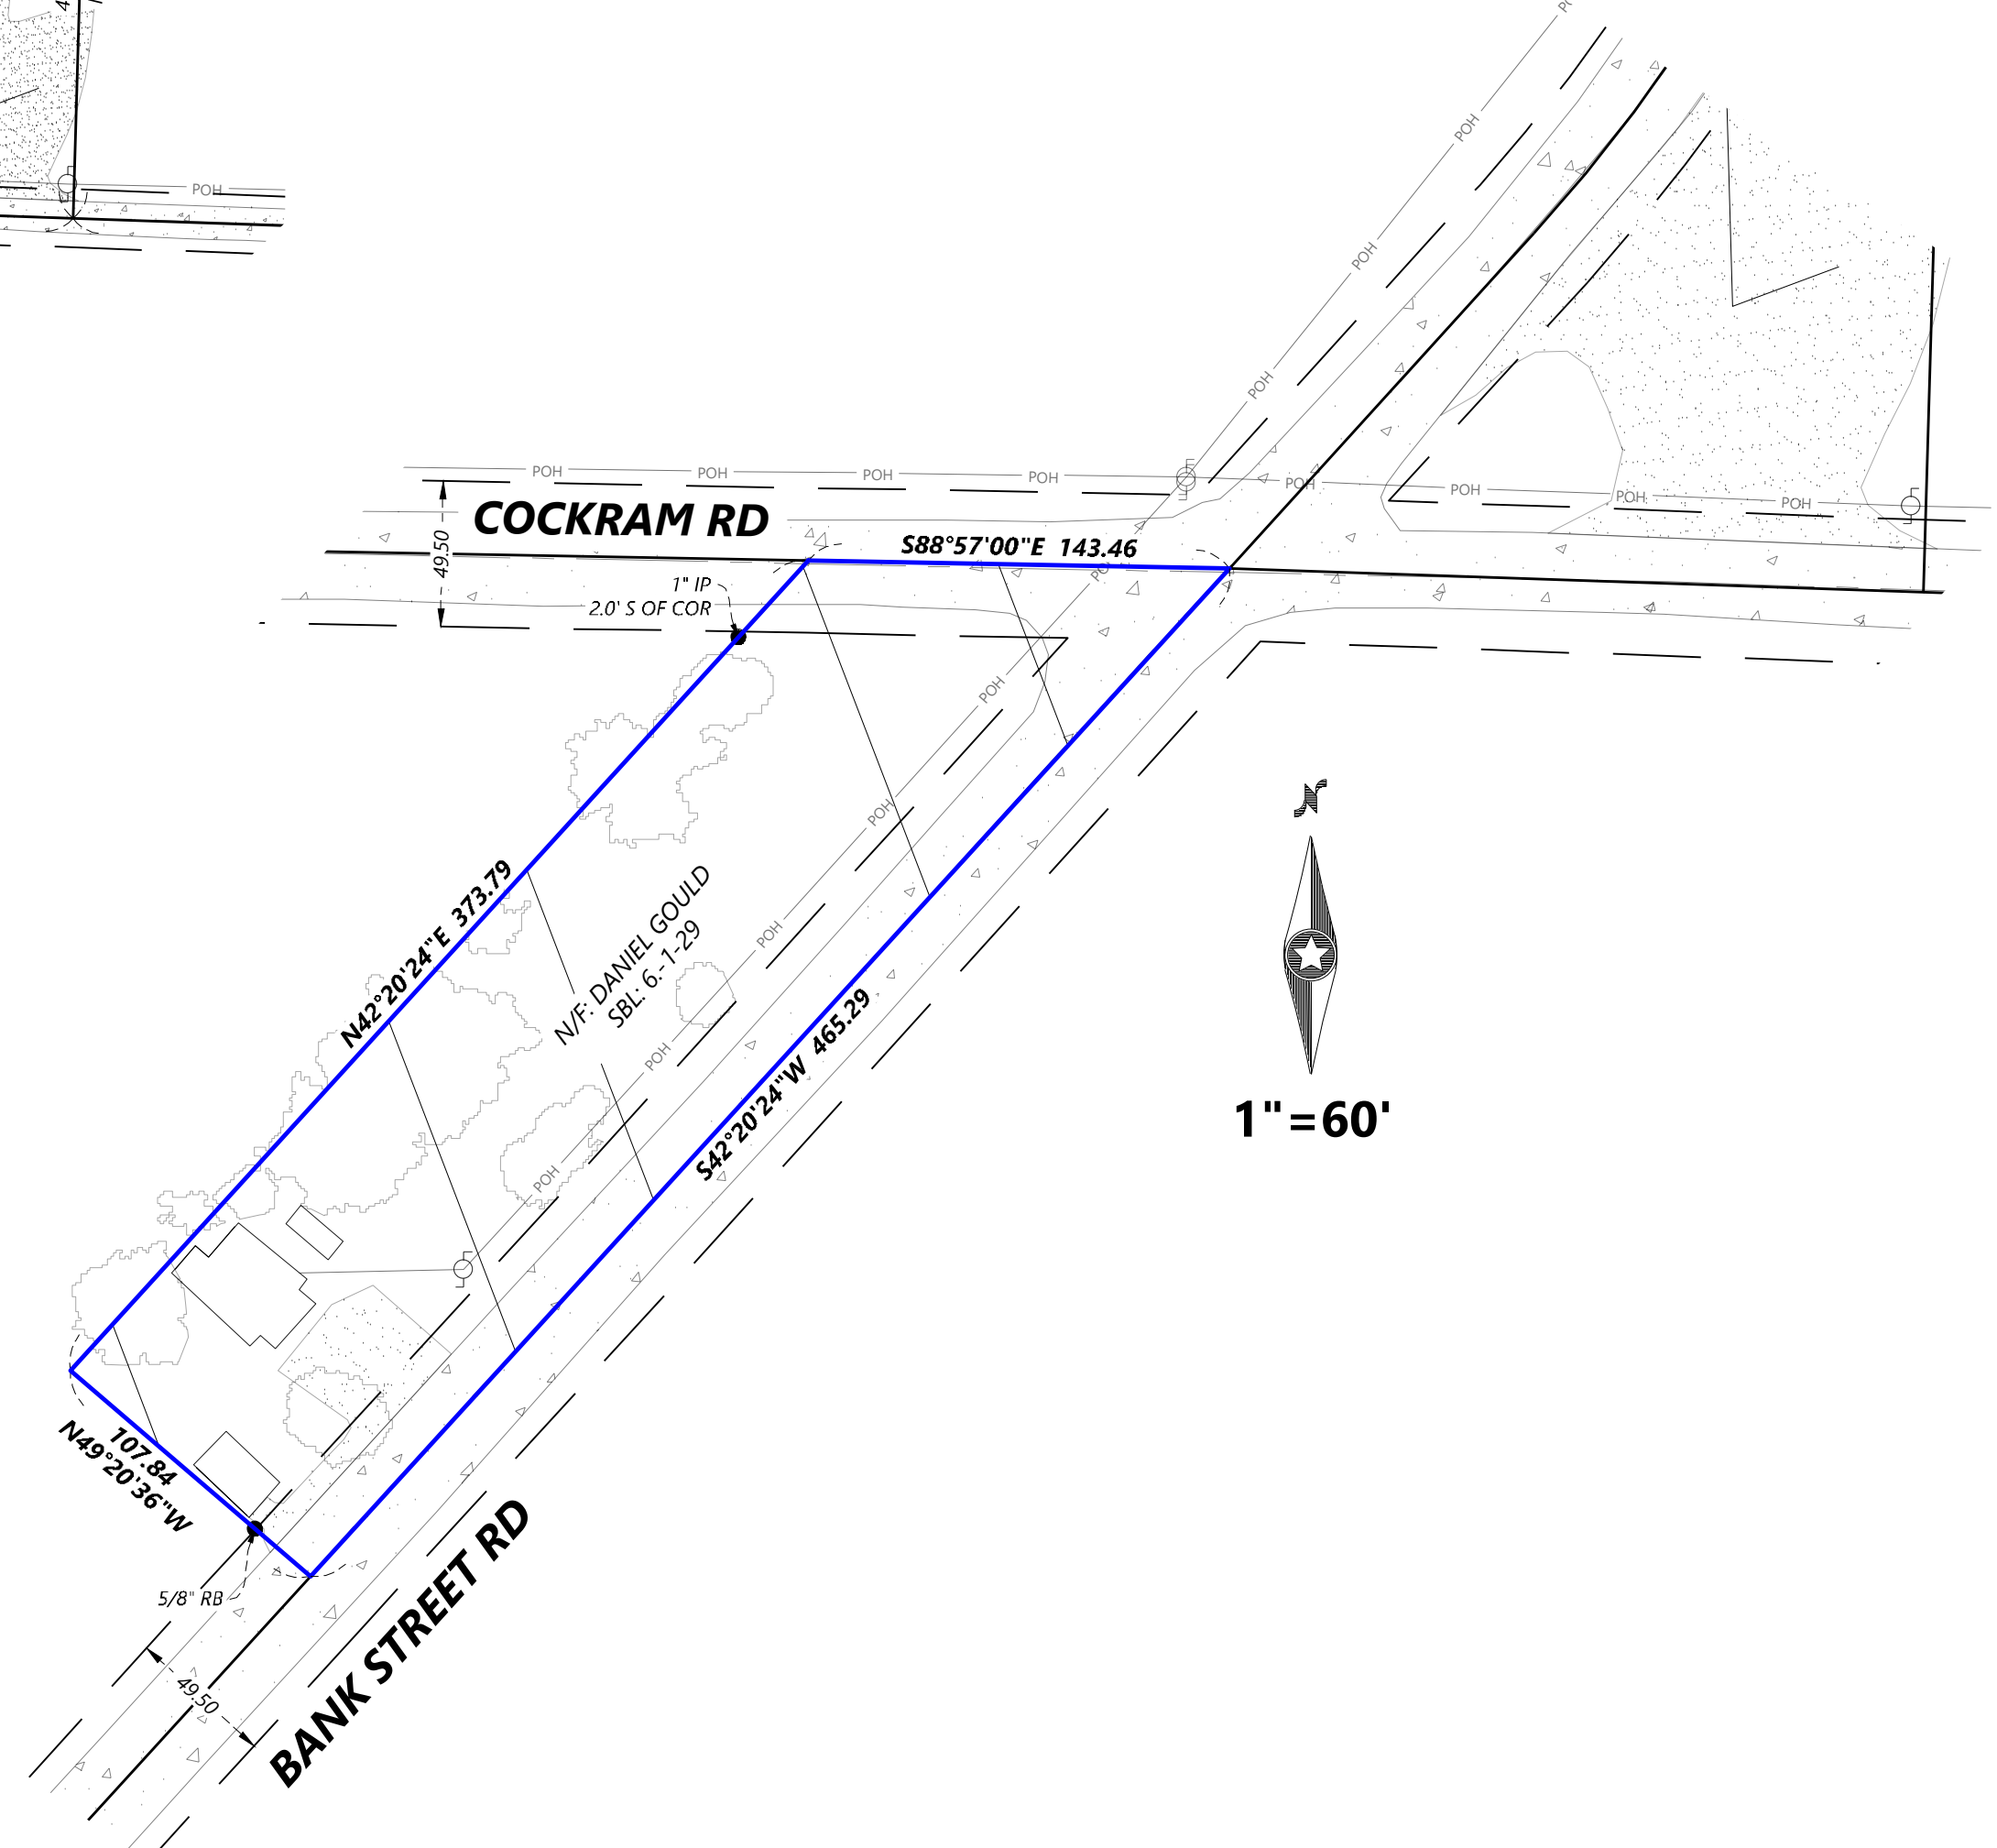

PREPARED FOR:




PO Box 88808
North Palm Beach, FL 33408

REVISIONS:		
#	DATE	COMMENT

LEGEND:

- GUY WIRE
- POWER POLE
- HYDRANT
- SIGN
- WATER EDGE
- POWER OVERHEAD
- FENCE LINE
- BOUNDARY LINE
- PARCEL LINE
- ADJACENT PARCEL LINES
- APPROXIMATE LOCATION OF PARCEL LINES FROM TAX MAP
- EASEMENT LINES
- EXCEPTION TO PROJECT
- DRIVE
- ROAD
- WATER
- VEGETATION
- FOUND MONUMENT (SEE LABEL)
- N/F. NOW OR FORMERLY
- COR. CORNER
- IP. IRON PIPE
- IB. IRON BAR
- RB. REBAR

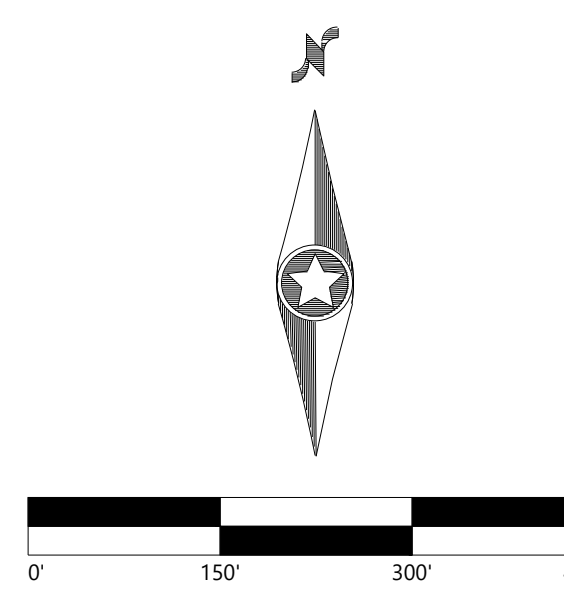

BEARING AND DISTANCES SHOWN HEREON ARE BASED ON NEW STATE PLANE COORDINATE SYSTEM, NAD1983(2011), NEW YORK WEST ZONE, US SURVEY FOOT. DISTANCES AND AREAS HAVE BEEN SCALED TO GROUND VALUES BY APPLYING A SCALE FACTOR OF 1.0000416. BEARINGS SHOWN HEREON ARE GRID NORTH.



EXCELSIOR
SOLAR PROJECT
GENESEE COUNTY, NEW YORK

RECORD OF SURVEY

DATE: 11/03/2020

SHEET: 09 of 18

KEYMAP:

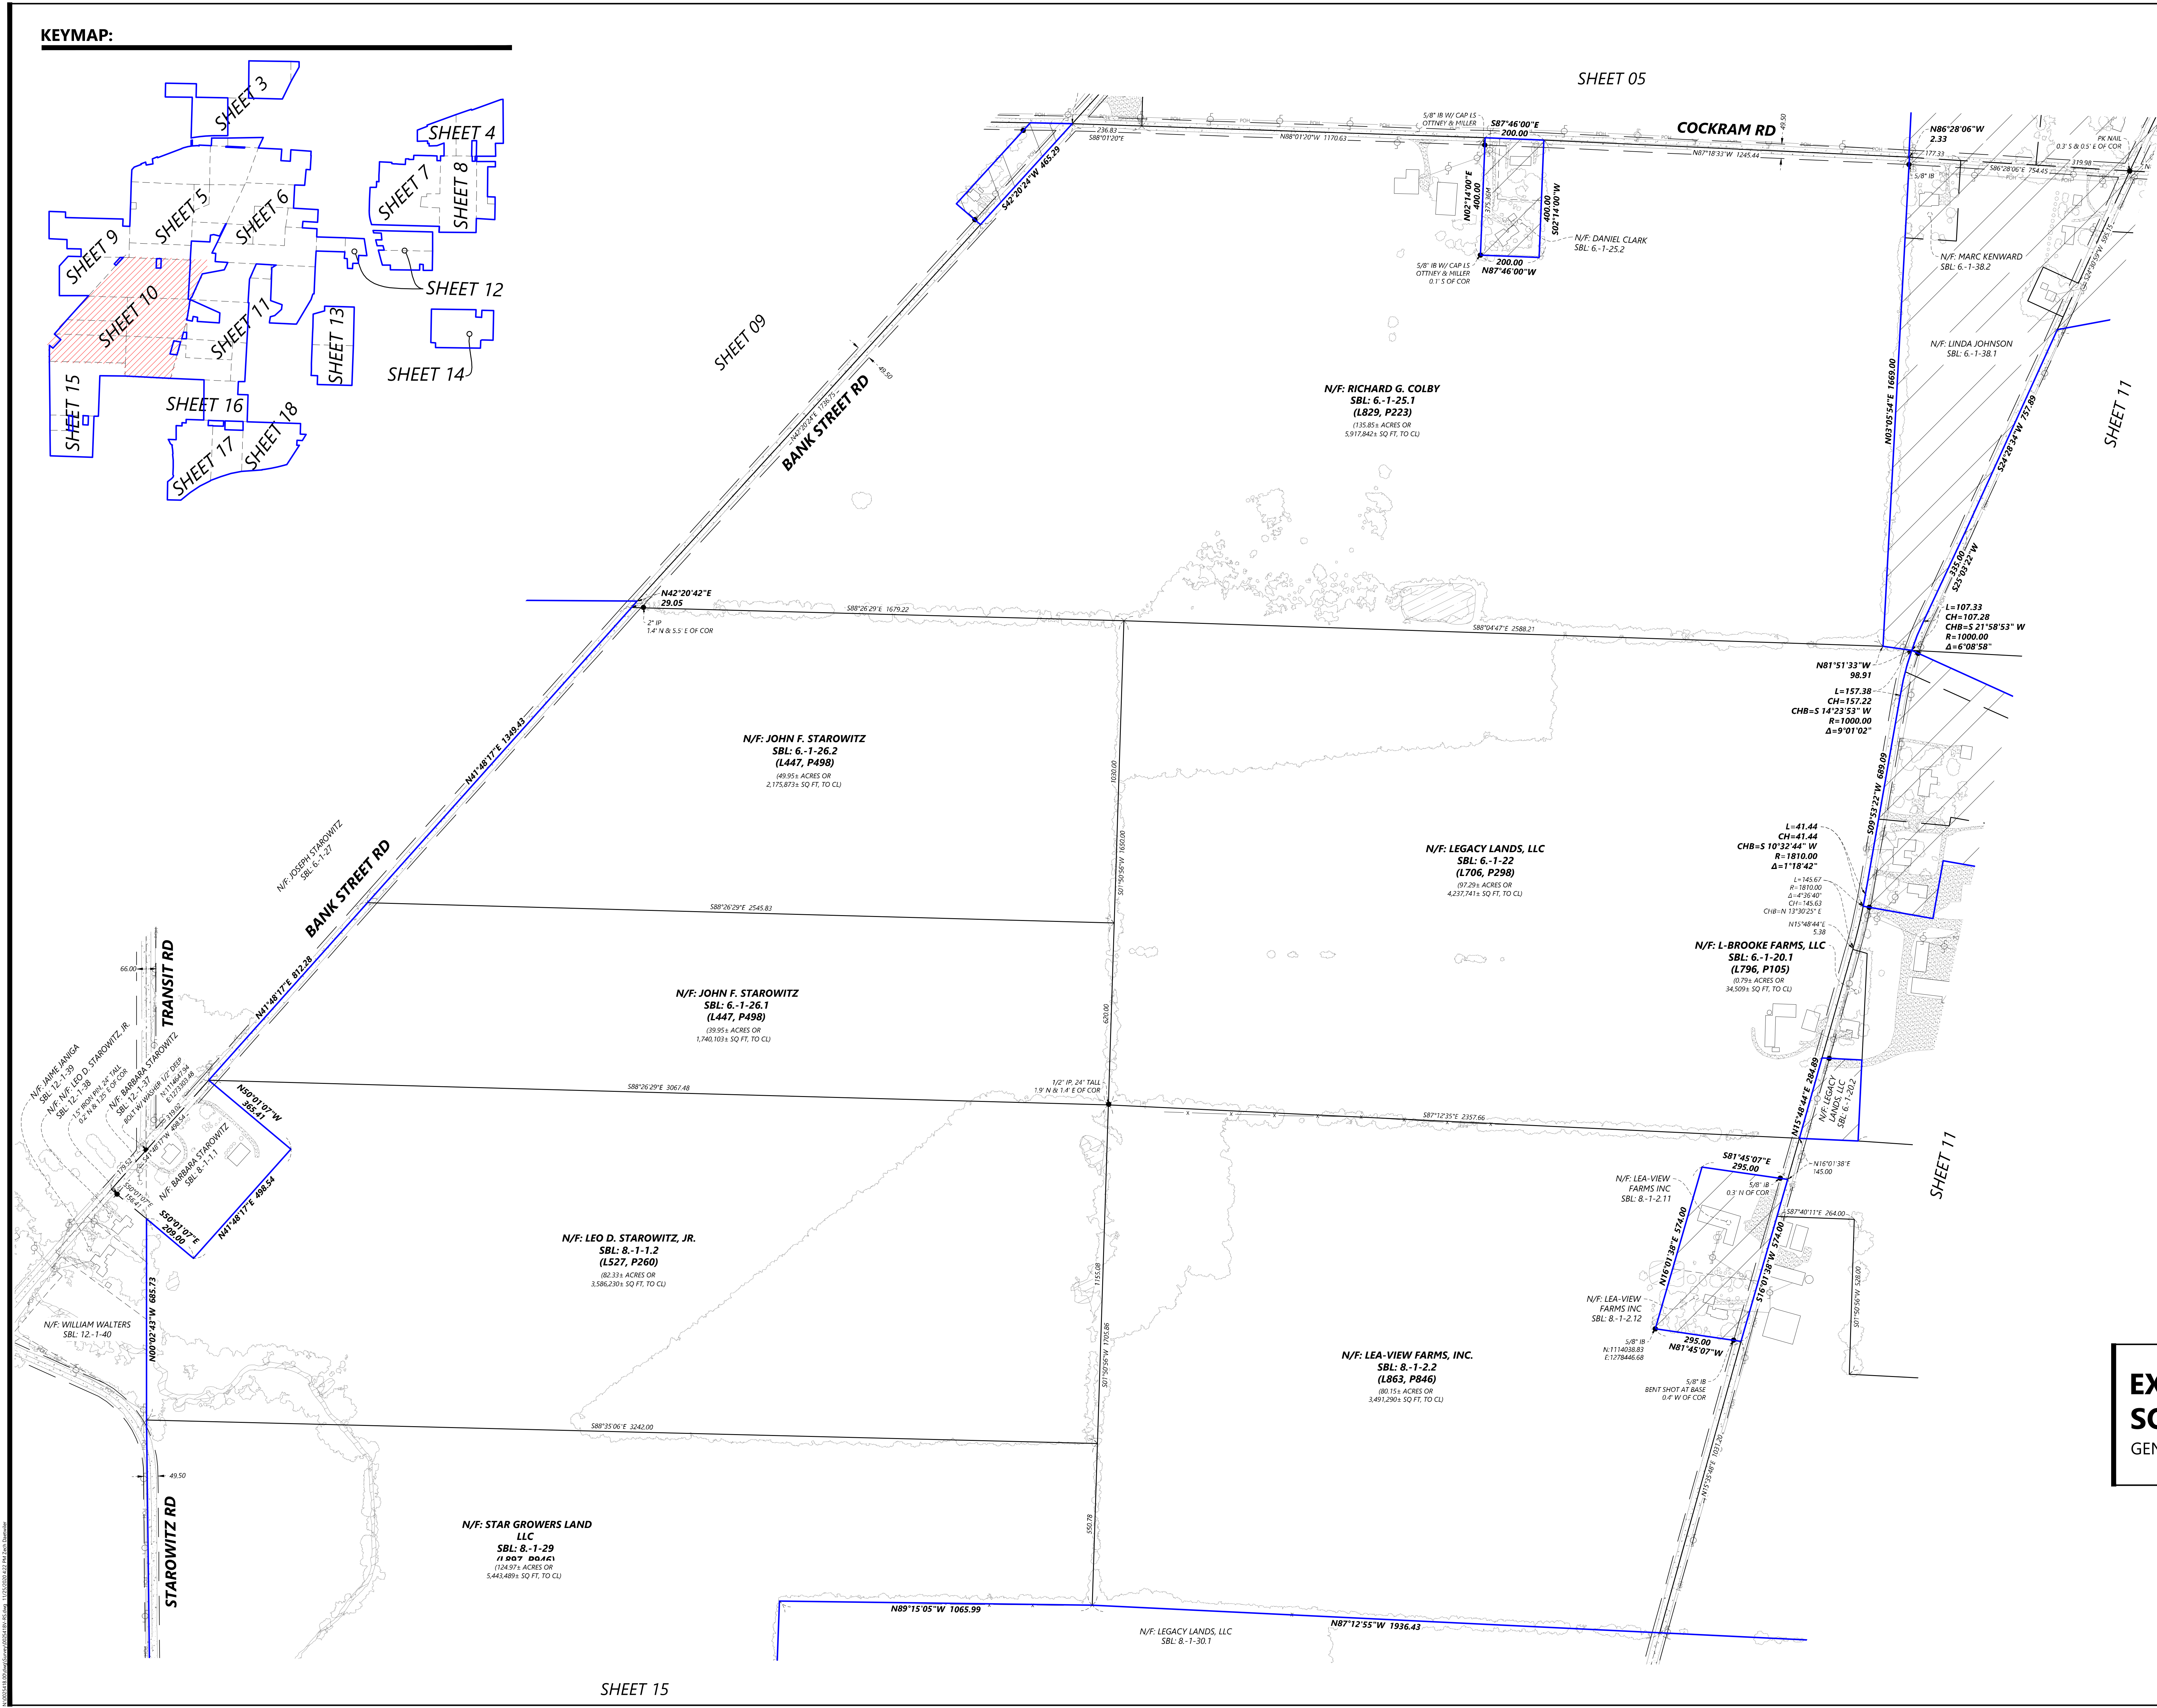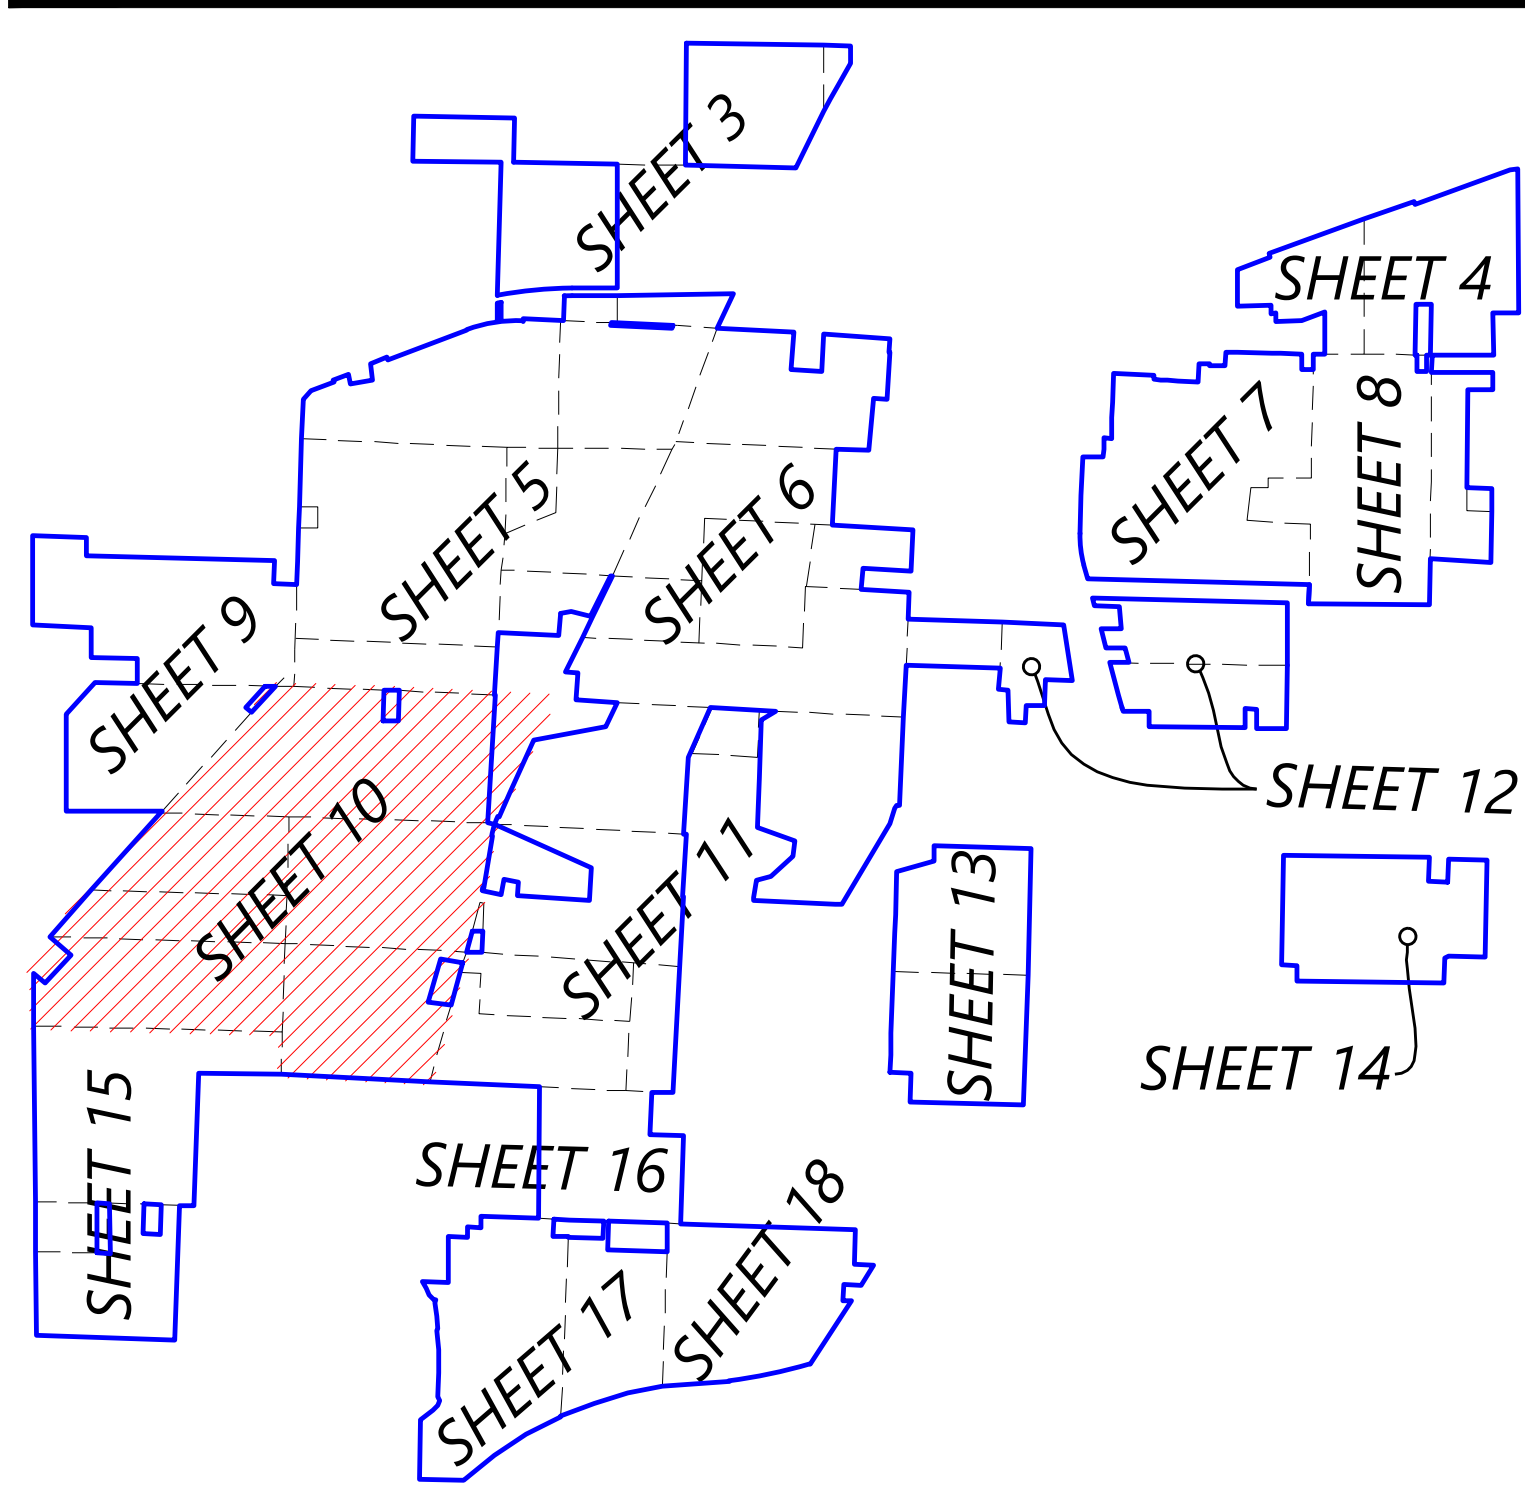

PREPARED FOR:




PO Box 88808
North Palm Beach, FL 33408

REVISIONS:		
#	DATE	COMMENT

LEGEND:

- GUY WIRE
- POWER POLE
- HYDRANT
- SIGN
- WATER EDGE
- POWER OVERHEAD
- FENCE LINE
- BOUNDARY LINE
- PARCEL LINE
- ADJACENT PARCEL LINES
- APPROXIMATE LOCATION OF PARCEL LINES FROM TAX MAP
- EASEMENT LINES
- EXCEPTION TO PROJECT
- DRIVE
- ROAD
- WATER
- VEGETATION
- FOUND MONUMENT (SEE LABEL)
- N/F NOW OR FORMERLY
- COR CORNER
- IP IRON PIPE
- IB IRON BAR
- RB REBAR

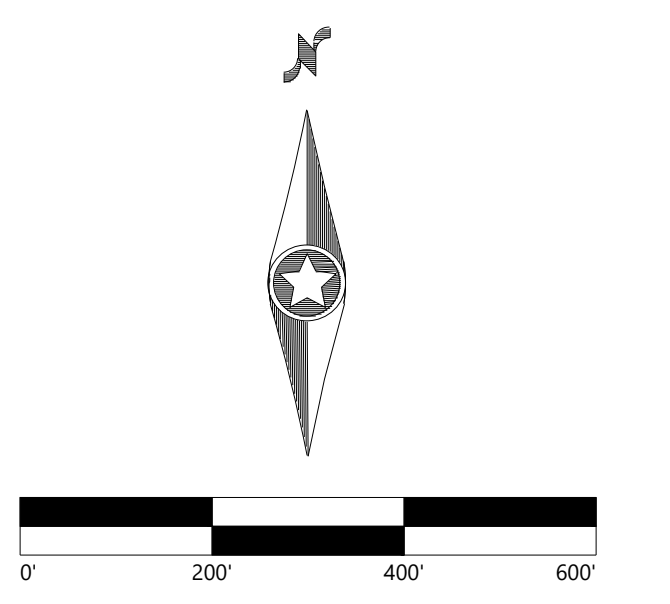



BEARING AND DISTANCES SHOWN HEREON ARE BASED ON NEW STATE PLANE COORDINATE SYSTEM, NAD1983(2011), NEW YORK WEST ZONE, US SURVEY FOOT. DISTANCES AND AREAS HAVE BEEN SCALED TO GROUND VALUES BY APPLYING A SCALE FACTOR OF 1.0000416. BEARINGS SHOWN HEREON ARE GRID NORTH.

EXCELSIOR
SOLAR PROJECT
GENESSEE COUNTY, NEW YORK

RECORD OF SURVEY

DATE: 11/03/2020
SHEET: 10 of 18

KEYMAP:

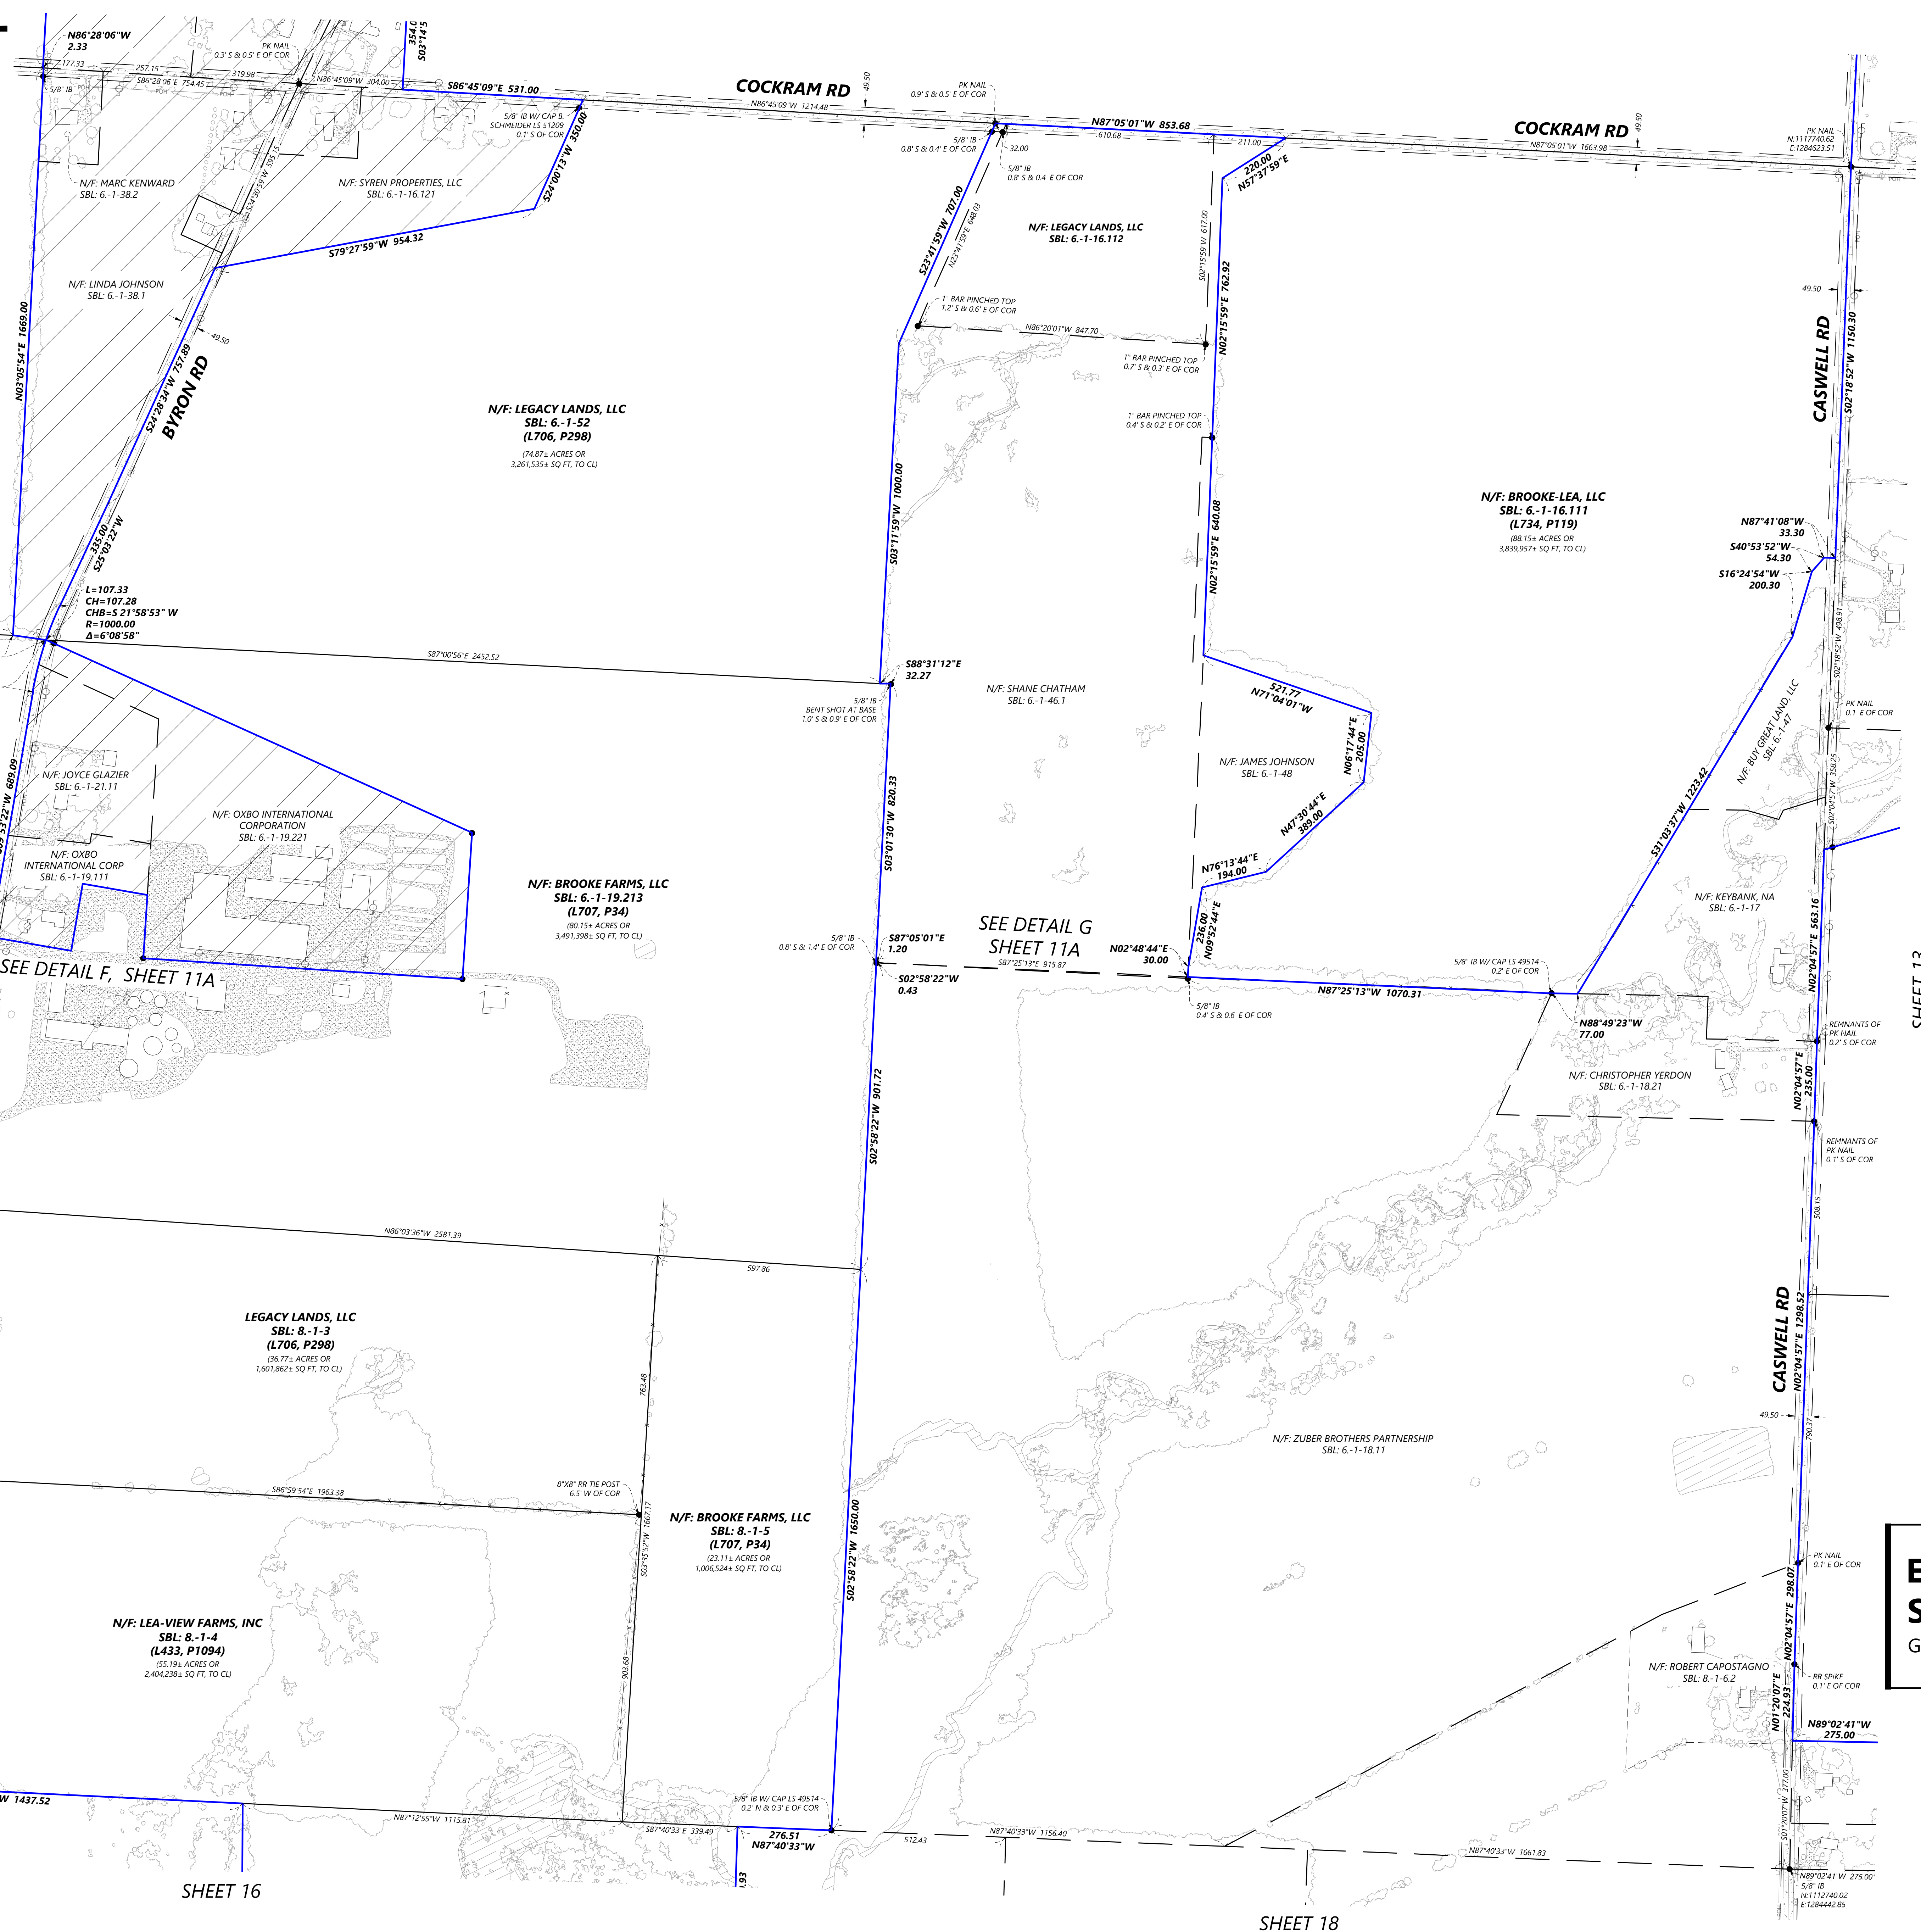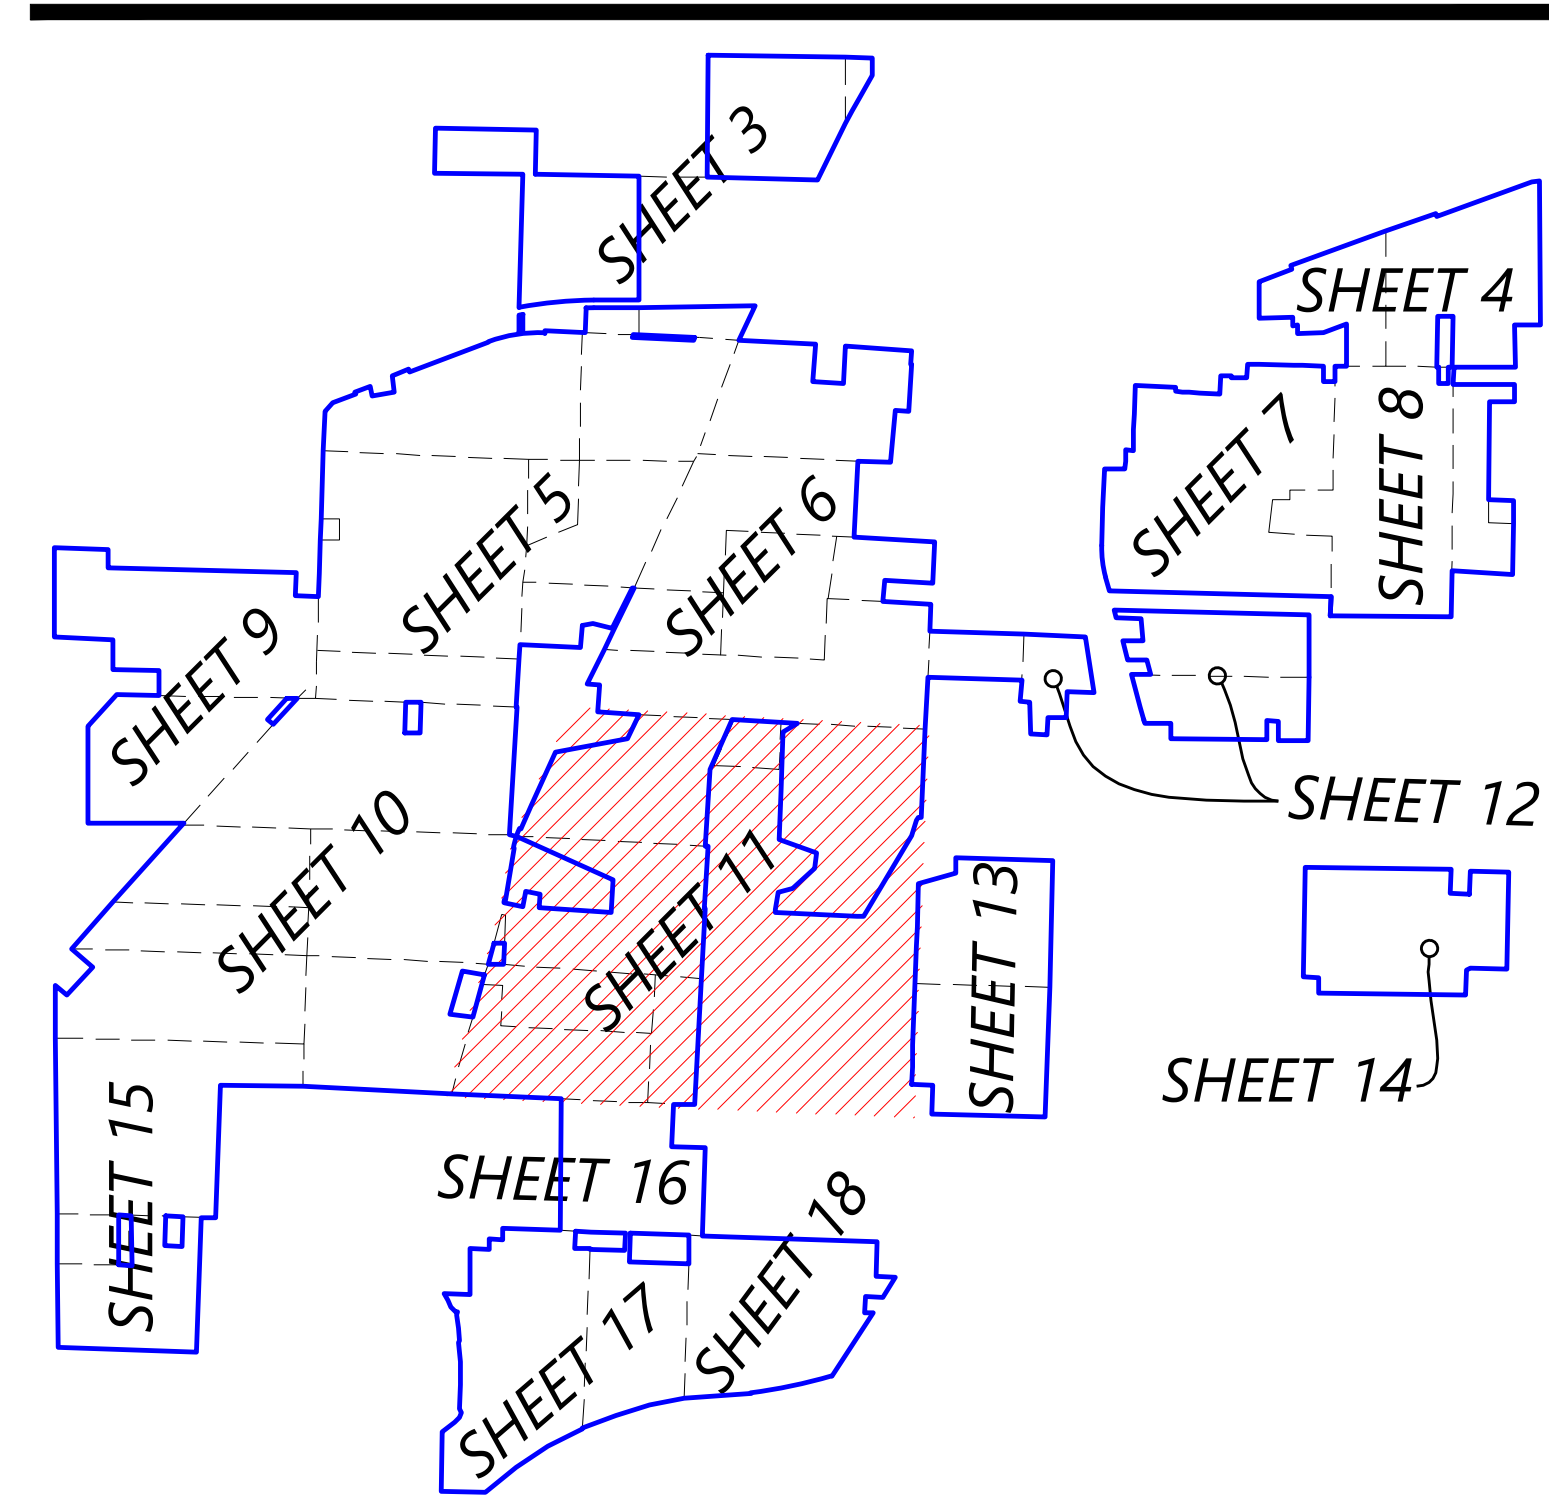

PREPARED FOR:




PO Box 88808
North Palm Beach, FL 33408

REVISIONS:		
#	DATE	COMMENT

LEGEND:

- GUY WIRE
- POWER POLE
- HYDRANT
- SIGN
- WATER EDGE
- POWER OVERHEAD
- FENCE LINE
- BOUNDARY LINE
- PARCEL LINE
- ADJACENT PARCEL LINES
- APPROXIMATE LOCATION OF PARCEL LINES FROM TAX MAP
- EASEMENT LINES
- EXCEPTION TO PROJECT
- DRIVE
- ROAD
- WATER
- VEGETATION
- FOUND MONUMENT (SEE LABEL)
- N/F: NOW OR FORMERLY
- COR: CORNER
- IP: IRON PIPE
- IB: IRON BAR
- RB: REBAR

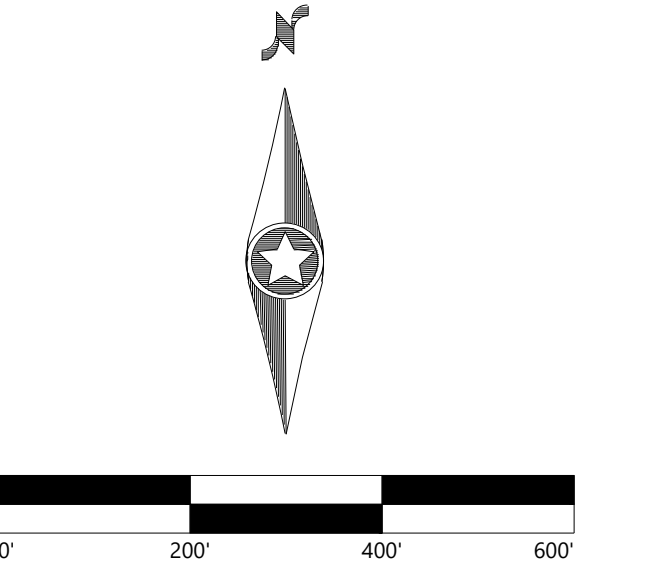

BEARING AND DISTANCES SHOWN HEREON ARE BASED ON NEW STATE PLANE COORDINATE SYSTEM, NAD1983(2011), NEW YORK WEST ZONE, US SURVEY FOOT. DISTANCES AND AREAS HAVE BEEN SCALED TO GROUND VALUES BY APPLYING A SCALE FACTOR OF 1.0000416. BEARINGS SHOWN HEREON ARE GRID NORTH.

EXCELSIOR
SOLAR PROJECT
GENESEE COUNTY, NEW YORK

RECORD OF SURVEY

DATE: 11/03/2020
SHEET: 11 of 18

PREPARED FOR:



PO Box 88808
North Palm Beach, FL 33408

REVISIONS:		
#	DATE	COMMENT

LEGEND:

- GUY WIRE
- POWER POLE
- HYDRANT
- SIGN
- WATER EDGE
- POWER OVERHEAD
- FENCE LINE
- BOUNDARY LINE
- PARCEL LINE
- ADJACENT PARCEL LINES
- APPROXIMATE LOCATION OF PARCEL LINES FROM TAX MAP
- EASEMENT LINES
- EXCEPTION TO PROJECT
- DRIVE
- ROAD
- WATER
- VEGETATION
- FOUND MONUMENT (SEE LABEL)
- N/F NOW OR FORMERLY
- COR CORNER
- IP IRON PIPE
- IB IRON BAR
- RB REBAR

BEARING AND DISTANCES SHOWN HEREON ARE BASED ON NEW STATE PLANE COORDINATE SYSTEM, NAD1983(2011), NEW YORK WEST ZONE, US SURVEY FOOT. DISTANCES AND AREAS HAVE BEEN SCALED TO GROUND VALUES BY APPLYING A SCALE FACTOR OF 1.0000416. BEARINGS SHOWN HEREON ARE GRID NORTH.


EXCELSIOR
SOLAR PROJECT
GENESSEE COUNTY, NEW YORK

RECORD OF SURVEY


DATE: 11/03/2020

SHEET: 11A of 18


DETAIL F



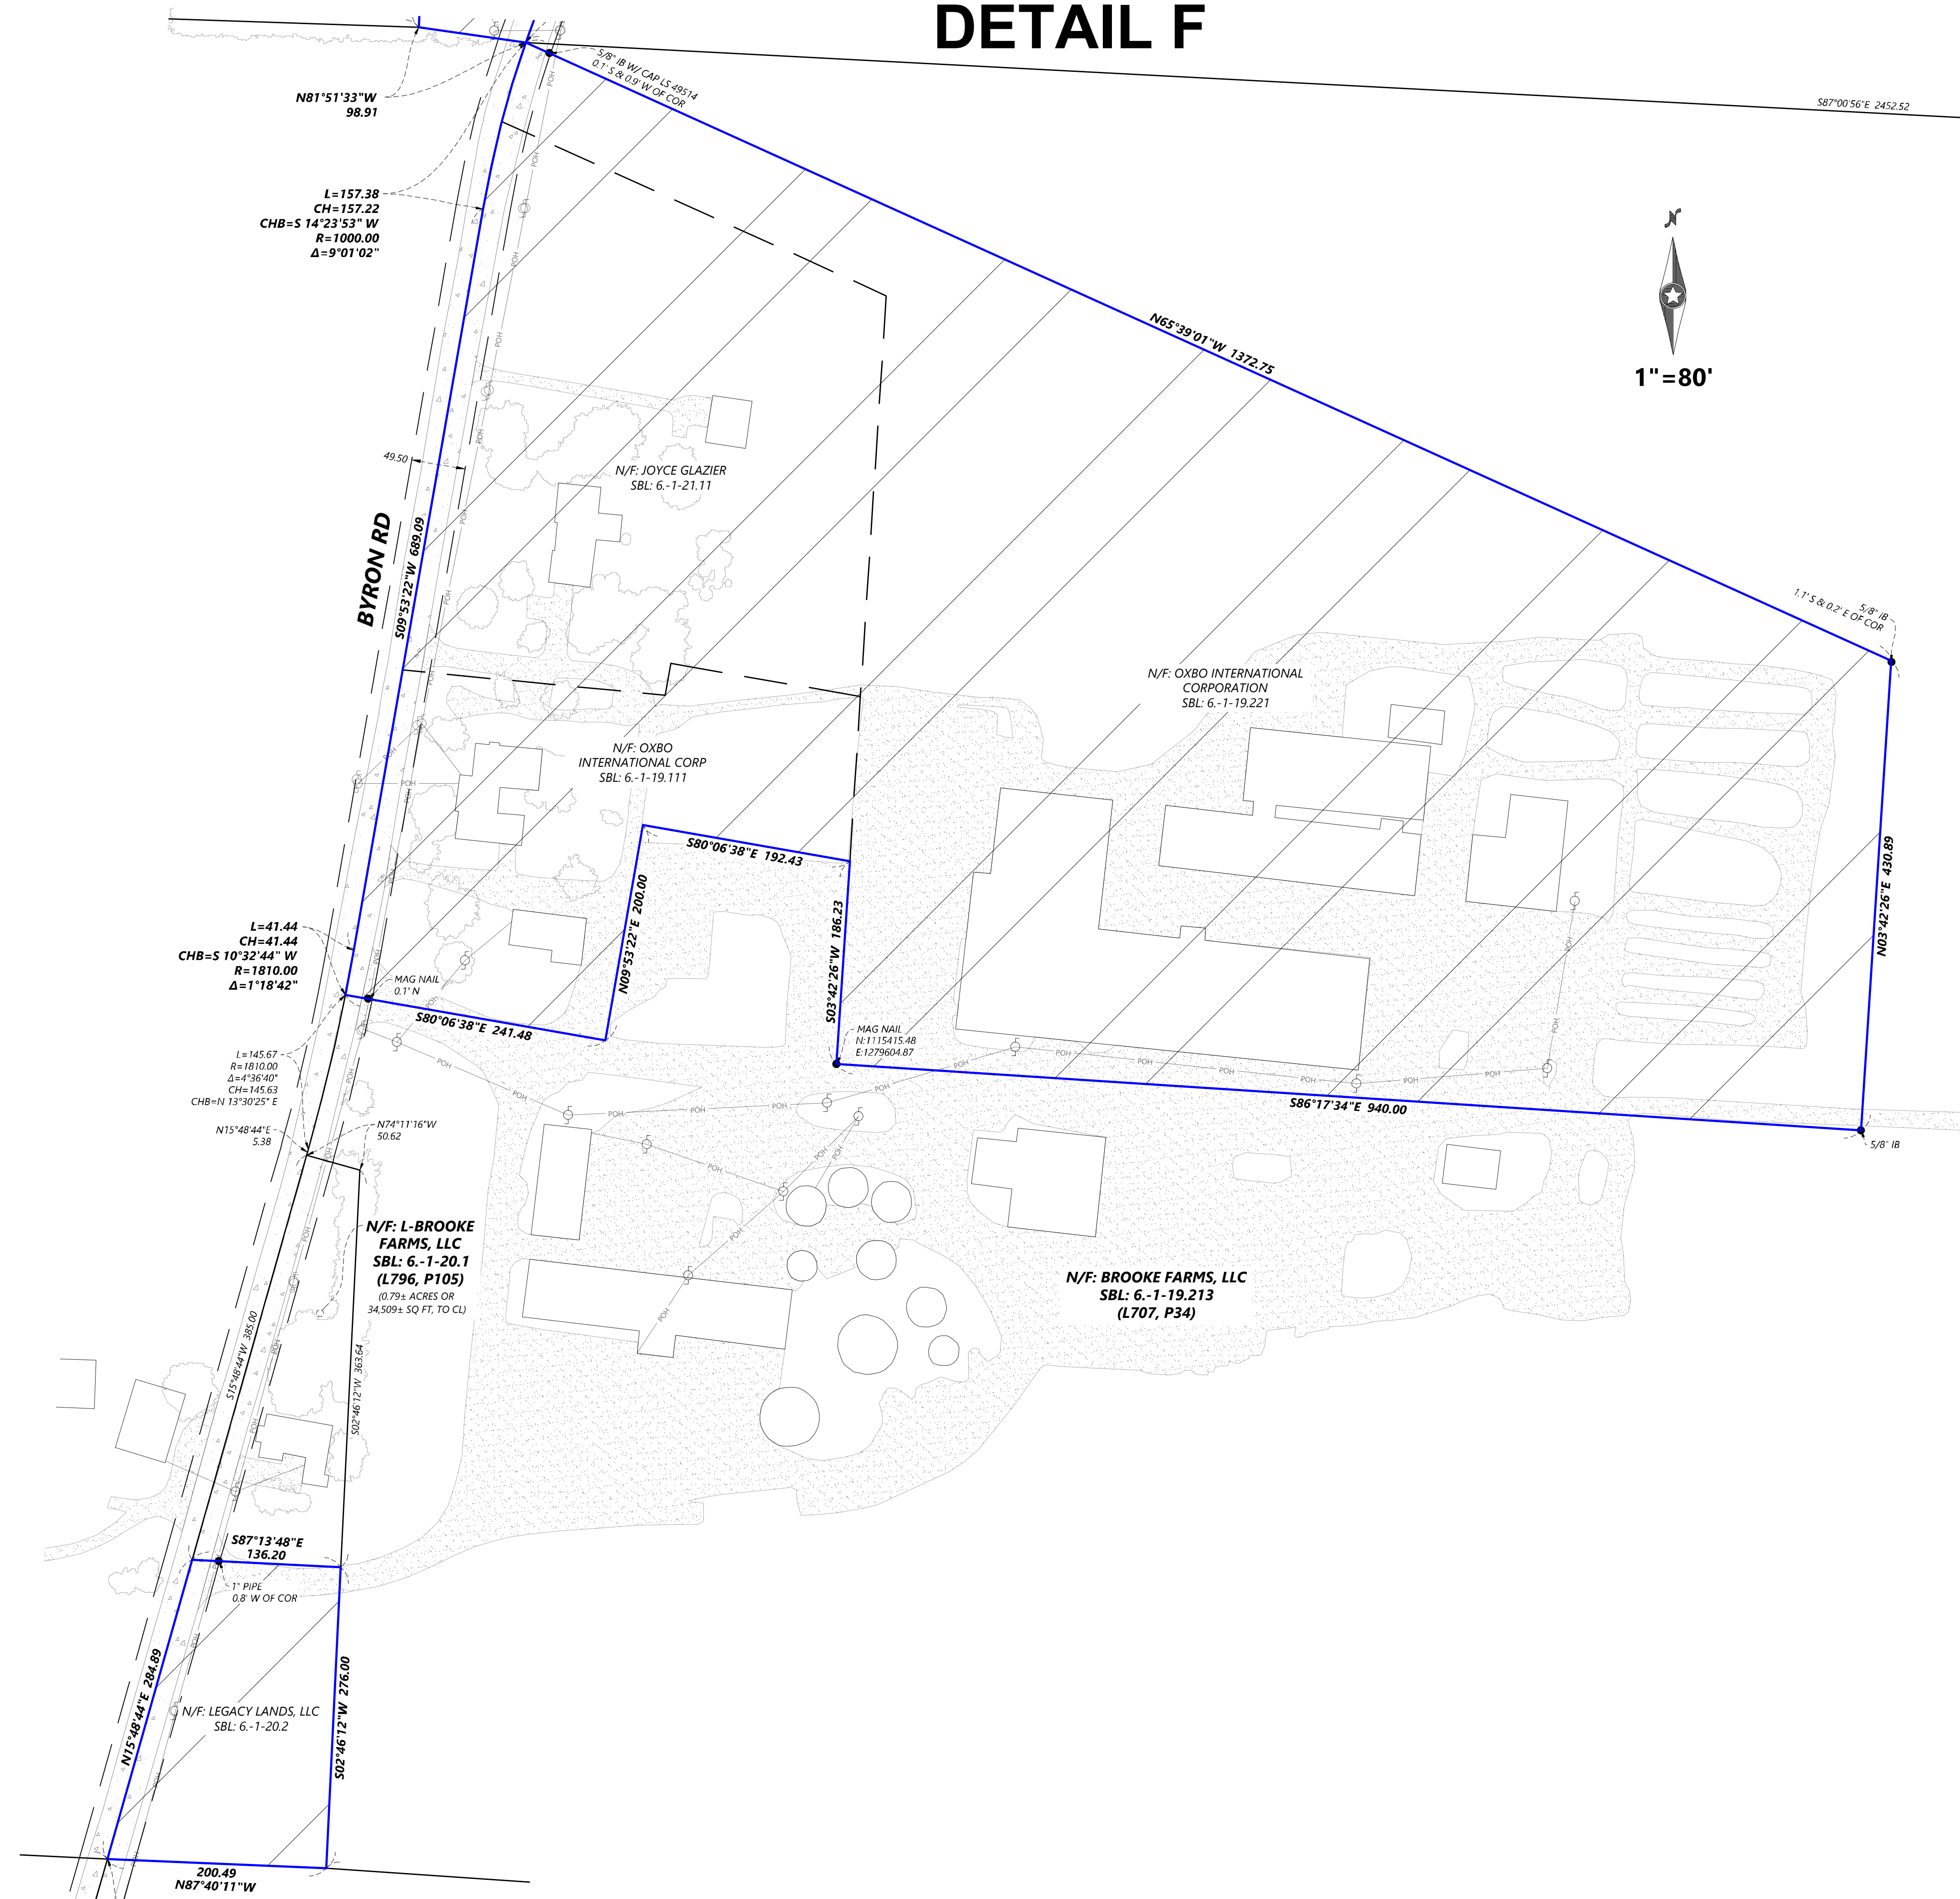


KEYMAP:

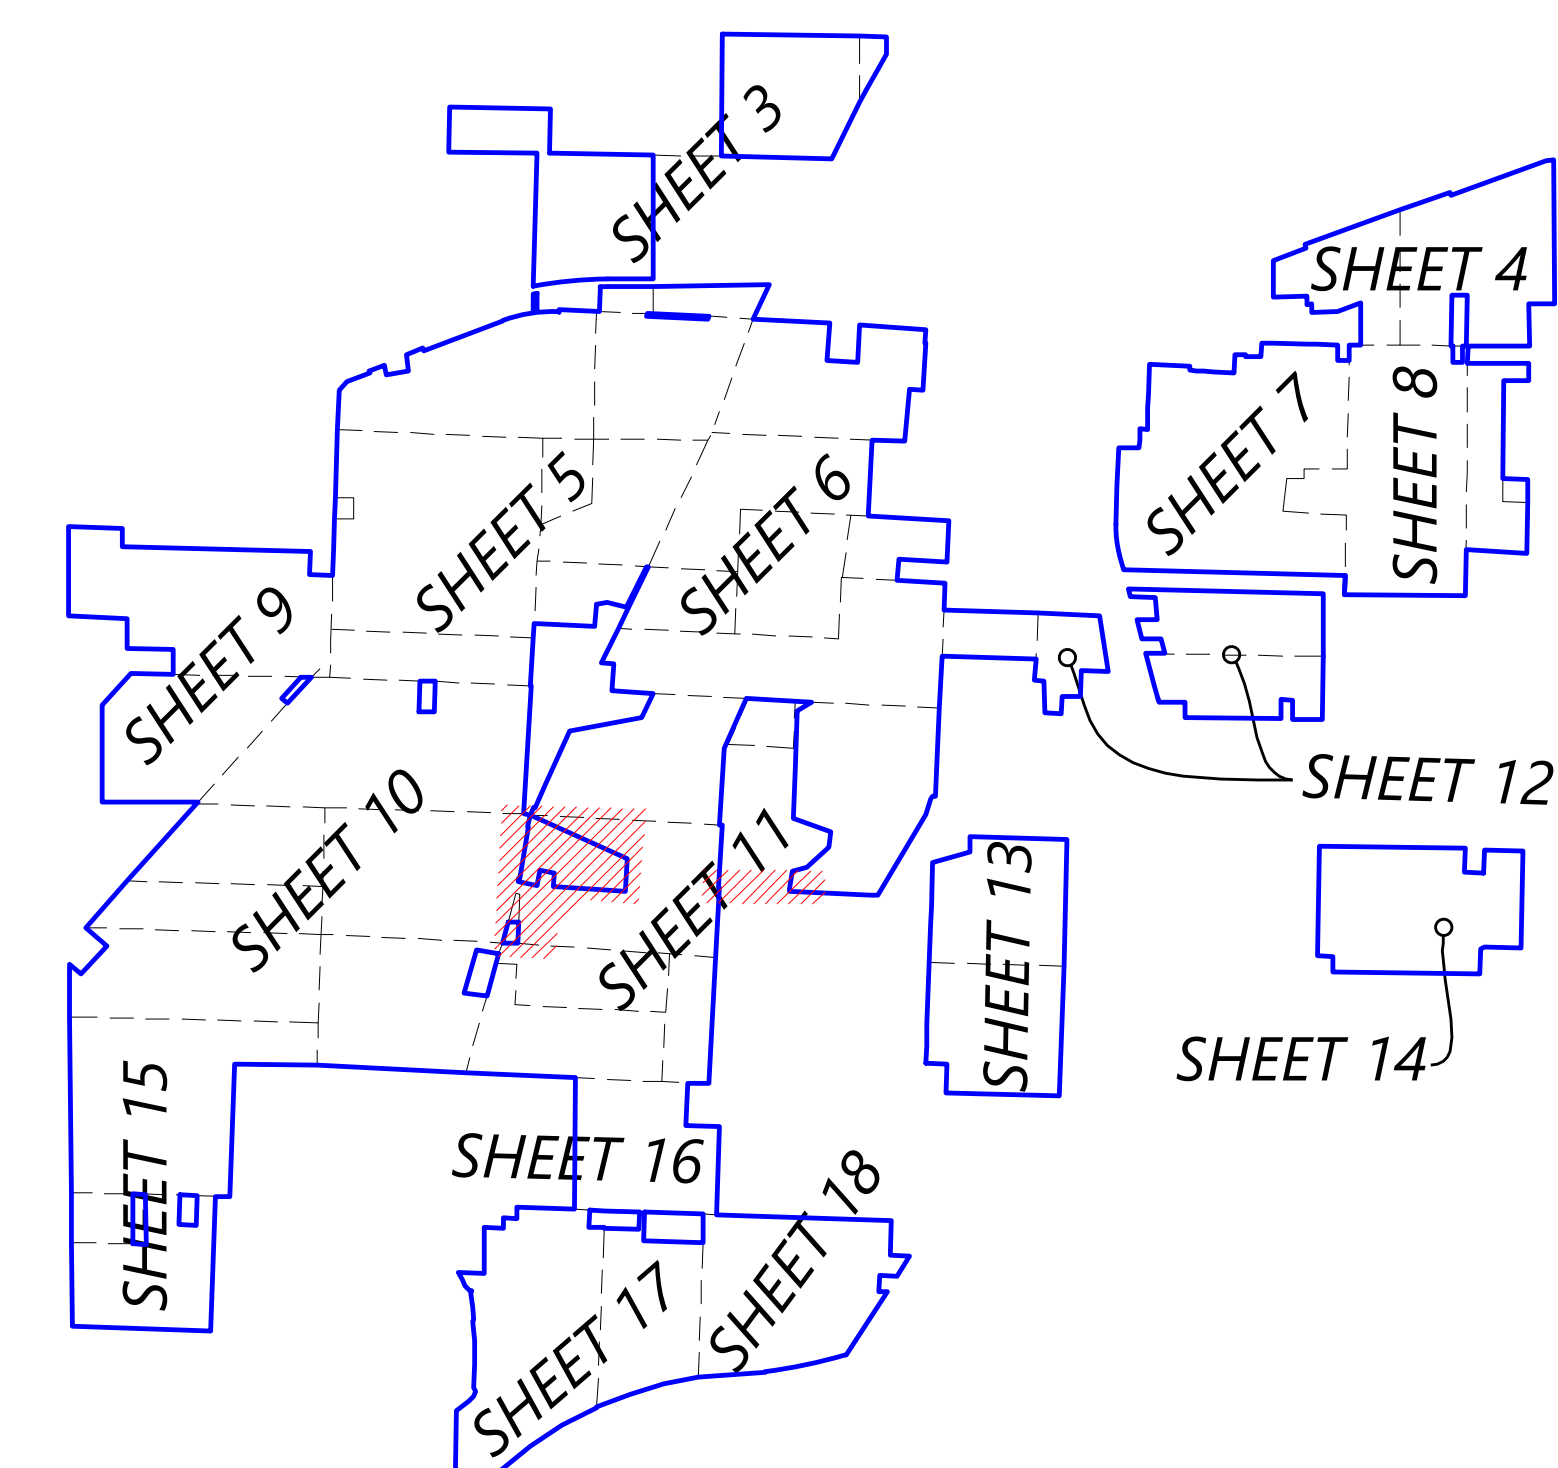

DETAIL G

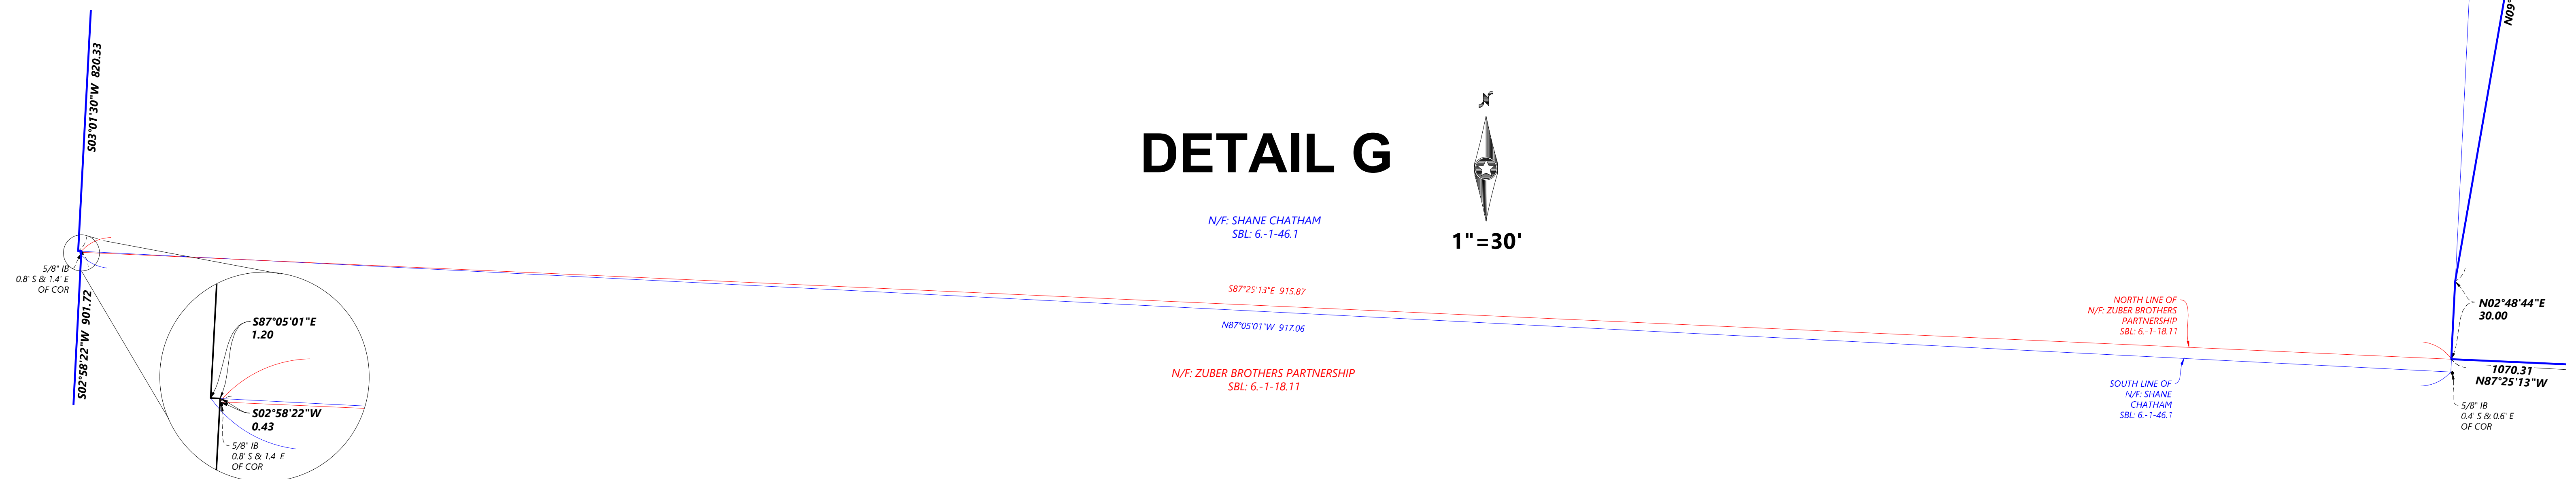

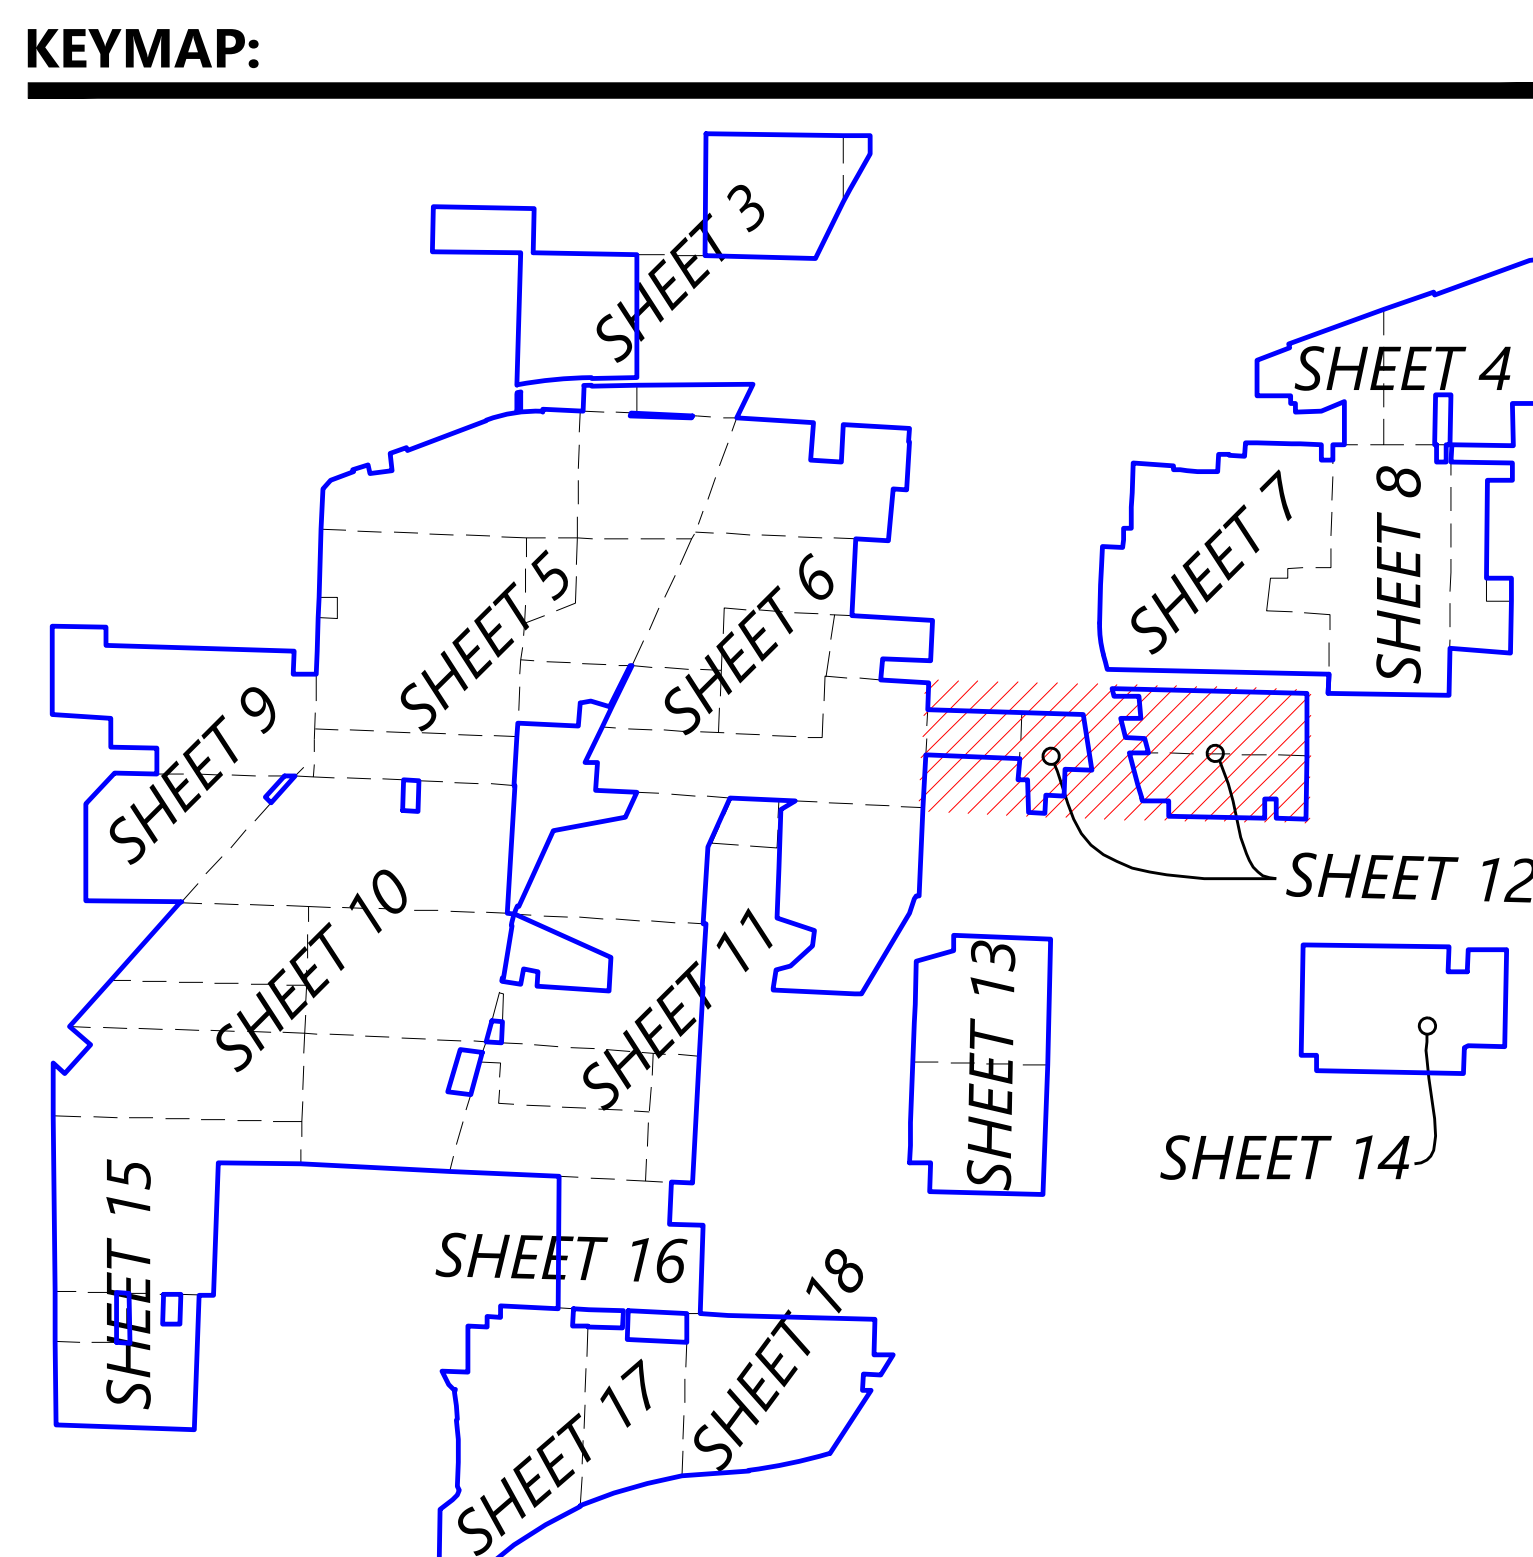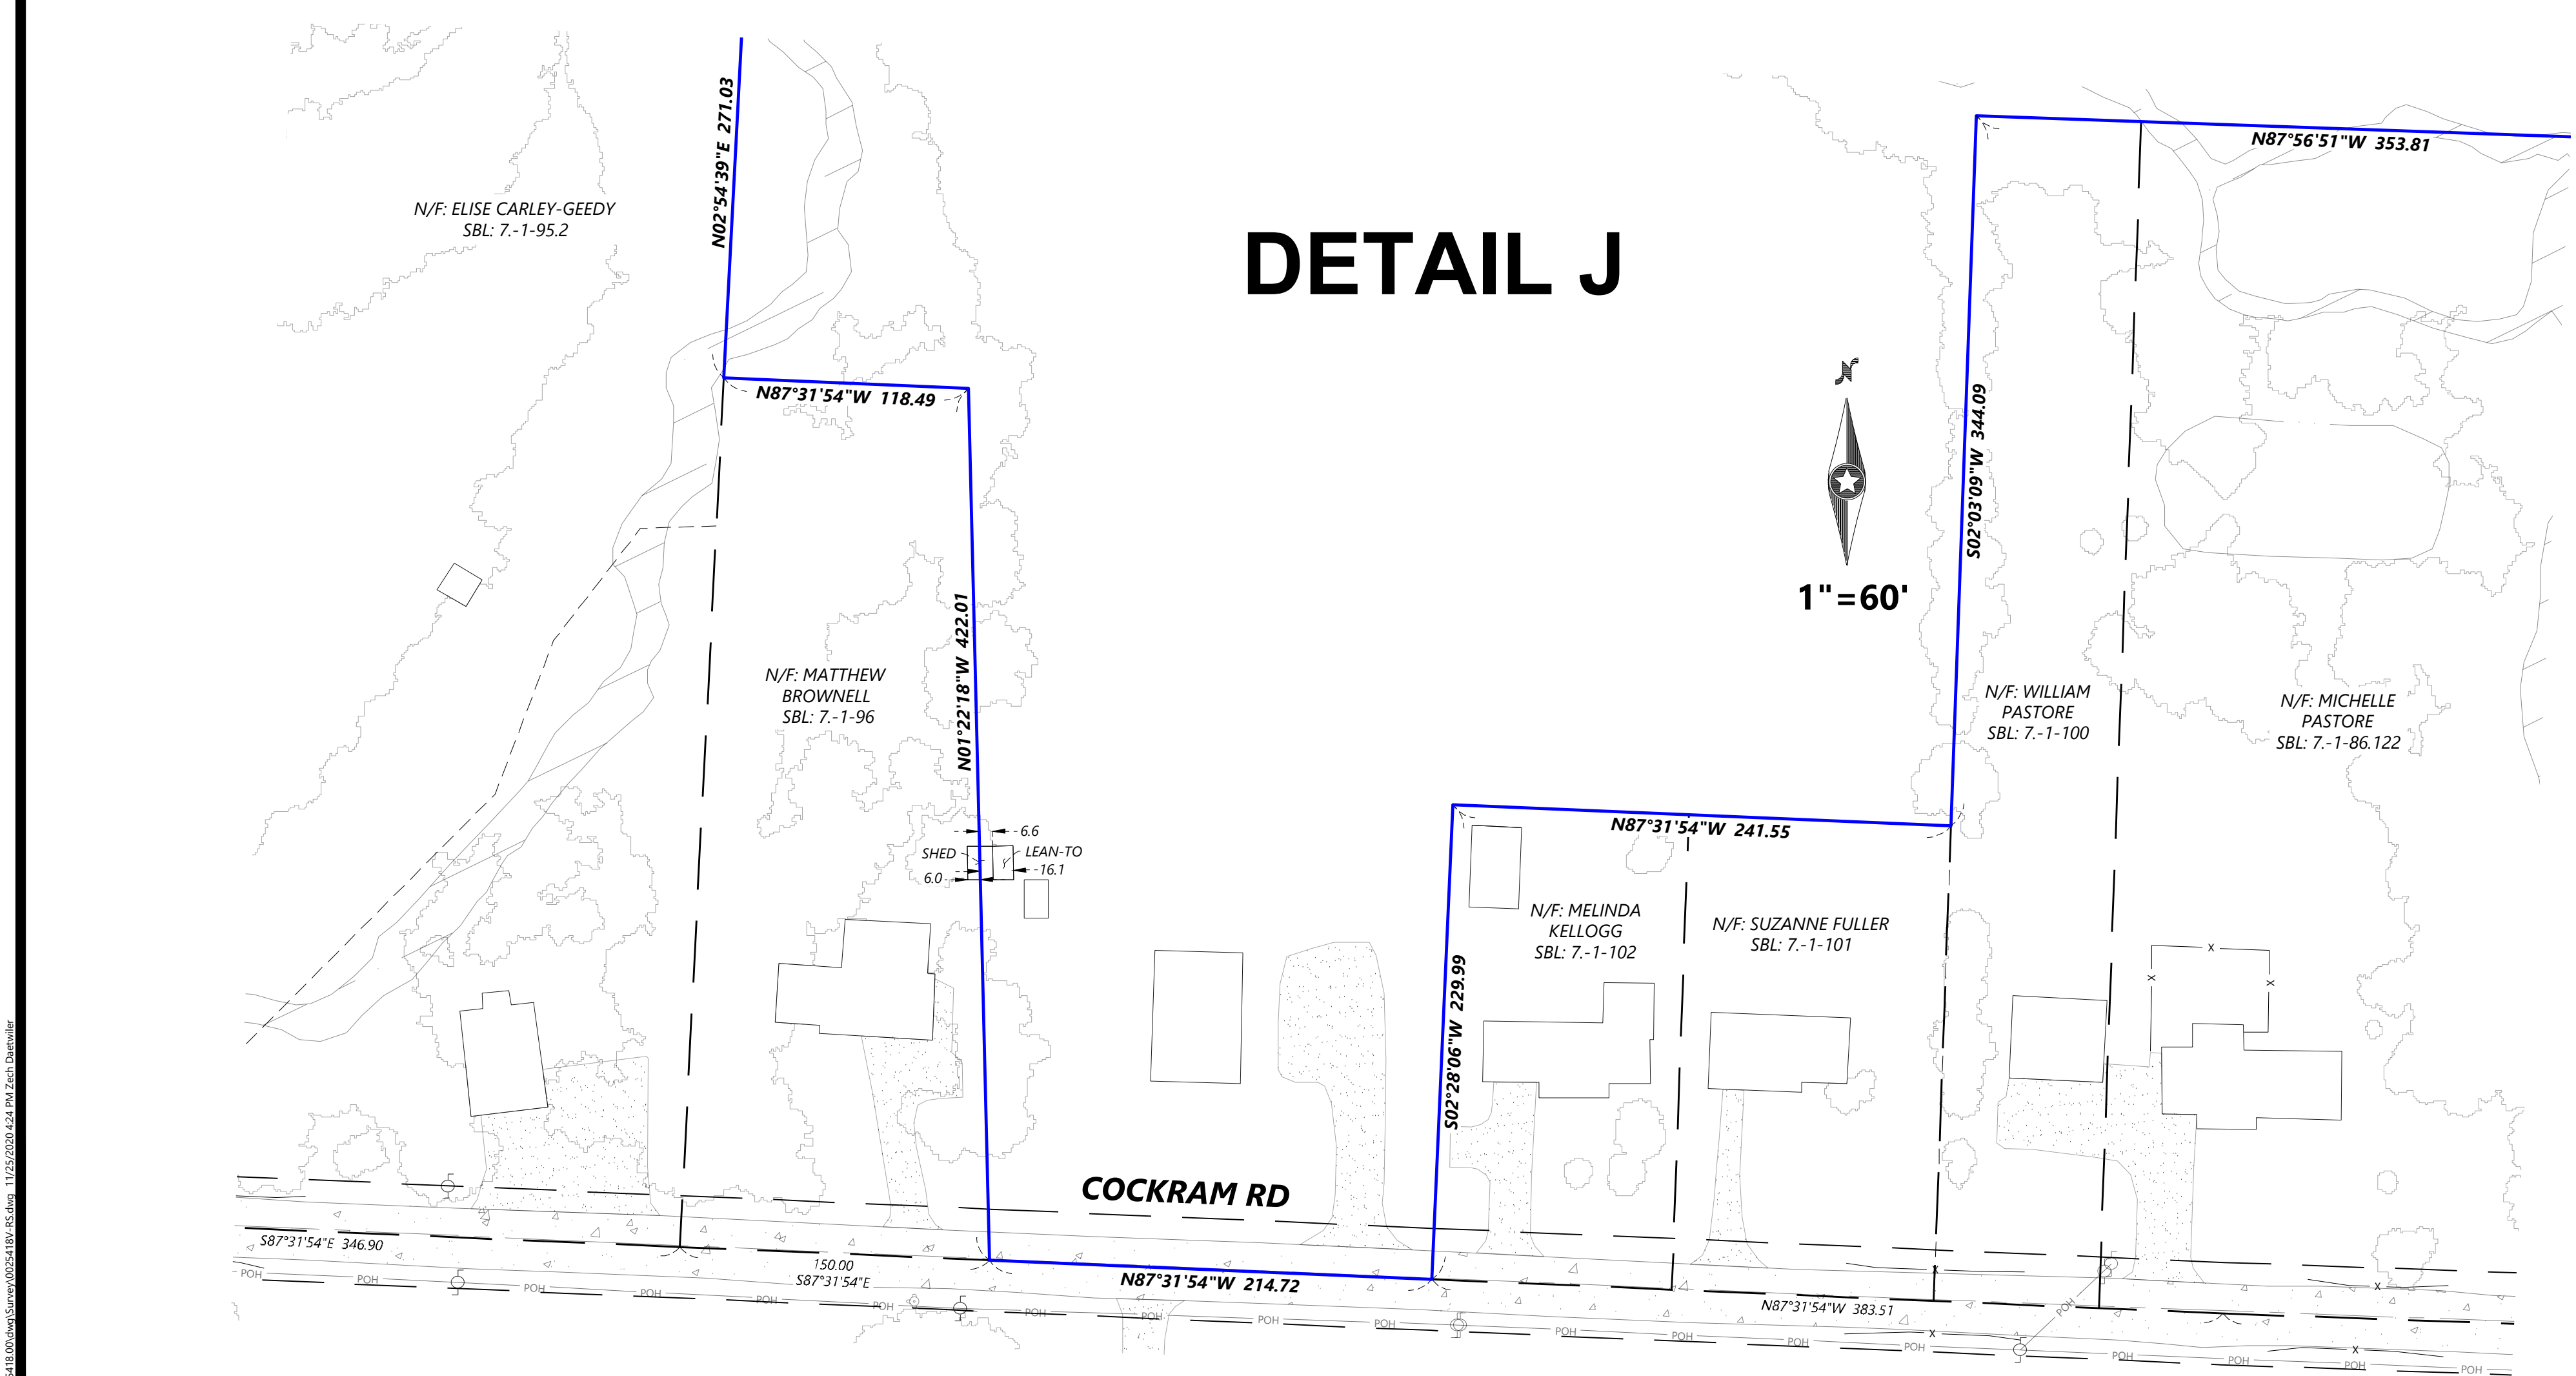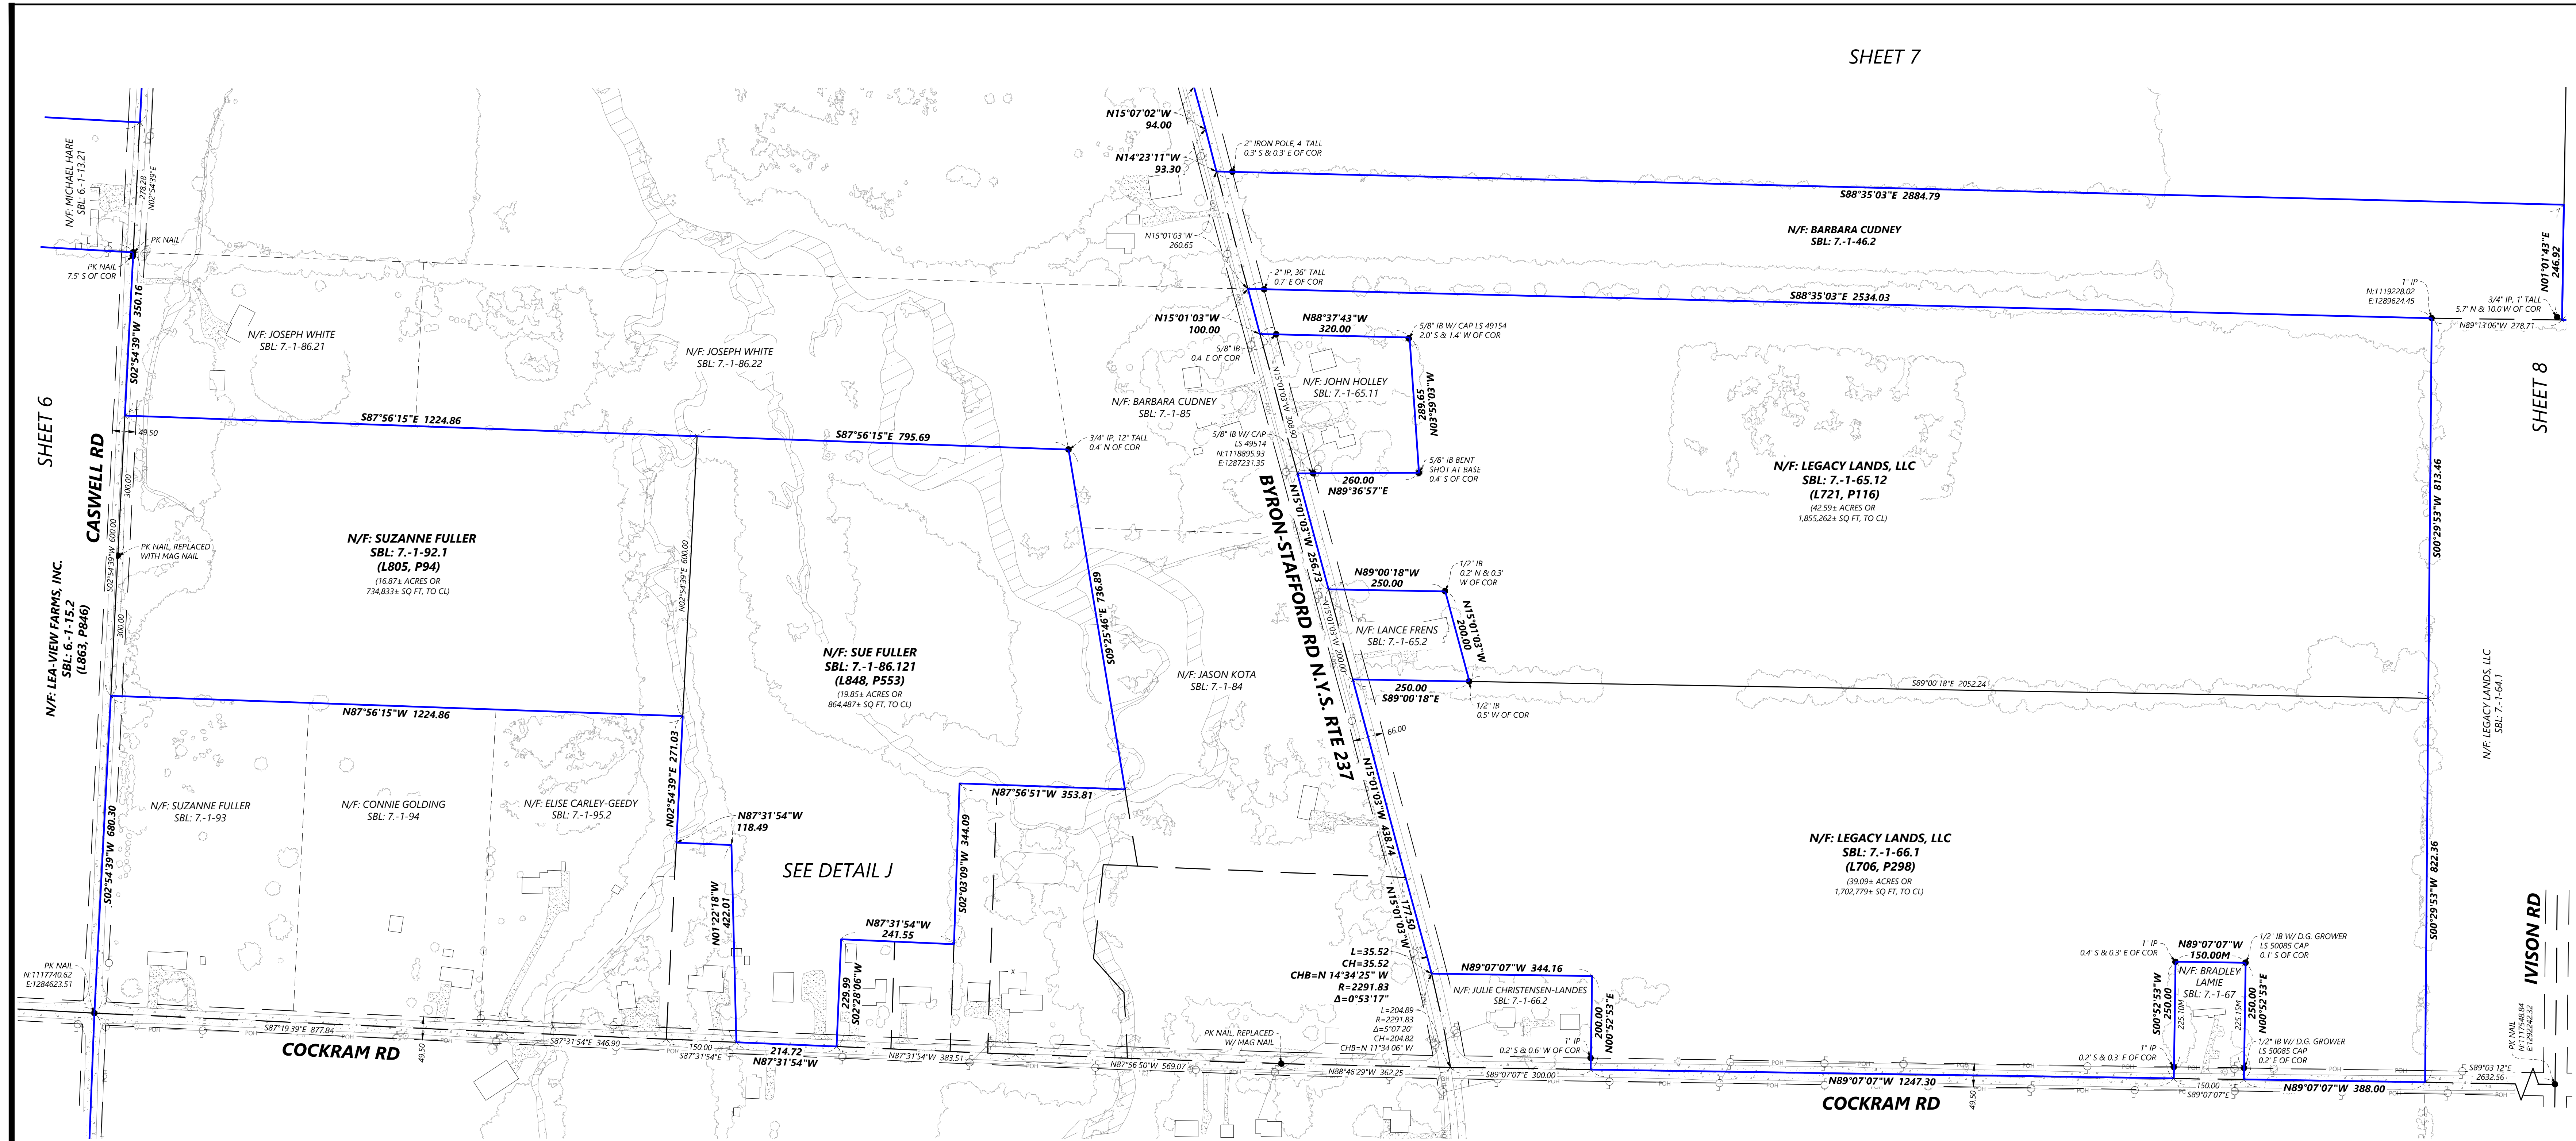

Westwood Surveying & Engineering
Phone (952) 937-5150 12701 Whitewater Drive, Suite #300
Fax (952) 937-5852 Minneapolis, MN 55441
Toll Free (888) 937-5150 www.pc.com
Westwood Surveying and Engineering, P.C.

PREPARED FOR:
NEXTERA ENERGY
PO Box 88808
North Palm Beach, FL 33408

REVISIONS:
DATE COMMENT


LEGEND:
GUY WIRE
POWER POLE
HYDRANT
SIGN
WATER EDGE
POWER OVERHEAD
FENCE LINE
BOUNDARY LINE
PARCEL LINE
ADJACENT PARCEL LINES
APPROXIMATE LOCATION OF PARCEL LINES FROM TAX MAP
EASEMENT LINES
EXCEPTION TO PROJECT
DRIVE
ROAD
WATER
VEGETATION
FOUND MONUMENT (SEE LABEL)
N/F NOW OR FORMERLY
COR CORNER
IP IRON PIPE
IB IRON BAR
RB REBAR

0 150 300 450

BEARING AND DISTANCES SHOWN HEREON ARE BASED ON NEW STATE PLANE COORDINATE SYSTEM, NAD1983(2011), NEW YORK WEST ZONE, US SURVEY FOOT. DISTANCES AND AREAS HAVE BEEN SCALED TO GROUND VALUES BY APPLYING A SCALE FACTOR OF 1.0000416. BEARINGS SHOWN HEREON ARE GRID NORTH.


EXCELSIOR SOLAR PROJECT
GENESEE COUNTY, NEW YORK

RECORD OF SURVEY
DATE: 11/03/2020
SHEET: 12 of 18

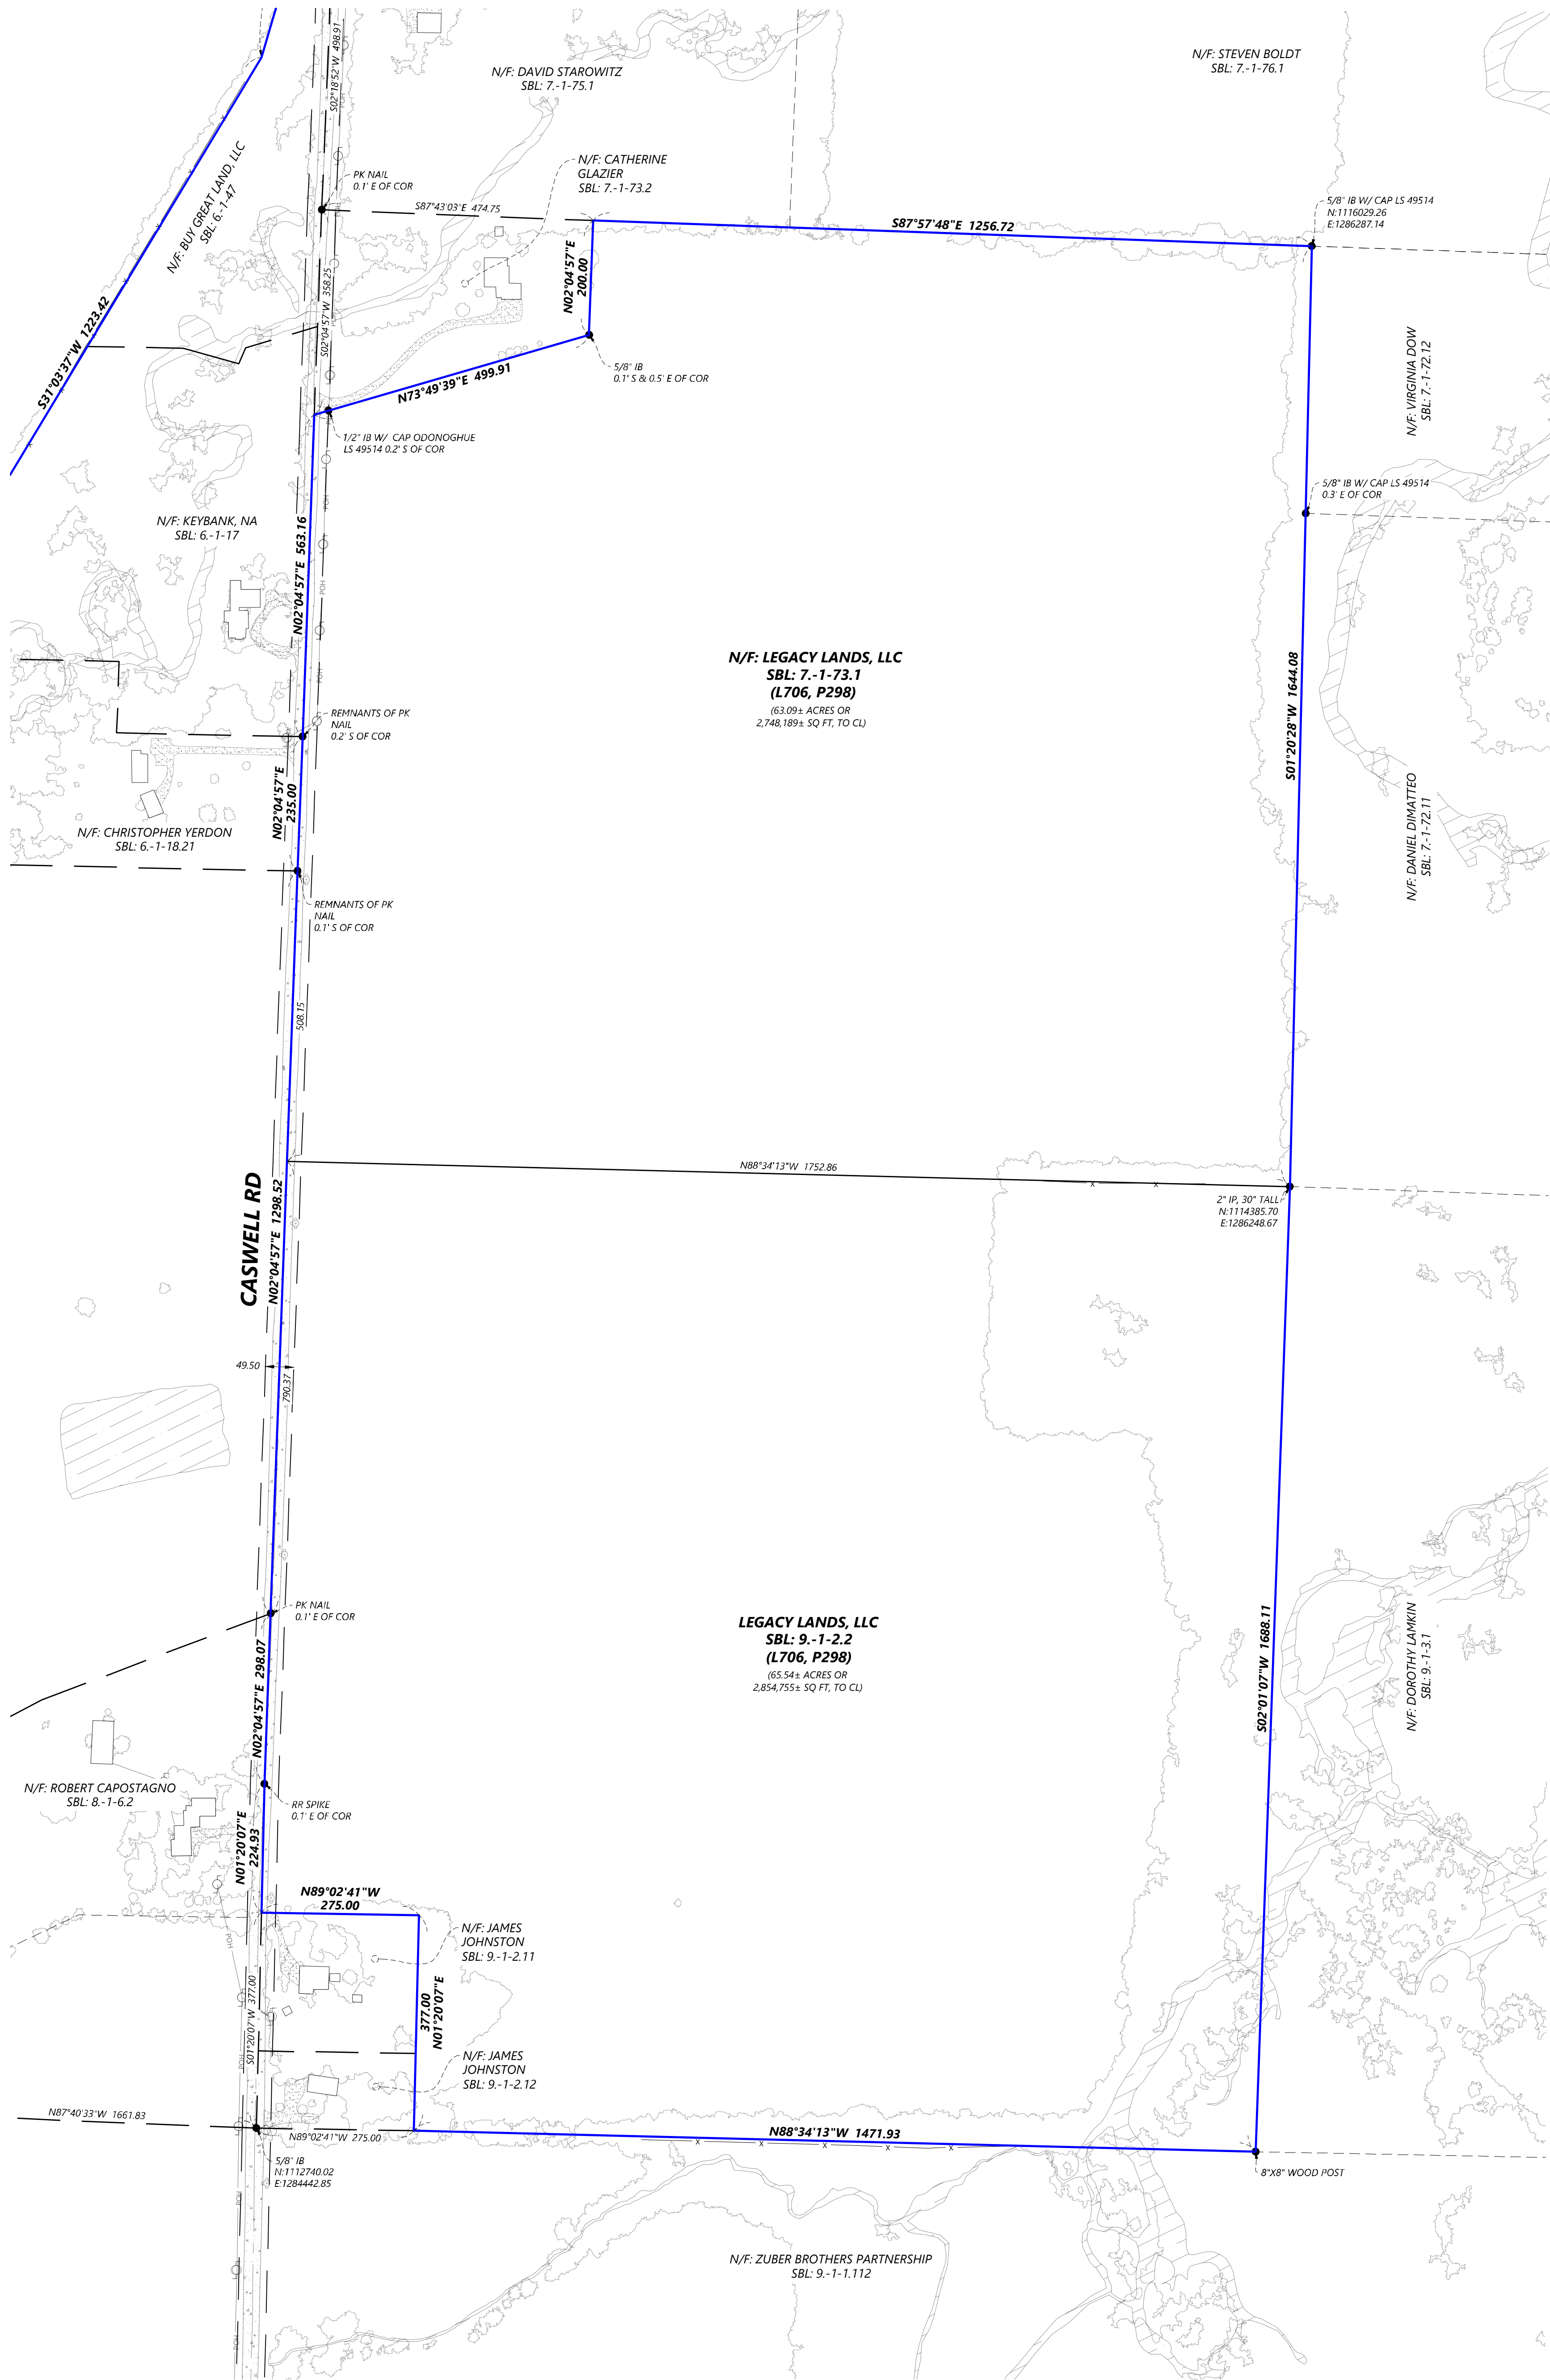

SHEET 11

KEYMAP:

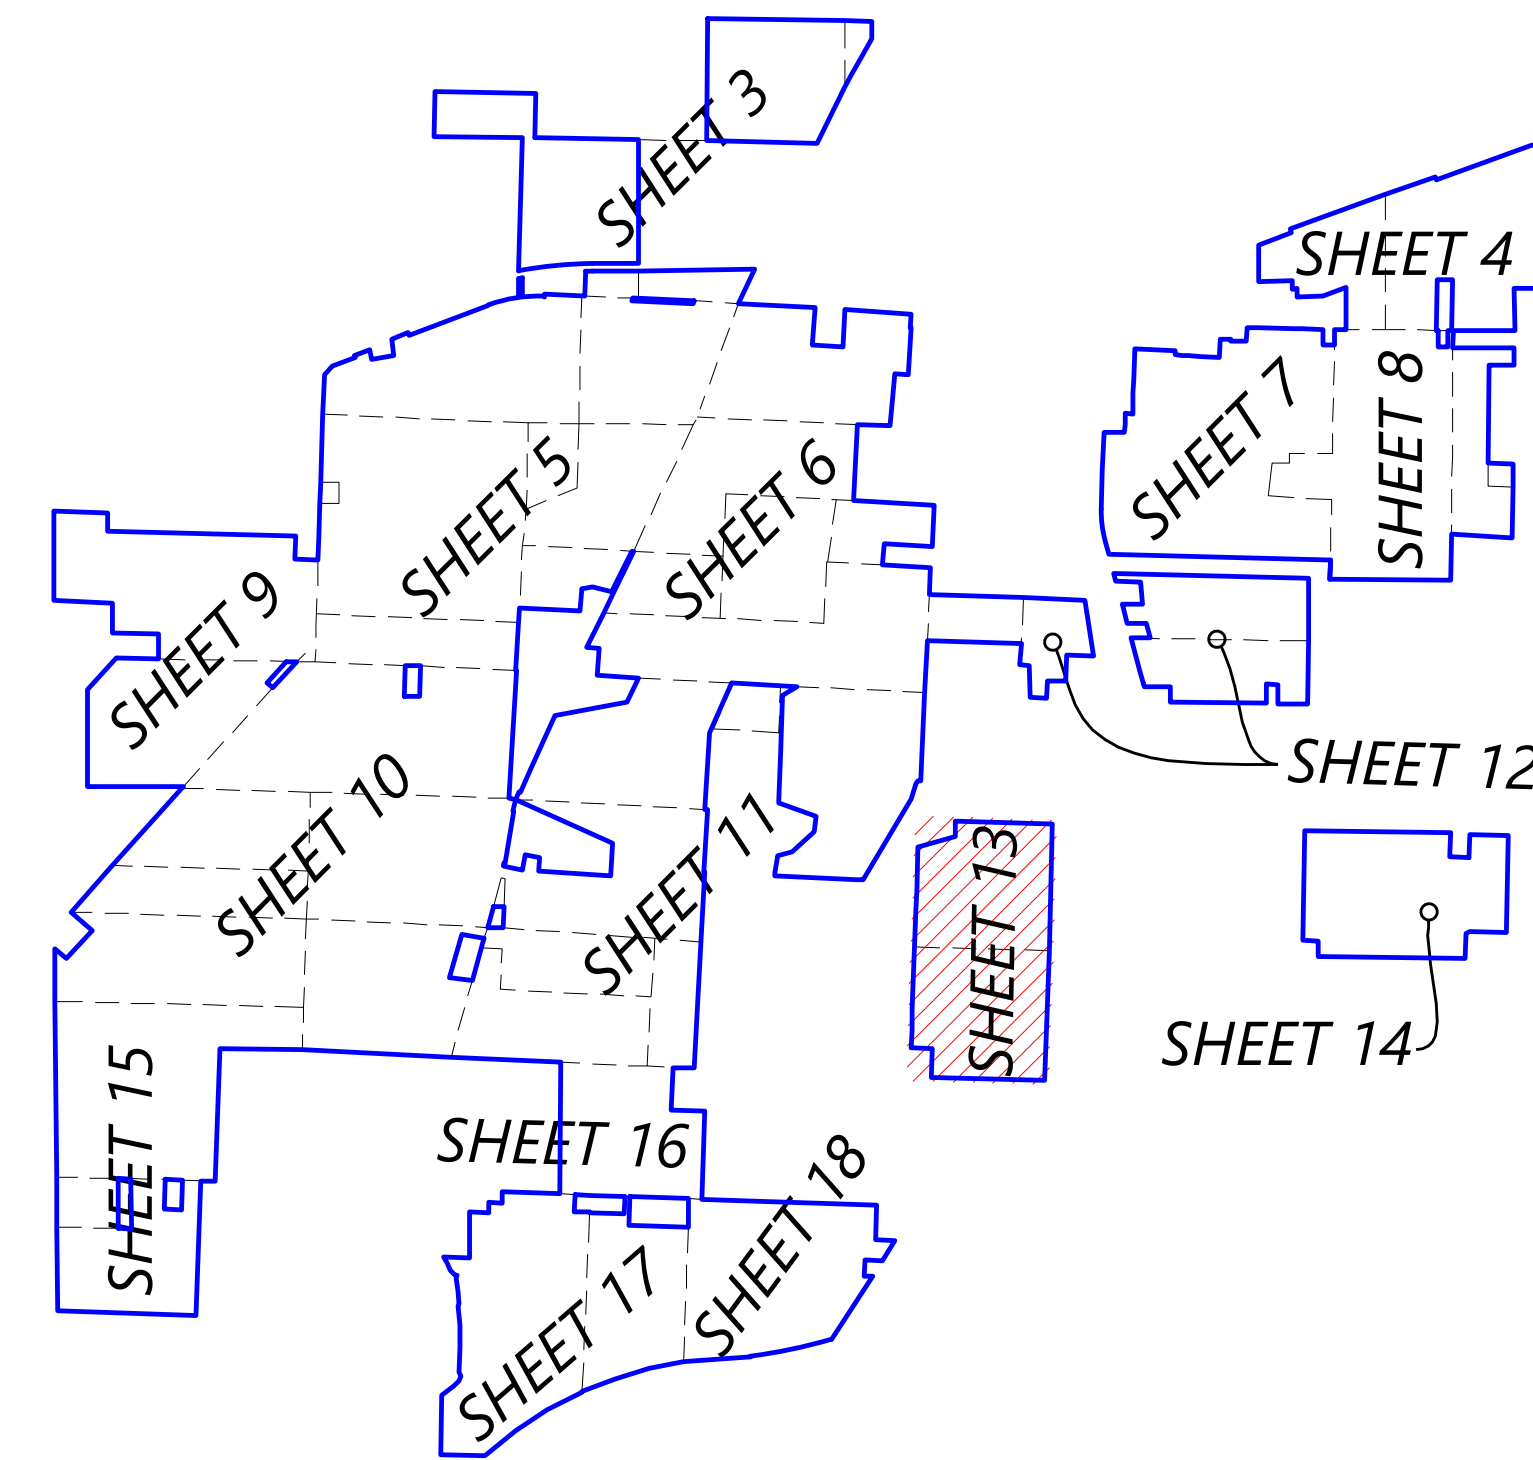

PREPARED FOR:




PO Box 88808
North Palm Beach, FL 33408

REVISIONS:		
#	DATE	COMMENT

LEGEND:

- GUY WIRE
- POWER POLE
- HYDRANT
- SIGN
- WATER EDGE
- POWER OVERHEAD
- FENCE LINE
- BOUNDARY LINE
- PARCEL LINE
- ADJACENT PARCEL LINES
- APPROXIMATE LOCATION OF PARCEL LINES FROM TAX MAP
- EASEMENT LINES
- EXCEPTION TO PROJECT
- DRIVE
- ROAD
- WATER
- VEGETATION
- FOUND MONUMENT (SEE LABEL)
- N/F NOW OR FORMERLY
- COR CORNER
- IP IRON PIPE
- IB IRON BAR
- RB REBAR

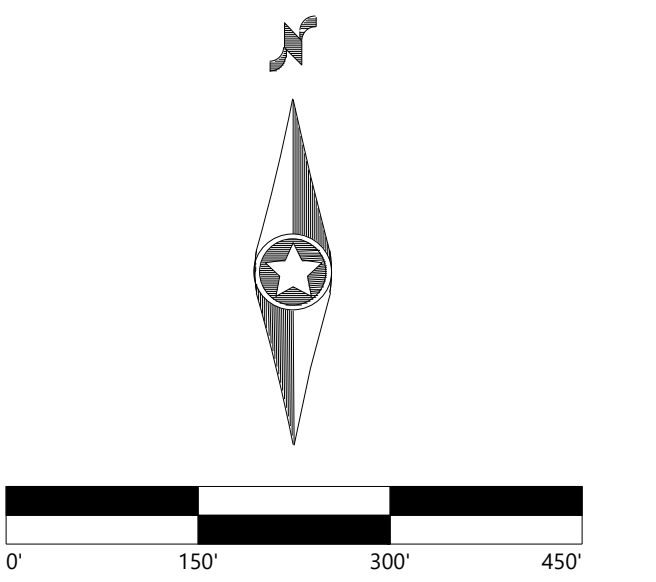

BEARING AND DISTANCES SHOWN HEREON ARE BASED ON NEW STATE PLANE COORDINATE SYSTEM, NAD1983(2011), NEW YORK WEST ZONE, US SURVEY FOOT. DISTANCES AND AREAS HAVE BEEN SCALED TO GROUND VALUES BY APPLYING A SCALE FACTOR OF 1.0000416. BEARINGS SHOWN HEREON ARE GRID NORTH.

EXCELSIOR
SOLAR PROJECT
GENESEE COUNTY, NEW YORK


RECORD OF SURVEY

DATE: 11/03/2020


SHEET: 13 of 18

[illegible]

	GUY WIRE
	POWER POLE
	HYDRANT
	SIGN
	WATER EDGE
	POWER OVERHEAD
	FENCE LINE
	BOUNDARY LINE
	PARCEL LINE
	ADJACENT PARCEL LINES
	APPROXIMATE LOCATION OF PARCEL LINES FROM TAX MAP
	EASEMENT LINES
	EXCEPTION TO PROJECT
	DRIVE
	ROAD
	WATER
	VEGETATION
	FOUND MONUMENT (SEE LABEL)
	NOW OR FORMERLY
	CORNER
	IRON PIPE
	IRON BAR
	REBAR

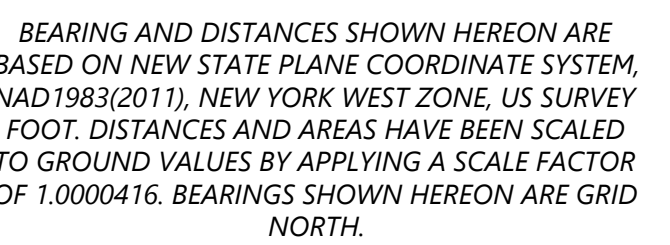

SHEET: 14 of 18

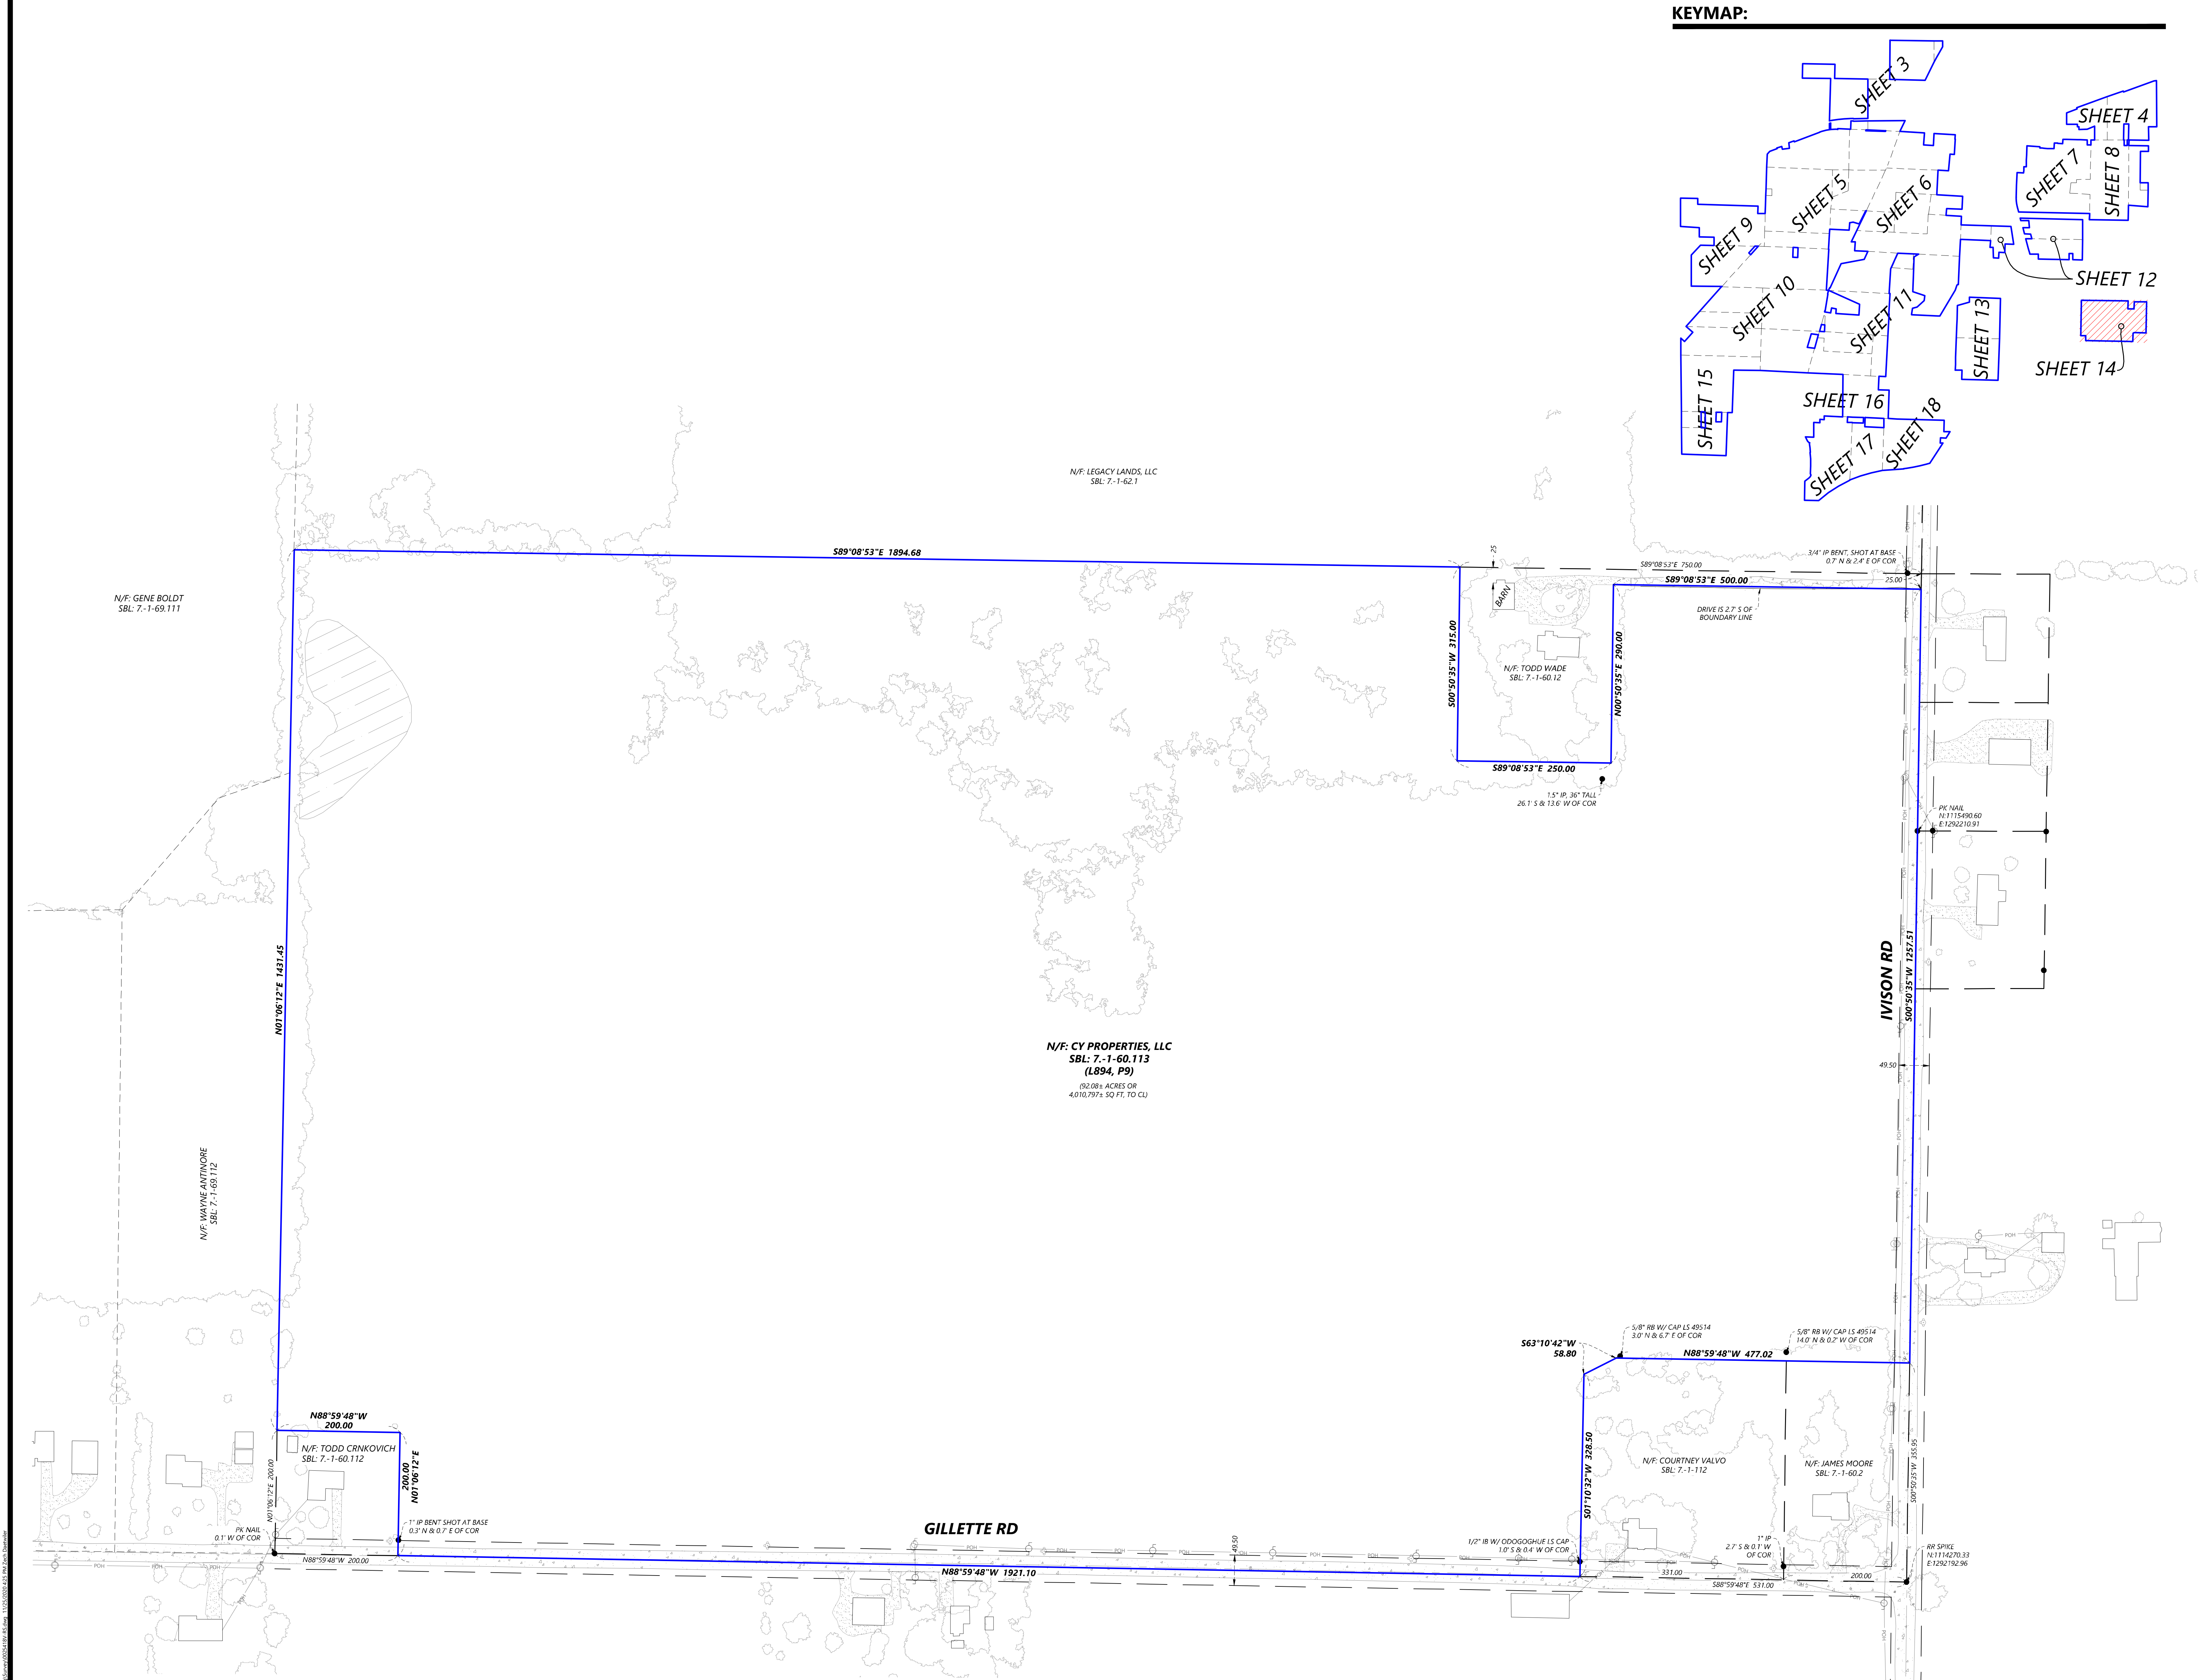

PREPARED FOR:




PO Box 88808
North Palm Beach, FL 33408

REVISIONS:		
#	DATE	COMMENT
1		
2		
3		
4		
5		
6		

LEGEND:

- | | |
|--|---|
|  | GUY WIRE |
|  | POWER POLE |
|  | HYDRANT |
|  | SIGN |
|  | WATER EDGE |
|  | POWER OVERHEAD |
|  | FENCE LINE |
|  | BOUNDARY LINE |
|  | PARCEL LINE |
|  | ADJACENT PARCEL LINES |
|  | APPROXIMATE LOCATION OF
PARCEL LINES FROM TAX MAPS |
|  | EASEMENT LINES |
|  | EXCEPTION TO PROJECT |
|  | DRIVE |
|  | ROAD |
|  | WATER |
|  | VEGETATION |
|  | FOUND MONUMENT (SEE LAB) |
|  | NOW OR FORMERLY |
|  | CORNER |
|  | IRON PIPE |
|  | IRON BAR |
|  | REBAR |

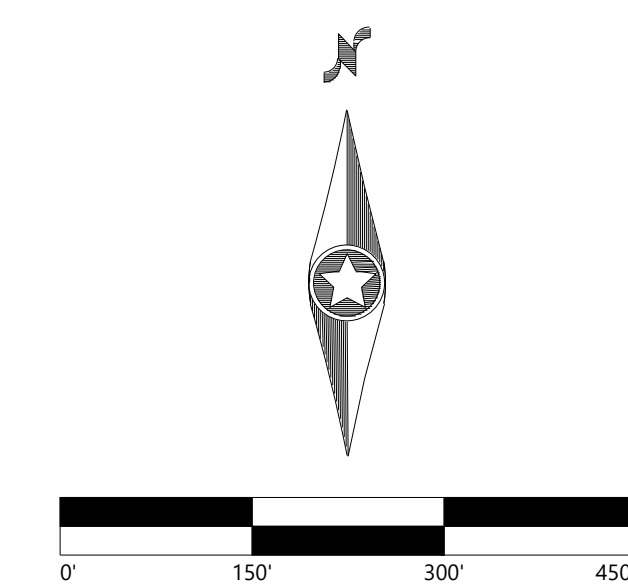

BEARING AND DISTANCES SHOWN HEREON ARE
BASED ON NEW STATE PLANE COORDINATE SYSTEM,
NAD1983(2011), NEW YORK WEST ZONE, US SURVEY
FOOT. DISTANCES AND AREAS HAVE BEEN SCALED
TO GROUND VALUES BY APPLYING A SCALE FACTOR
OF 1.0000416. BEARINGS SHOWN HEREON ARE GRID
NORTH.


EXCELSIOR SOLAR PROJECT

GENESEE COUNTY, NEW YORK

RECORD OF SURVEY

DATE: 11/03/2020

SHEET: 15 of 18

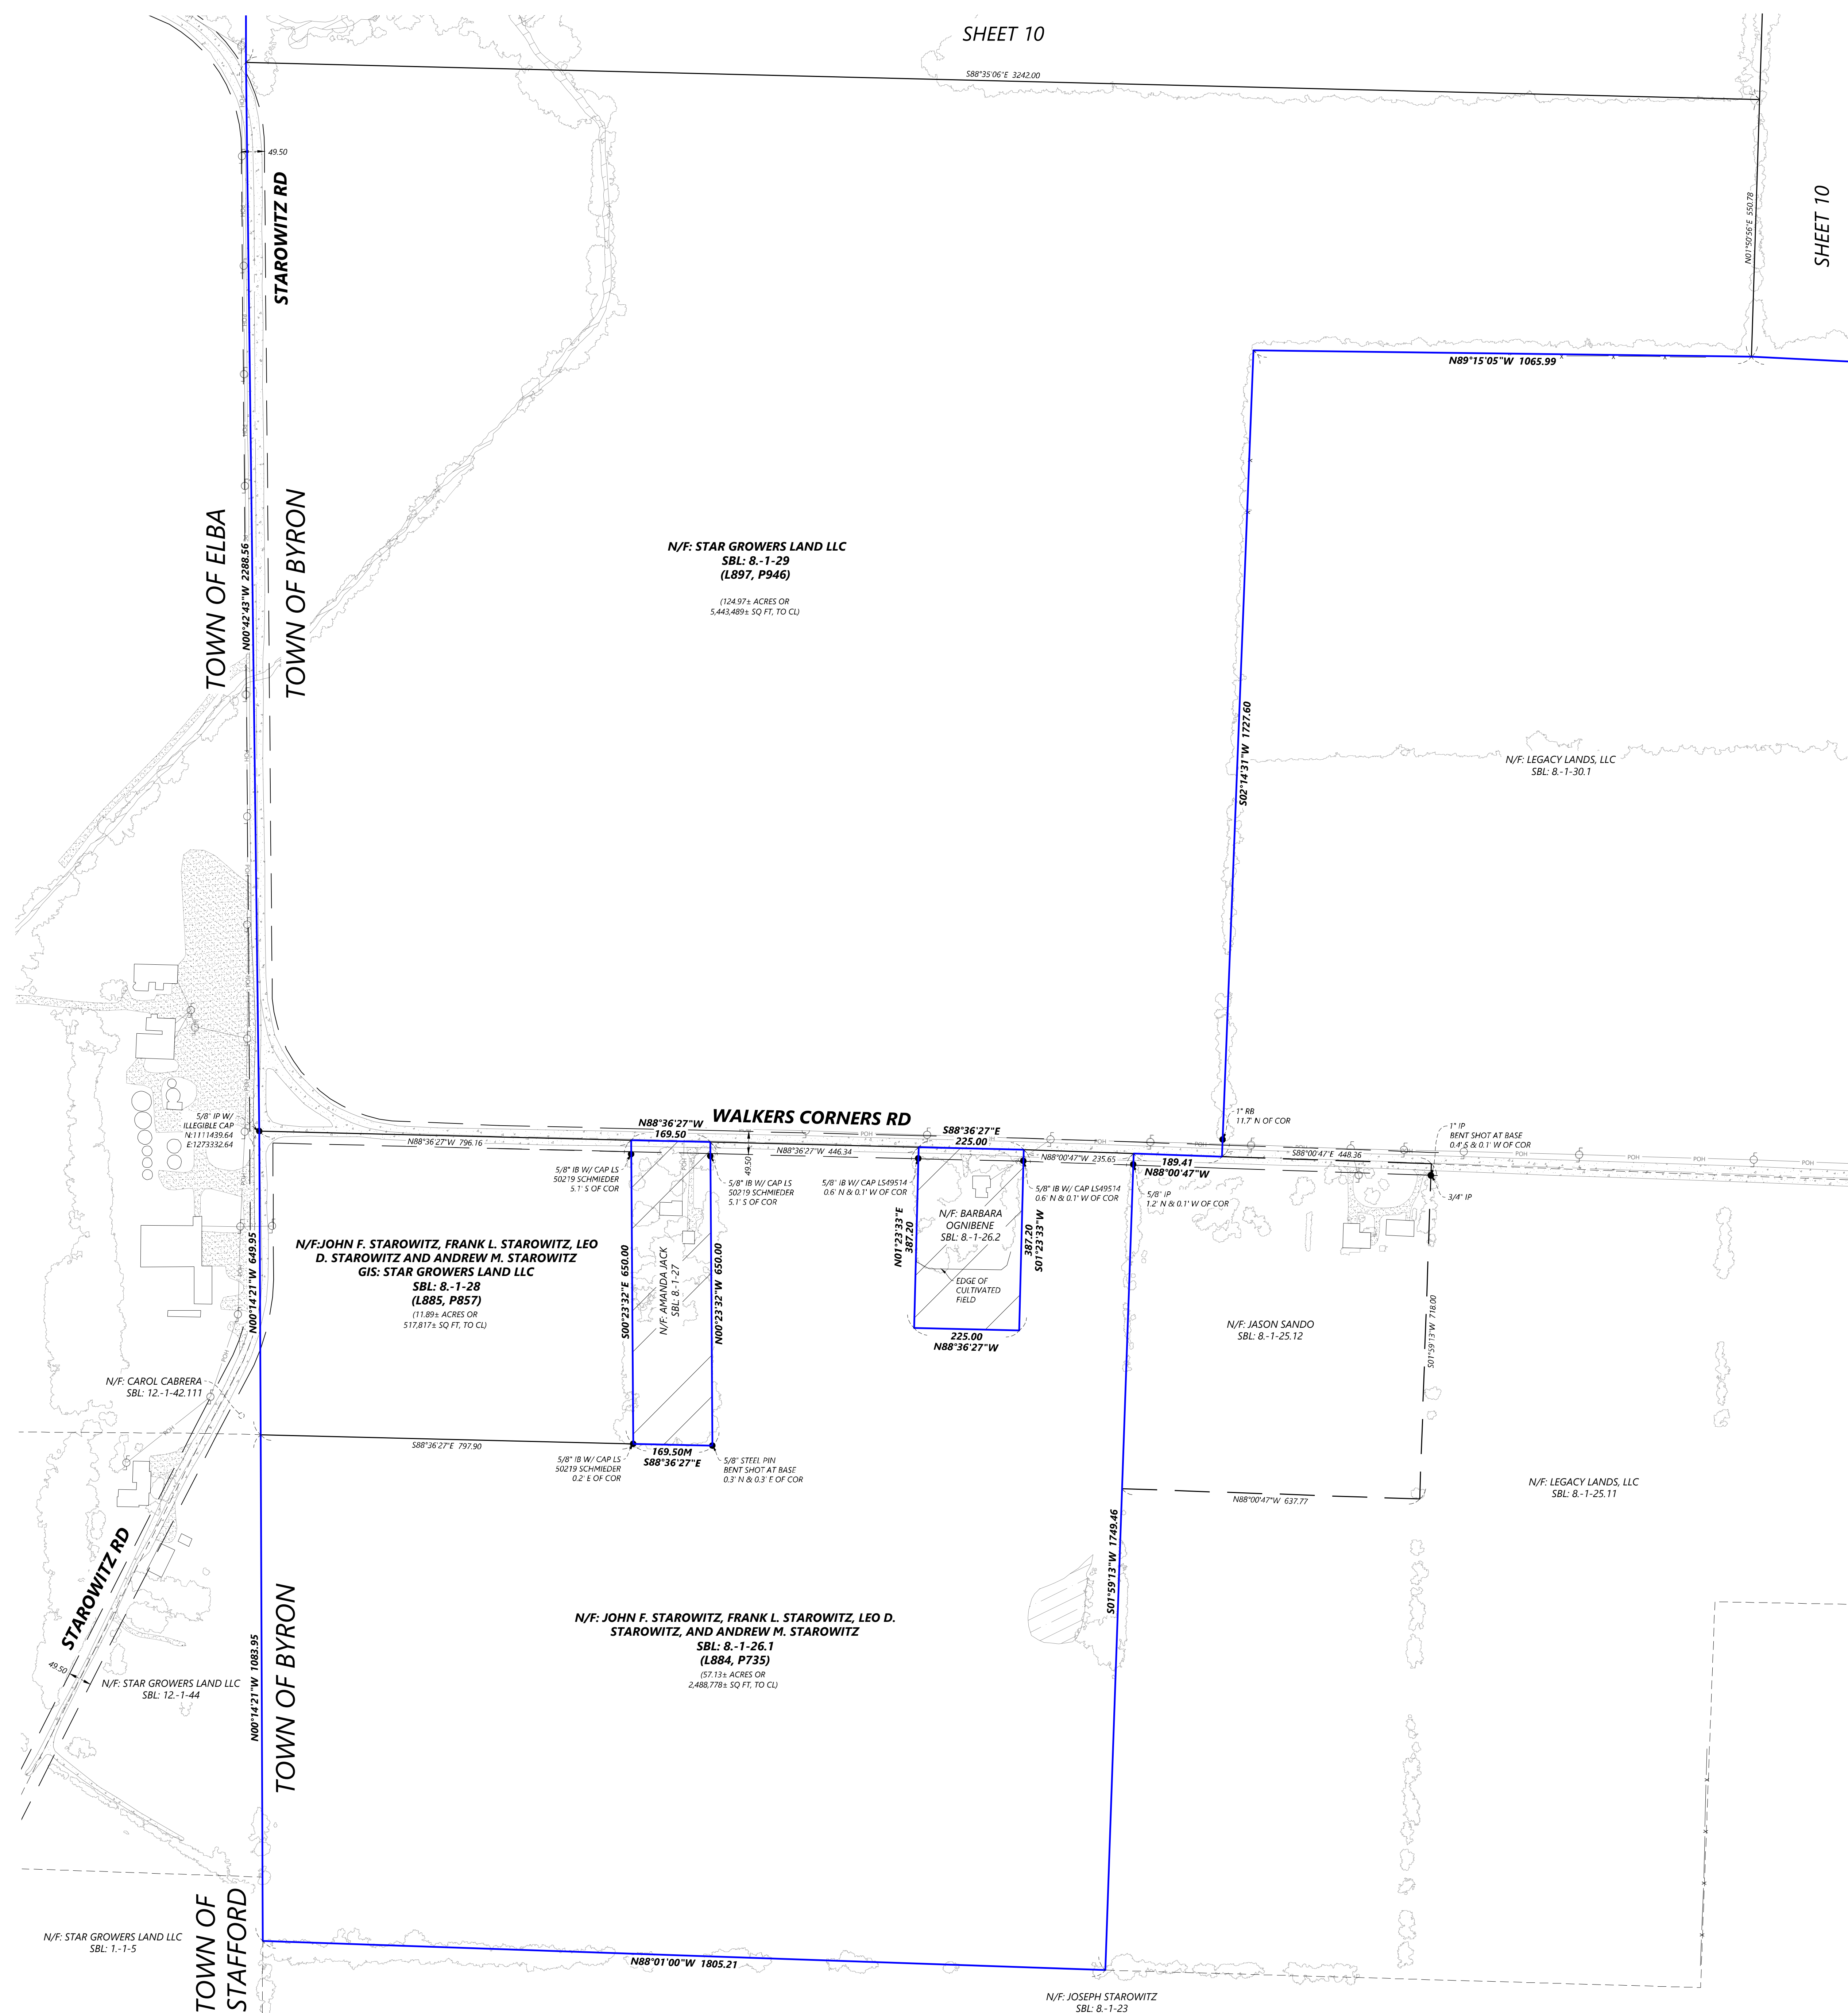

PREPARED FOR:




PO Box 88808
North Palm Beach, FL 33408

REVISIONS:		
#	DATE	COMMENT

LEGEND:

- GUY WIRE
- POWER POLE
- HYDRANT
- SIGN
- WATER EDGE
- POWER OVERHEAD
- FENCE LINE
- BOUNDARY LINE
- PARCEL LINE
- ADJACENT PARCEL LINES
- APPROXIMATE LOCATION OF PARCEL LINES FROM TAX MAP
- EASEMENT LINES
- EXCEPTION TO PROJECT
- DRIVE
- ROAD
- WATER
- VEGETATION
- FOUND MONUMENT (SEE LABEL)
- N/F NOW OR FORMERLY
- COR CORNER
- IP IRON PIPE
- IB IRON BAR
- RB REBAR

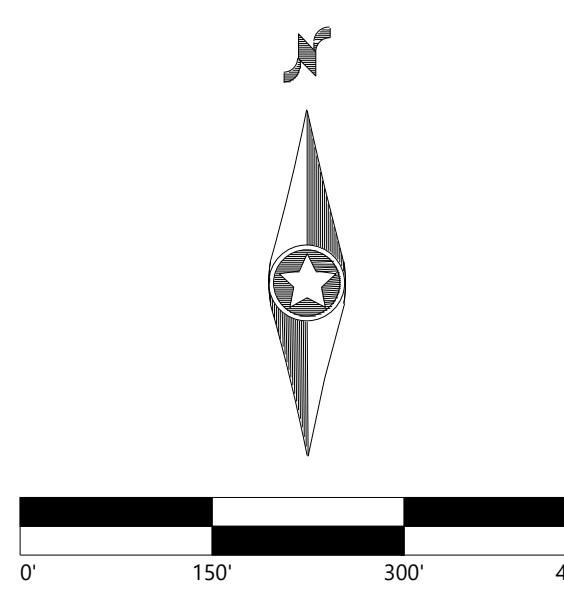


BEARING AND DISTANCES SHOWN HEREON ARE BASED ON NEW STATE PLANE COORDINATE SYSTEM, NAD1983(2011), NEW YORK WEST ZONE, US SURVEY FOOT. DISTANCES AND AREAS HAVE BEEN SCALED TO GROUND VALUES BY APPLYING A SCALE FACTOR OF 1.0000416. BEARINGS SHOWN HEREON ARE GRID NORTH.


EXCELSIOR
SOLAR PROJECT
GENESEE COUNTY, NEW YORK

RECORD OF SURVEY


DATE: 11/03/2020
SHEET: 16 of 18

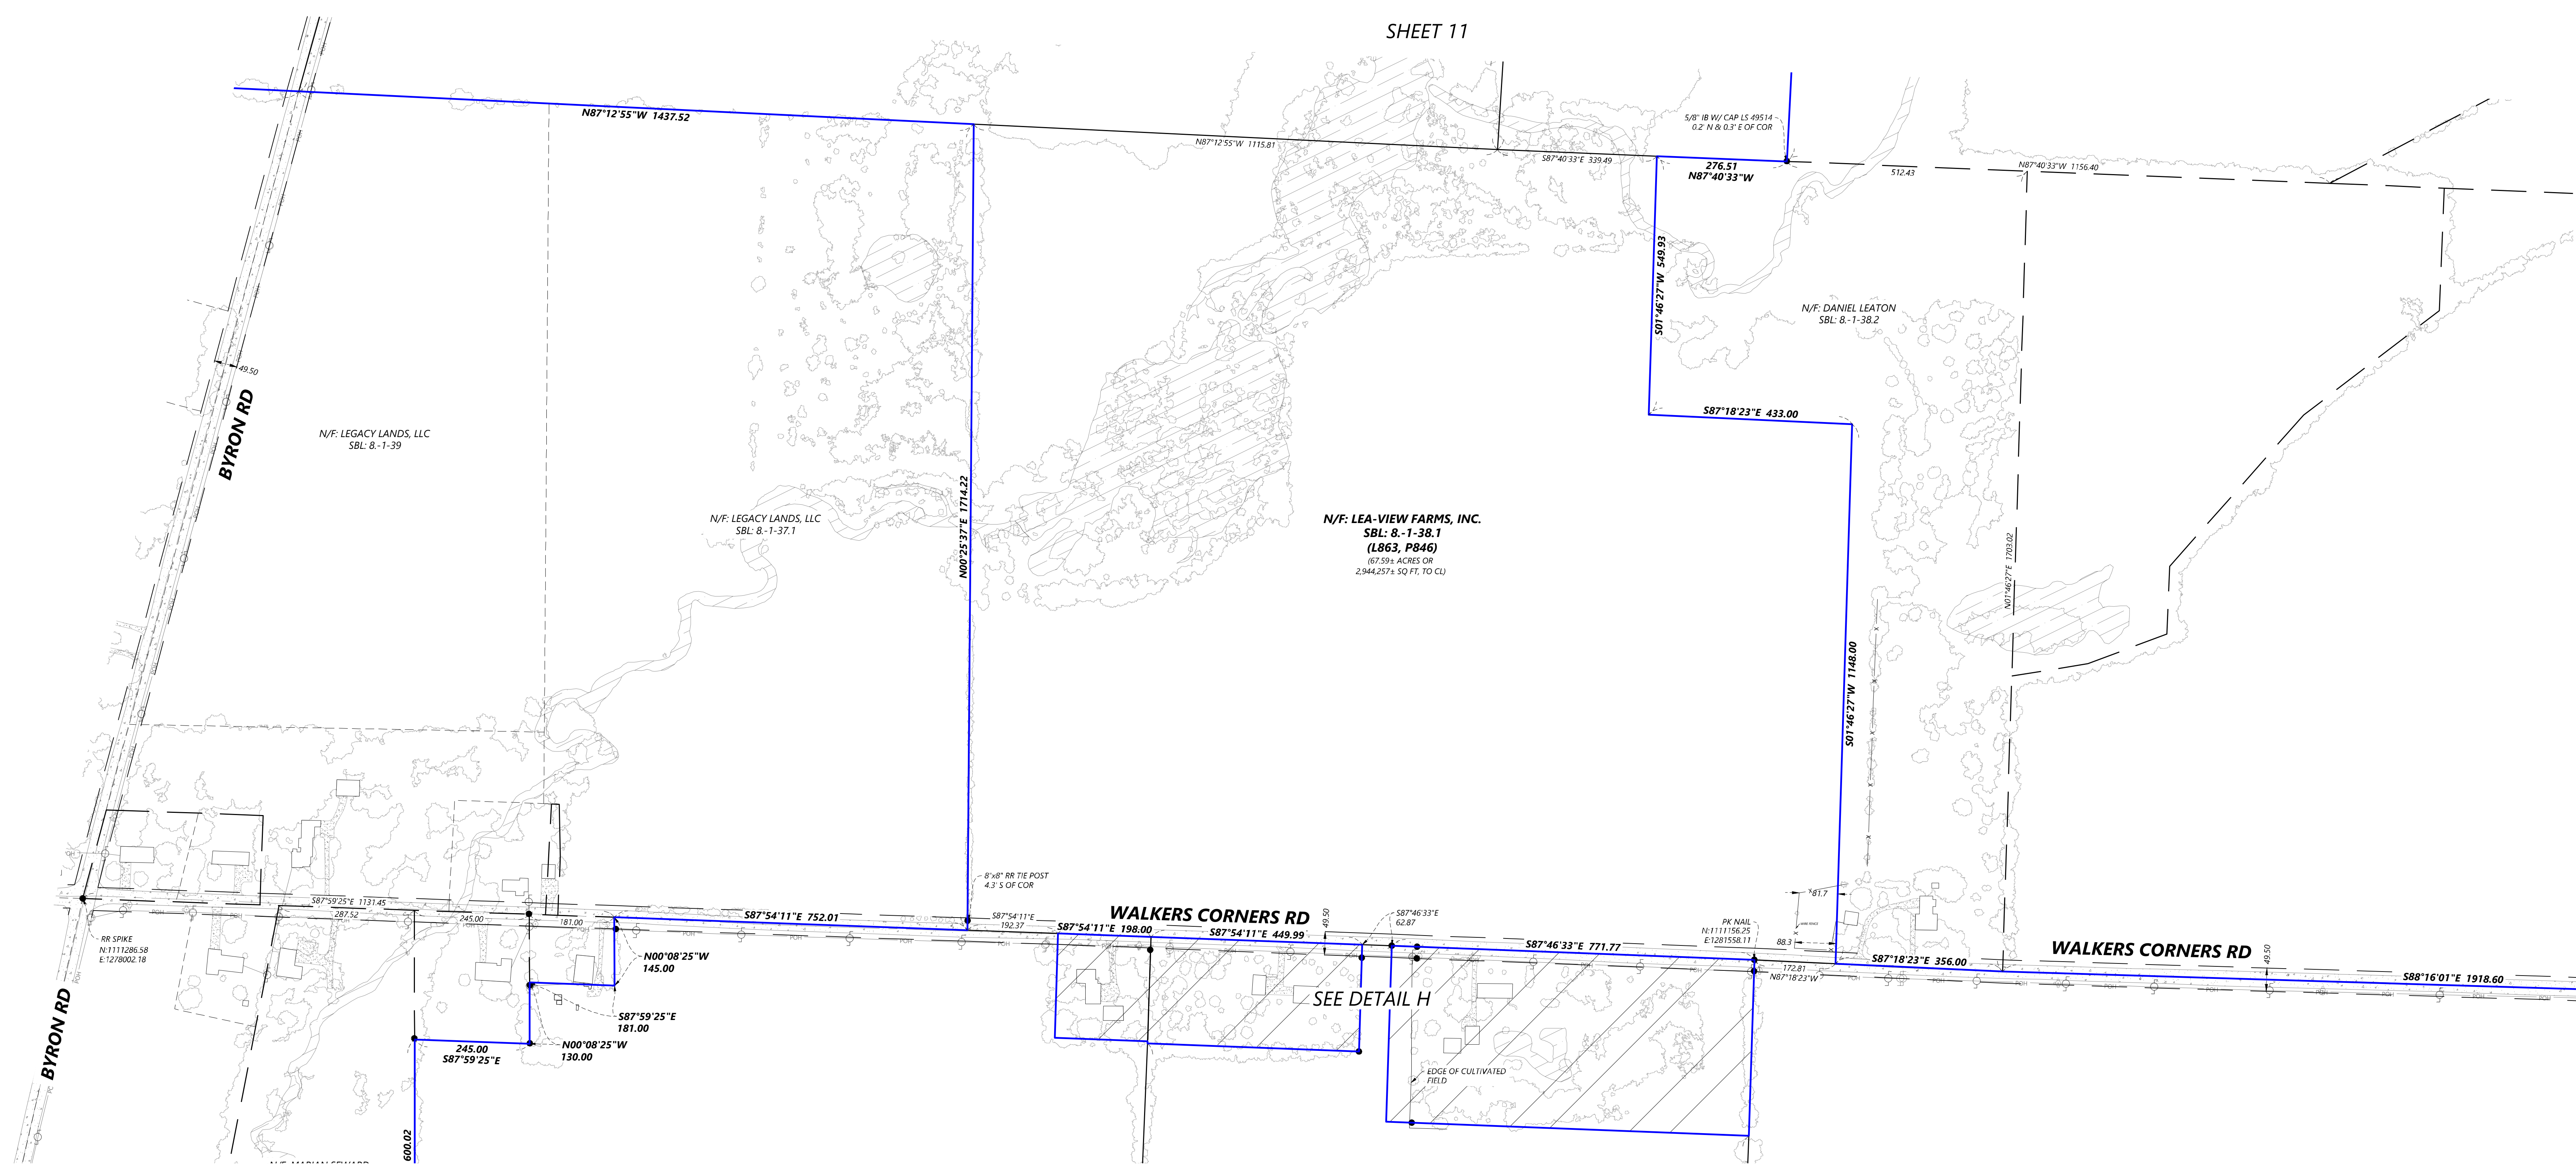


KEYMAP:

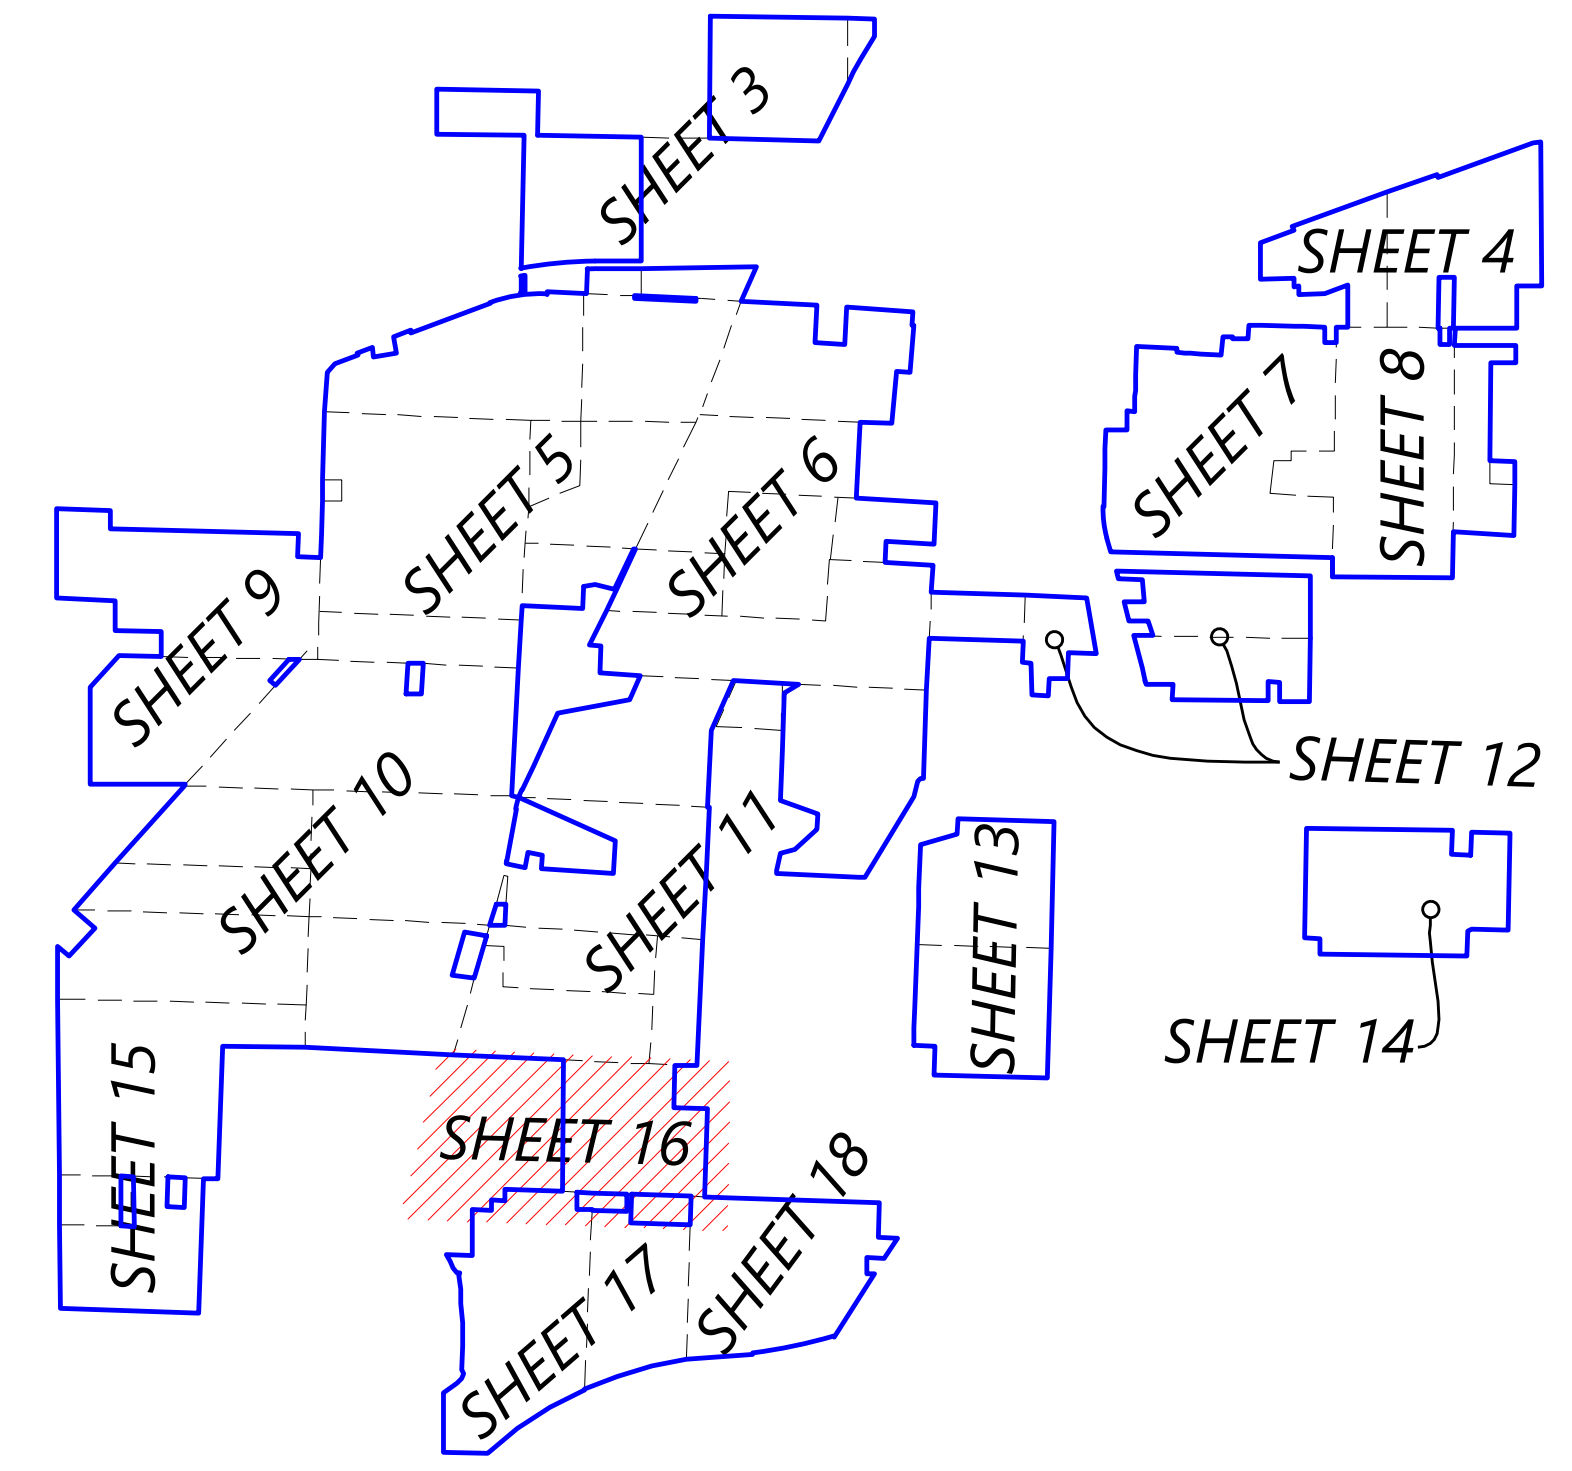




DETAIL H

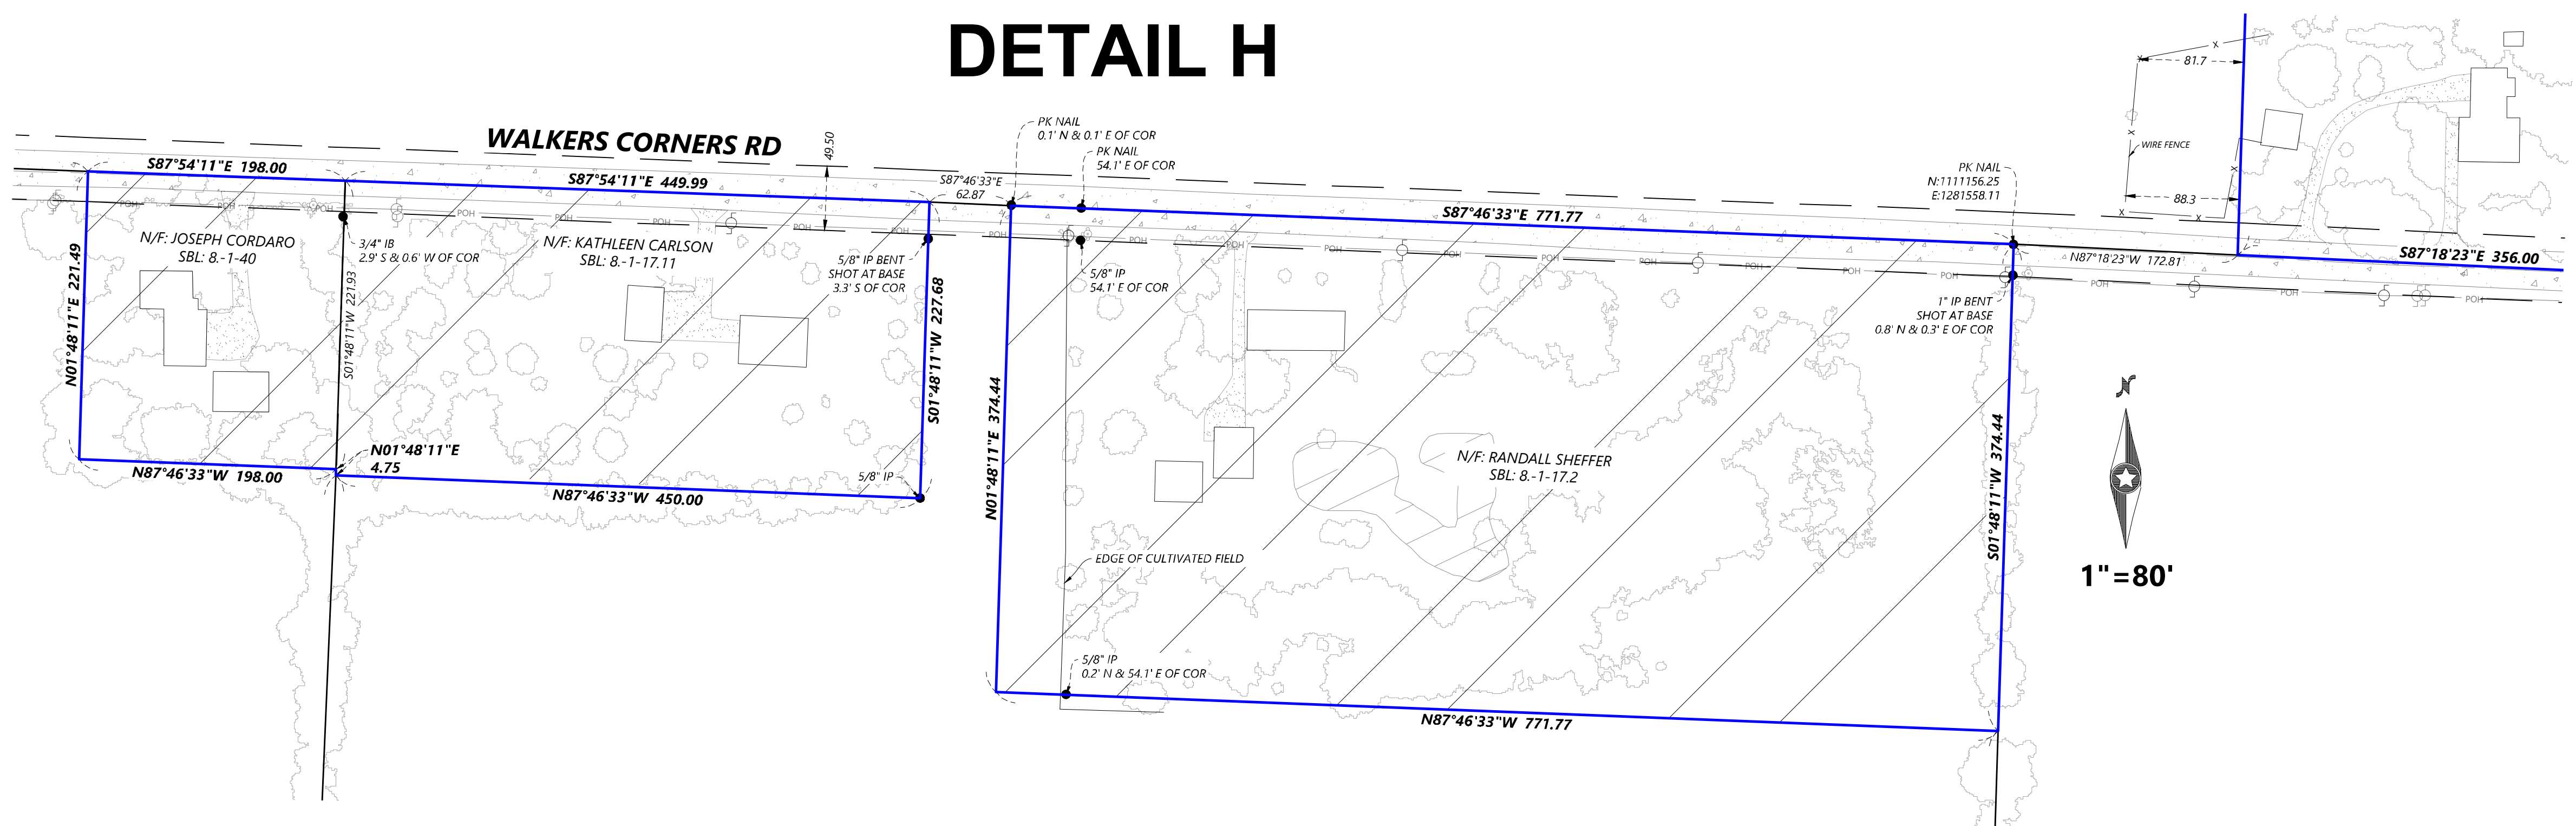

KEYMAP:

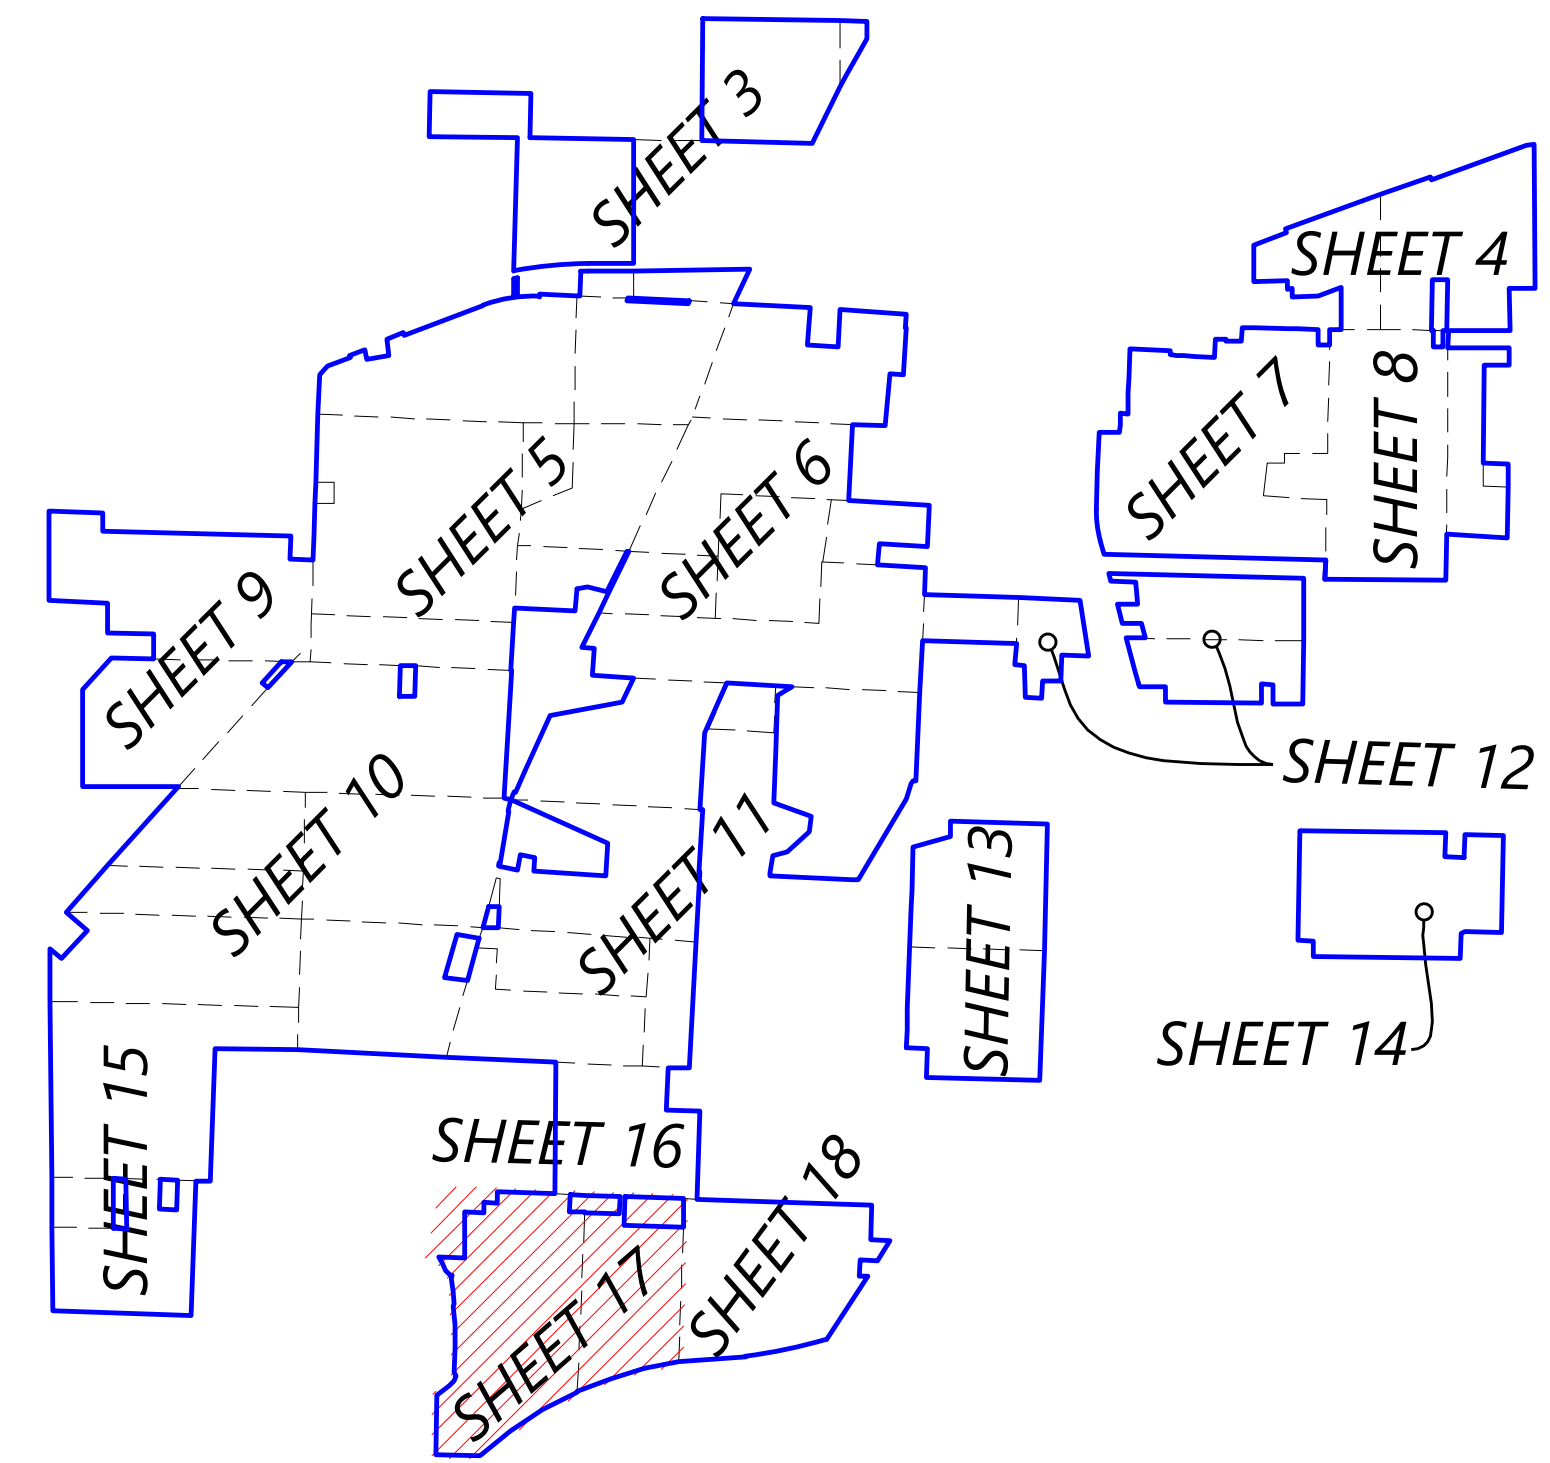

DETAIL I

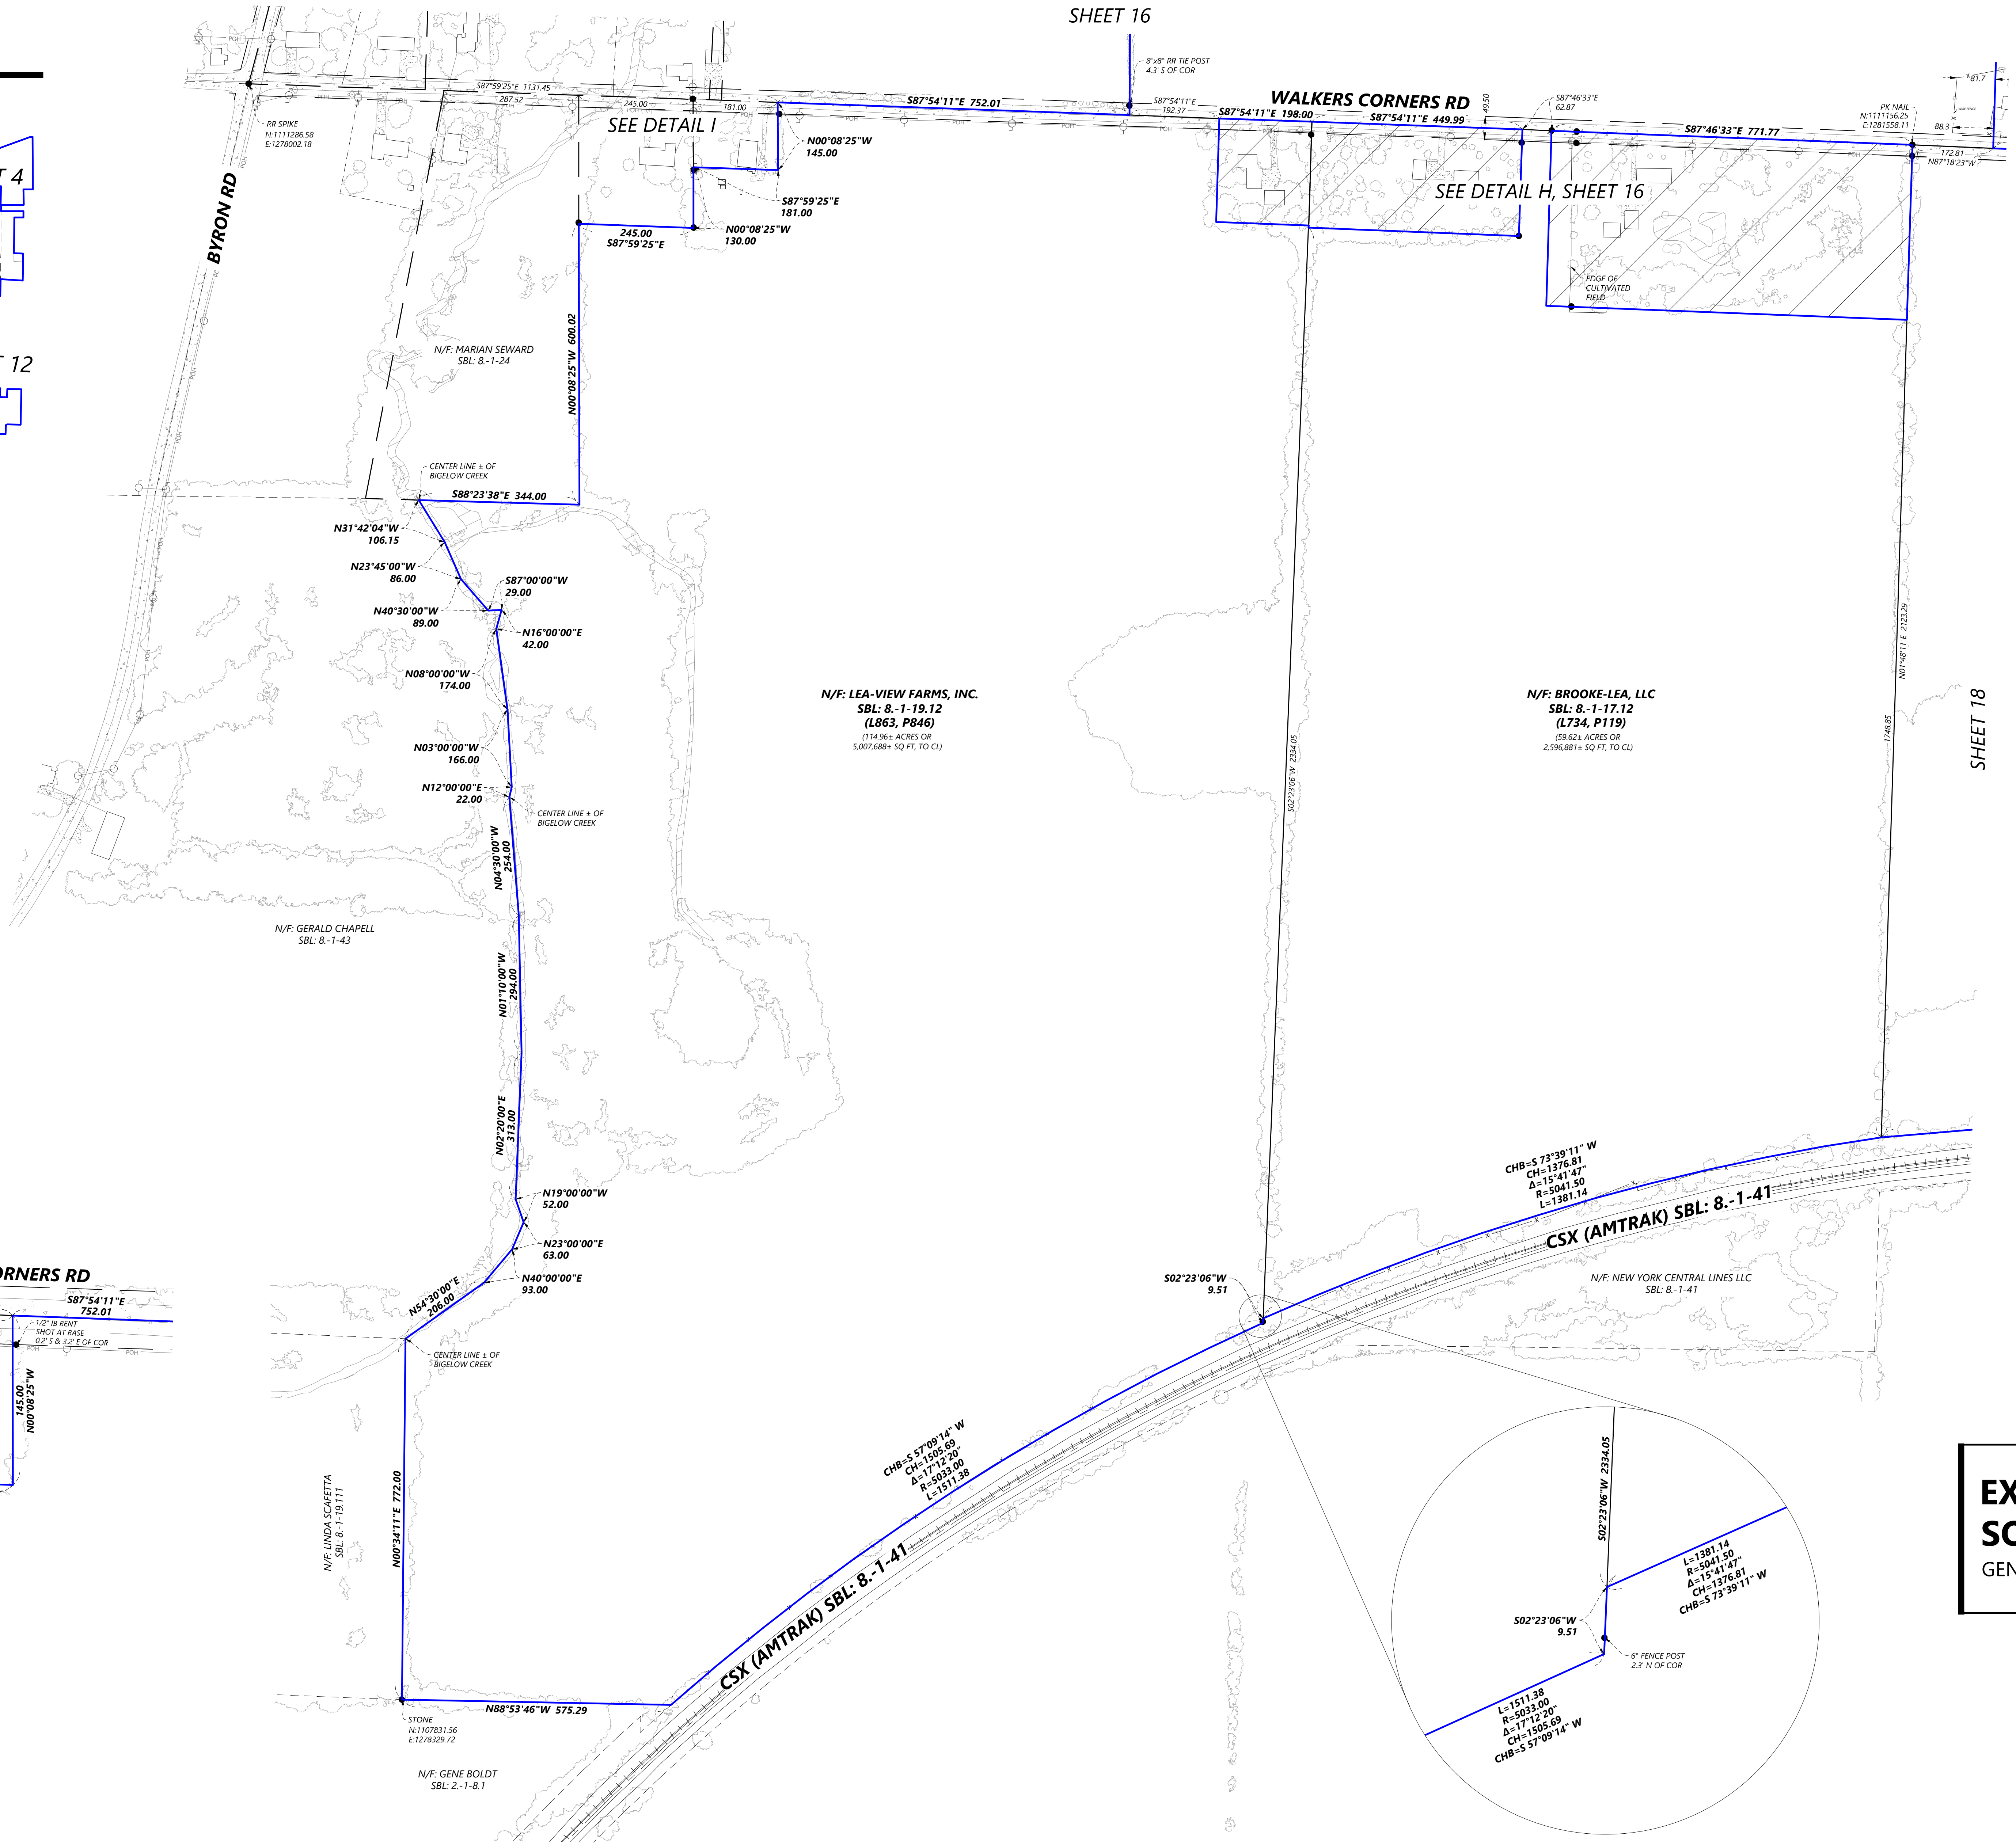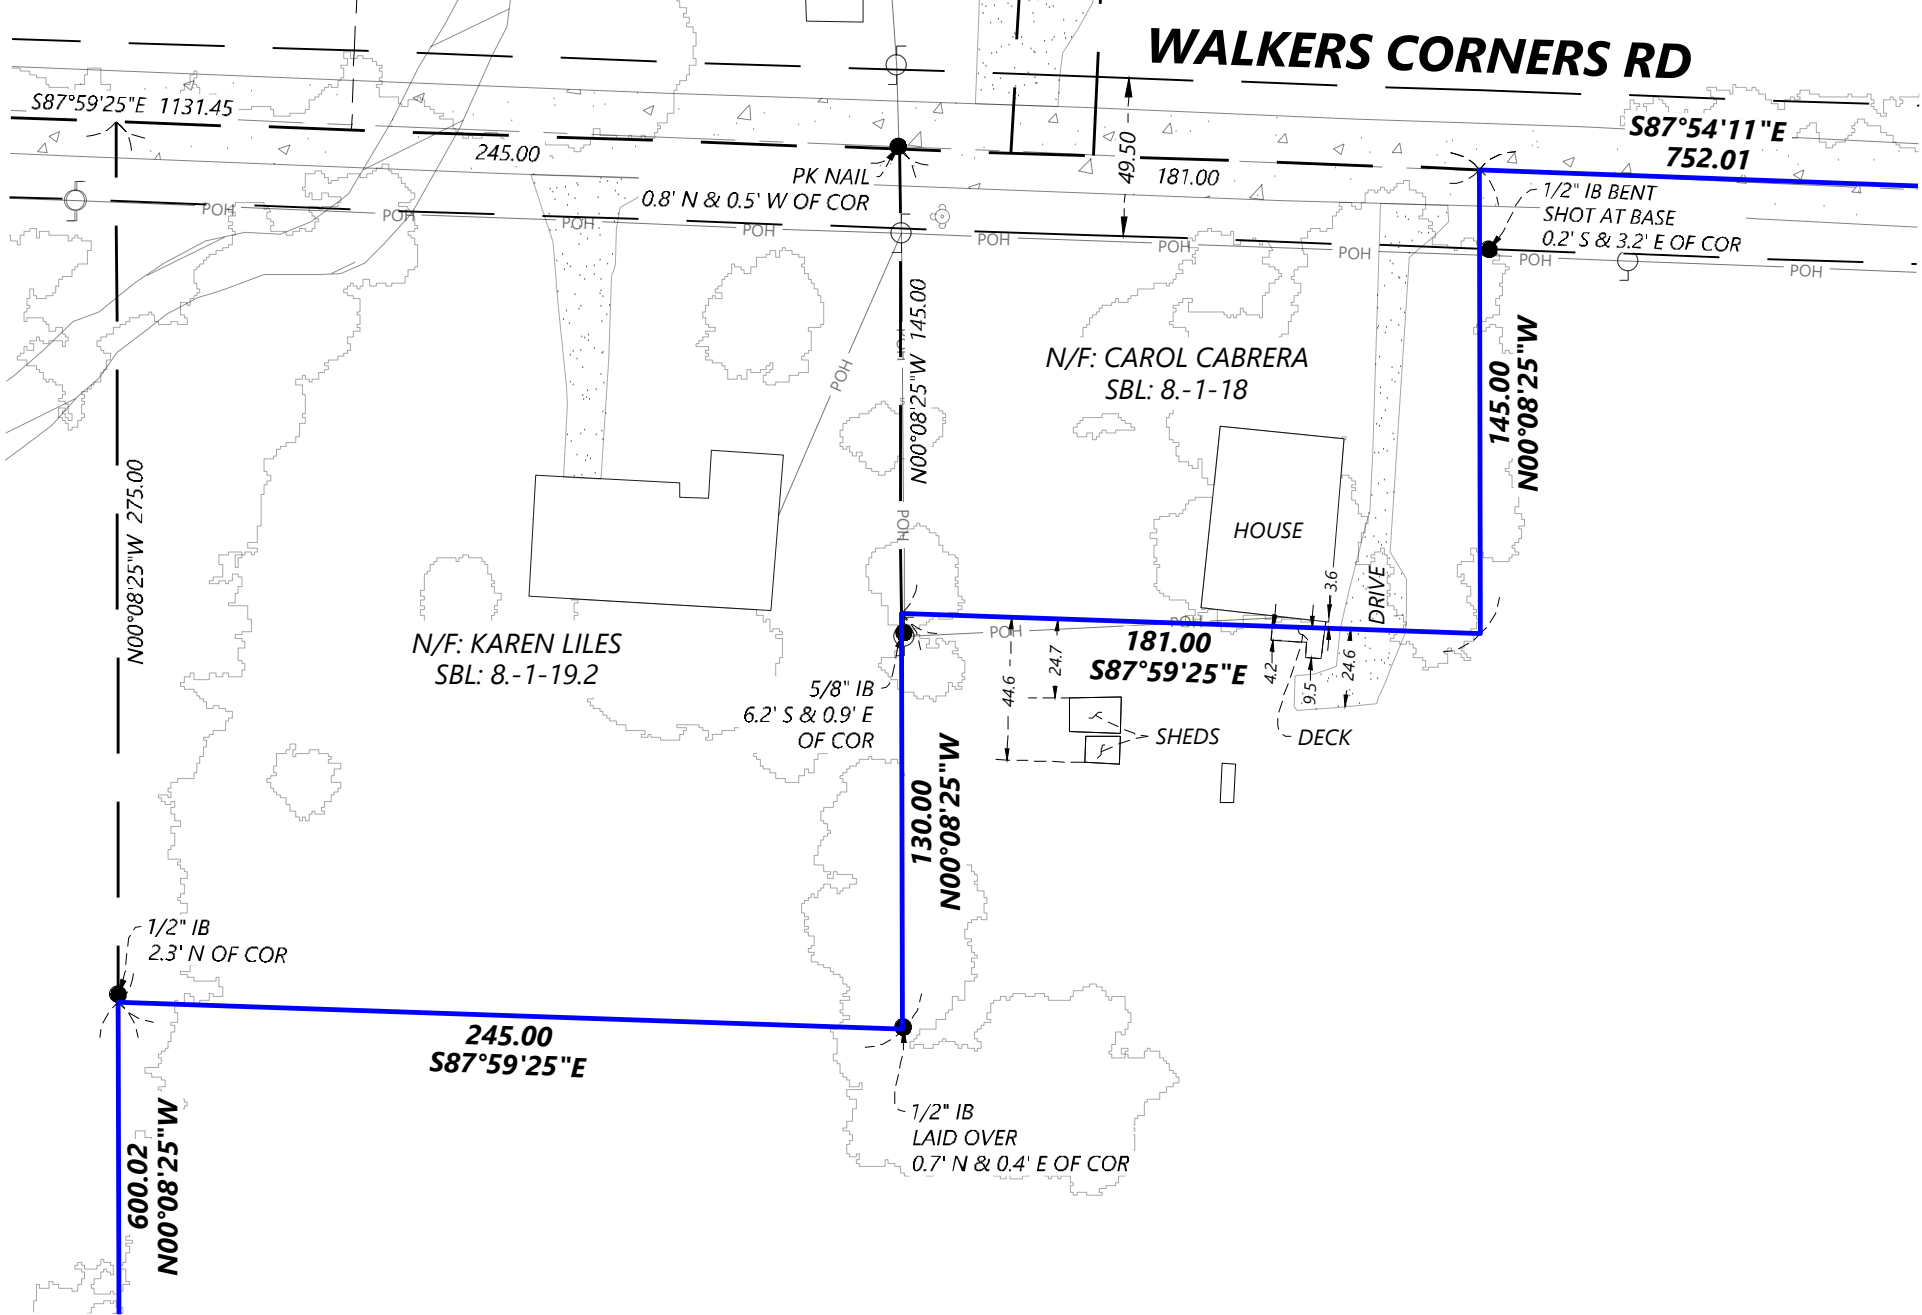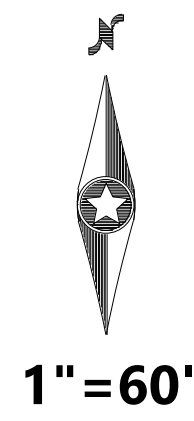

PREPARED FOR:




PO Box 88808
North Palm Beach, FL 33408

REVISIONS:		
#	DATE	COMMENT

LEGEND:

- GUY WIRE
- POWER POLE
- HYDRANT
- SIGN
- WATER EDGE
- POWER OVERHEAD
- FENCE LINE
- BOUNDARY LINE
- PARCEL LINE
- ADJACENT PARCEL LINES
- APPROXIMATE LOCATION OF PARCEL LINES FROM TAX MAP
- EASEMENT LINES
- EXCEPTION TO PROJECT
- DRIVE
- ROAD
- WATER
- VEGETATION
- FOUND MONUMENT (SEE LABEL)
- N/F NOW OR FORMERLY
- COR CORNER
- IP IRON PIPE
- IB IRON BAR
- RB REBAR

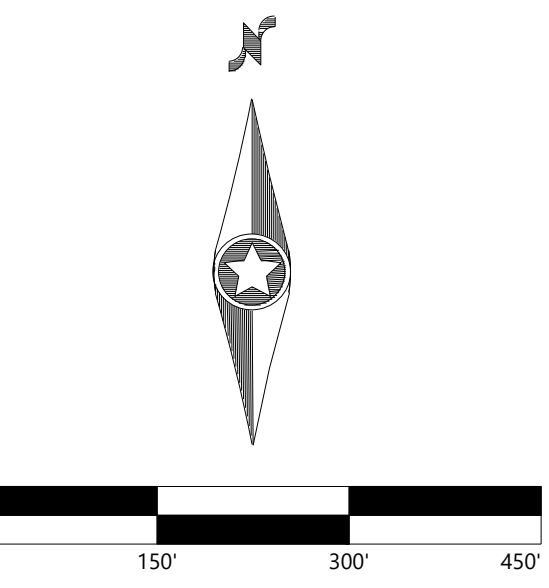

BEARING AND DISTANCES SHOWN HEREON ARE BASED ON NEW STATE PLANE COORDINATE SYSTEM, NAD1983(2011), NEW YORK WEST ZONE, US SURVEY FOOT. DISTANCES AND AREAS HAVE BEEN SCALED TO GROUND VALUES BY APPLYING A SCALE FACTOR OF 1.0000416. BEARINGS SHOWN HEREON ARE GRID NORTH.

EXCELSIOR
SOLAR PROJECT
GENESEE COUNTY, NEW YORK

RECORD OF SURVEY

DATE: 11/03/2020

SHEET: 17 of 18

PREPARED FOR:




PO Box 88808
North Palm Beach, FL 33408

REVISIONS:		
#	DATE	COMMENT

LEGEND:

- GUY WIRE
- POWER POLE
- HYDRANT
- SIGN
- WATER EDGE
- POWER OVERHEAD
- FENCE LINE
- BOUNDARY LINE
- PARCEL LINE
- ADJACENT PARCEL LINES
- APPROXIMATE LOCATION OF PARCEL LINES FROM TAX MAP
- EASEMENT LINES
- EXCEPTION TO PROJECT
- DRIVE
- ROAD
- WATER
- VEGETATION
- FOUND MONUMENT (SEE LABEL)
- N/F NOW OR FORMERLY
- COR CORNER
- IP IRON PIPE
- IB IRON BAR
- RB REBAR

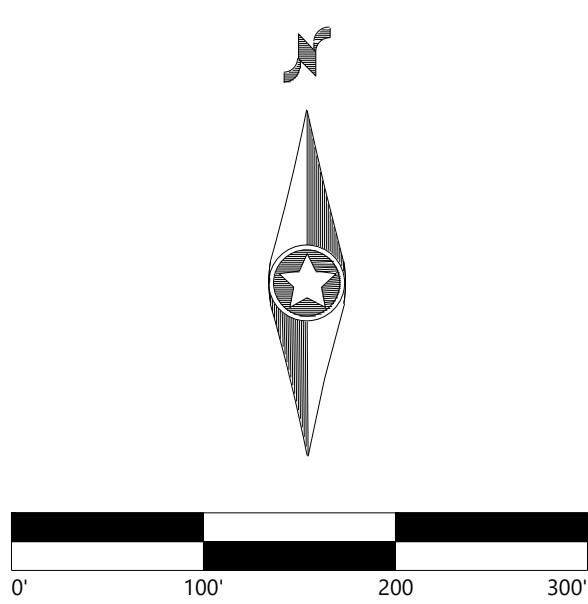


BEARING AND DISTANCES SHOWN HEREON ARE BASED ON NEW STATE PLANE COORDINATE SYSTEM, NAD1983(2011), NEW YORK WEST ZONE, US SURVEY FOOT. DISTANCES AND AREAS HAVE BEEN SCALED TO GROUND VALUES BY APPLYING A SCALE FACTOR OF 1.0000416. BEARINGS SHOWN HEREON ARE GRID NORTH.

EXCELSIOR
SOLAR PROJECT
GENESSEE COUNTY, NEW YORK


RECORD OF SURVEY

DATE: 11/03/2020

SHEET: 18 of 18

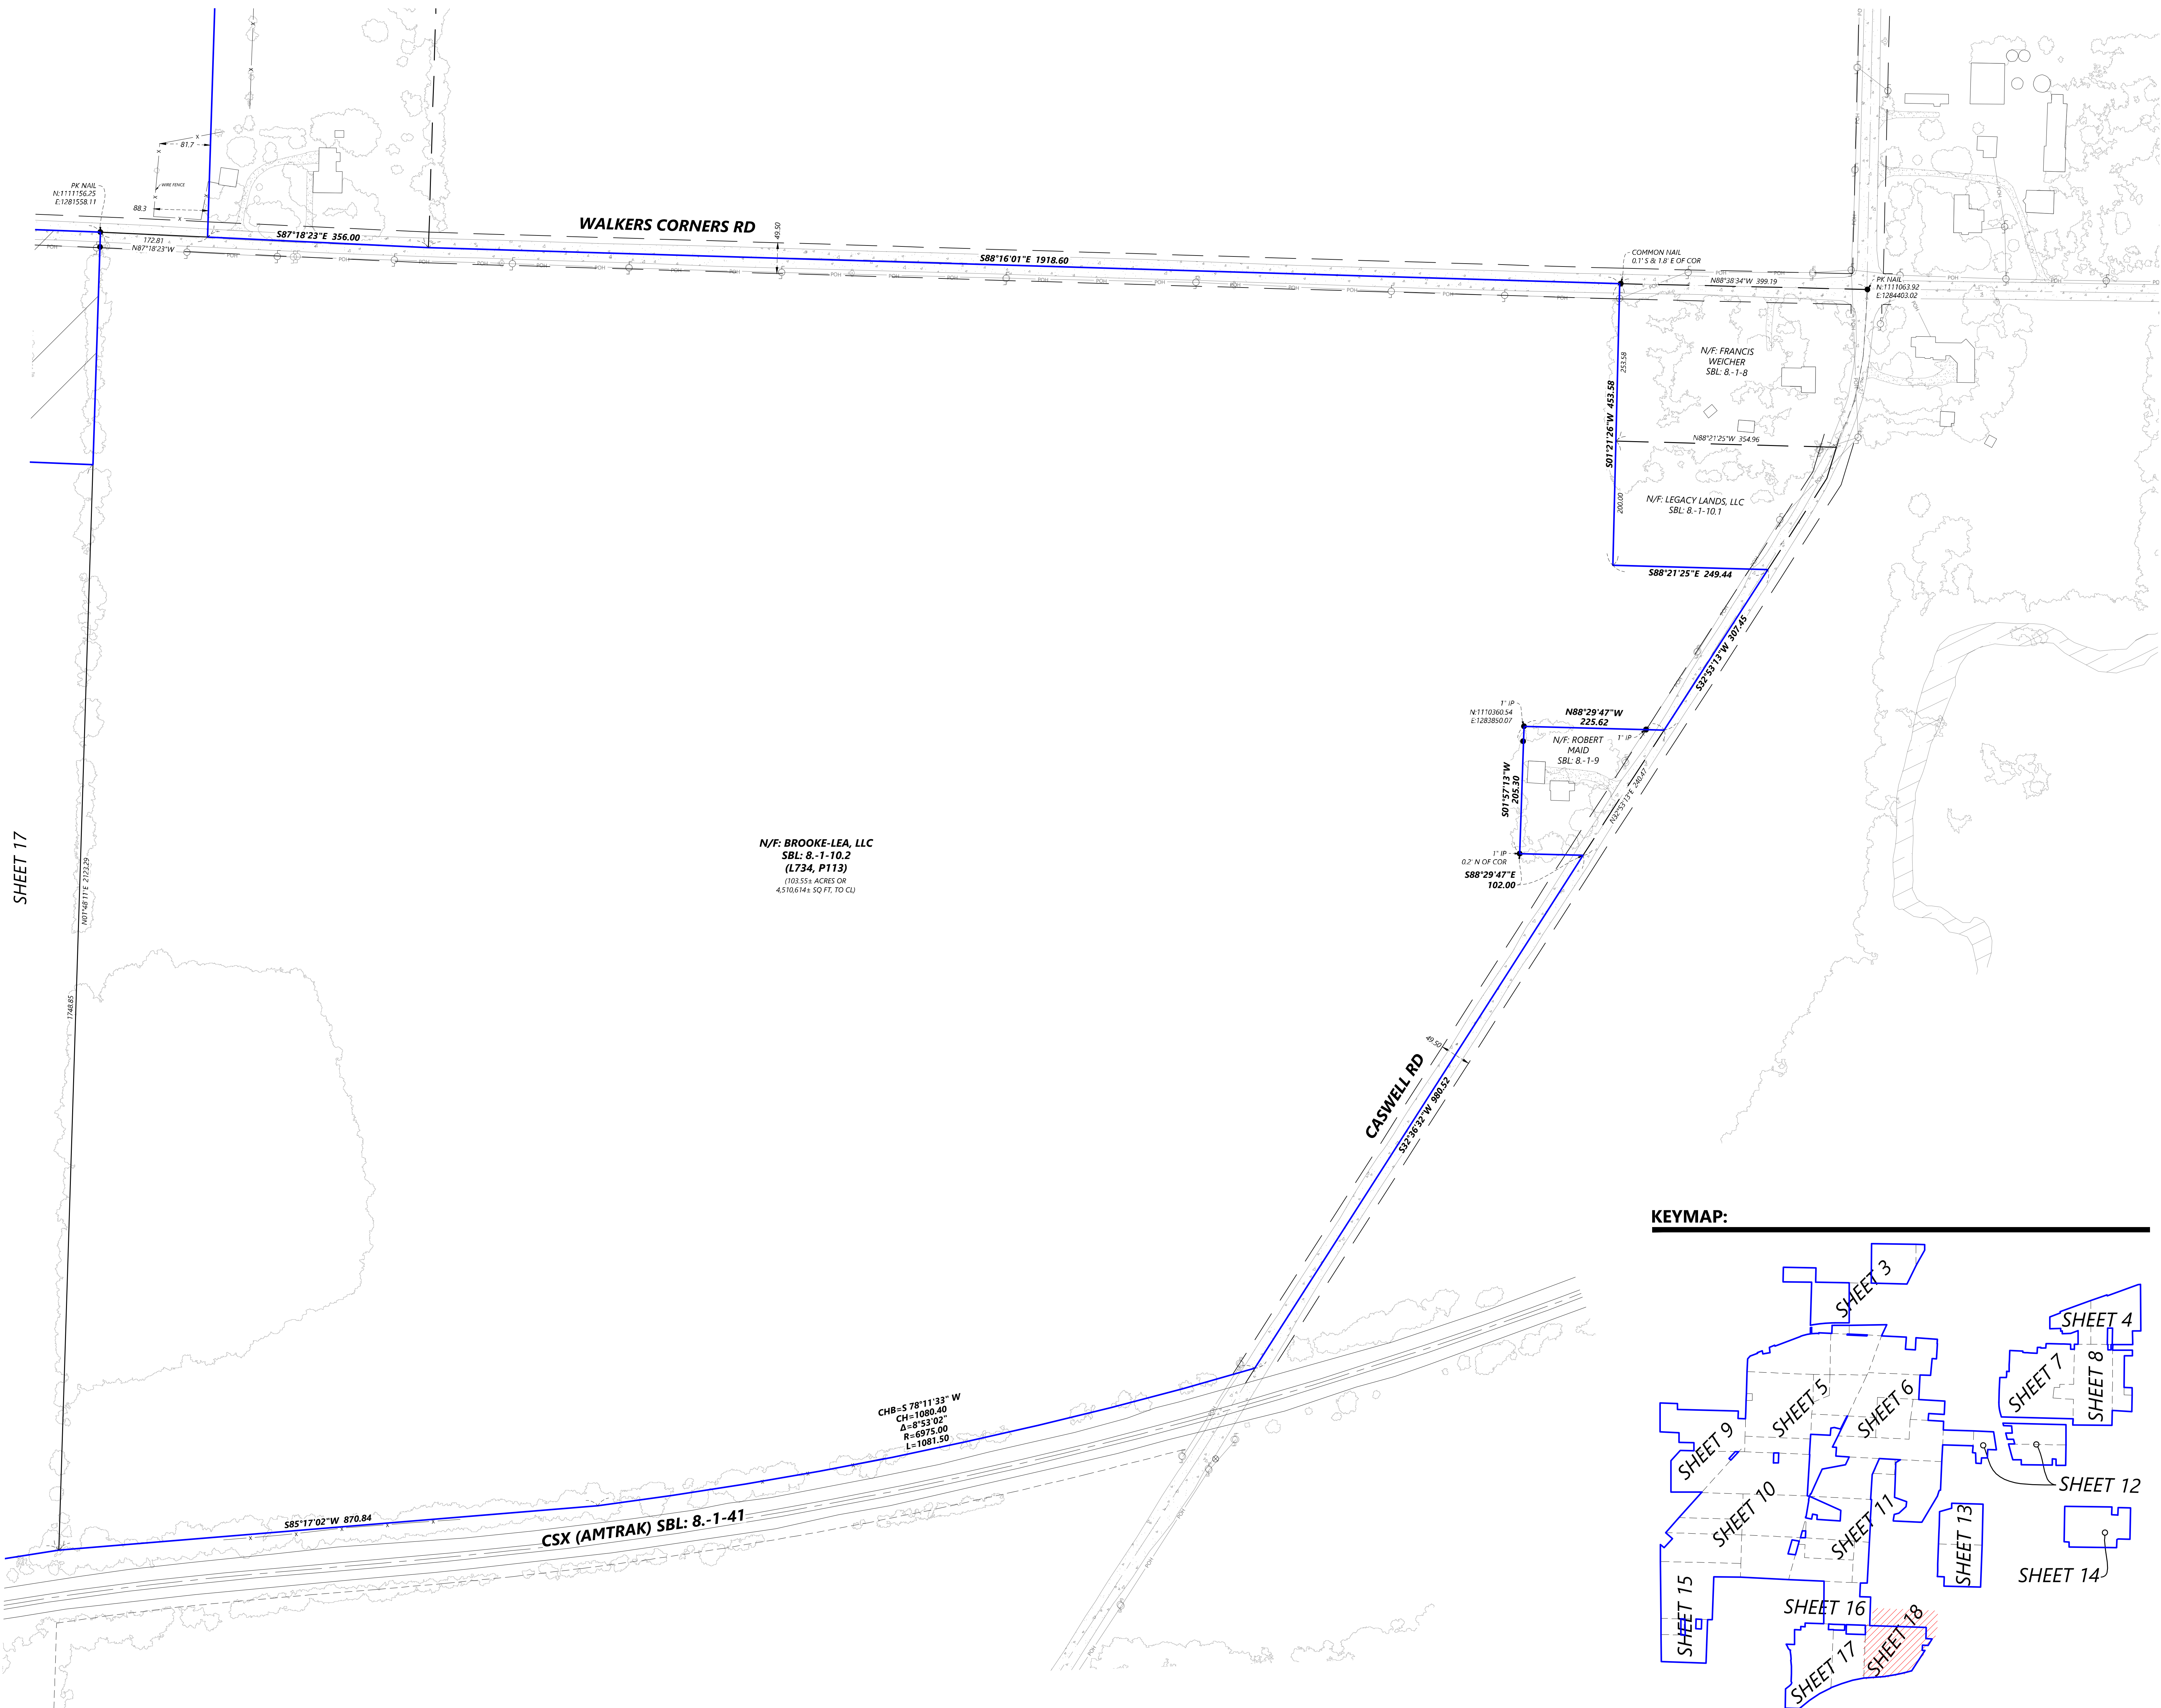

KEYMAP:

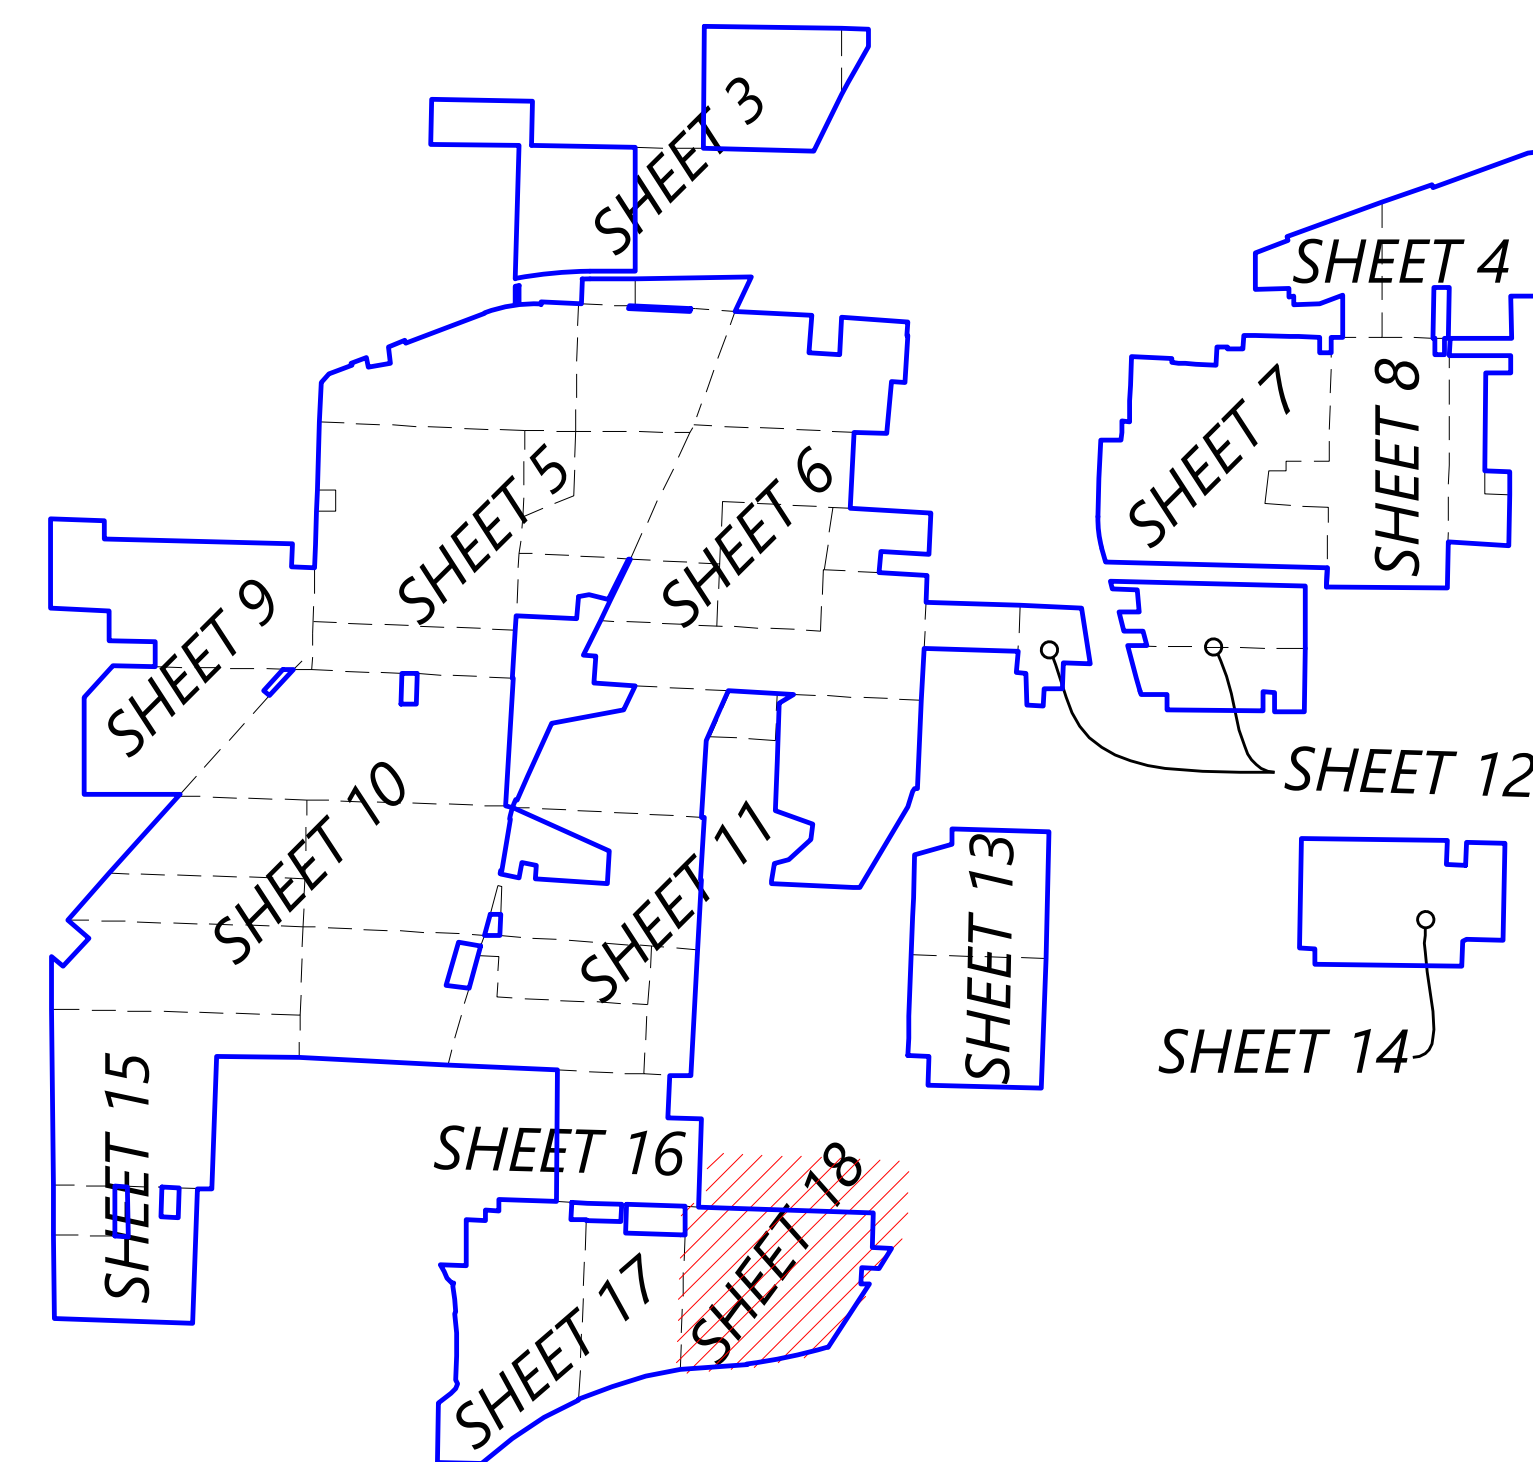

SHEET 17

N/F: BROOKE-LEA, LLC
SBL: 8.-1-10.2
(L734, P113)
(103.55+ ACRES OR
4,570,614+ SQ FT, TO CL)

CHB=5 78°11'33\"/>

S85°17'02\"/>

CSX (AMTRAK) SBL: 8.-1-41

CASWELL RD

WALKERS CORNERS RD

N/F: FRANCIS
WEICHER
SBL: 8.-1-8

N/F: LEGACY LANDS, LLC
SBL: 8.-1-10.1

N/F: ROBERT
MAID
SBL: 8.-1-9